


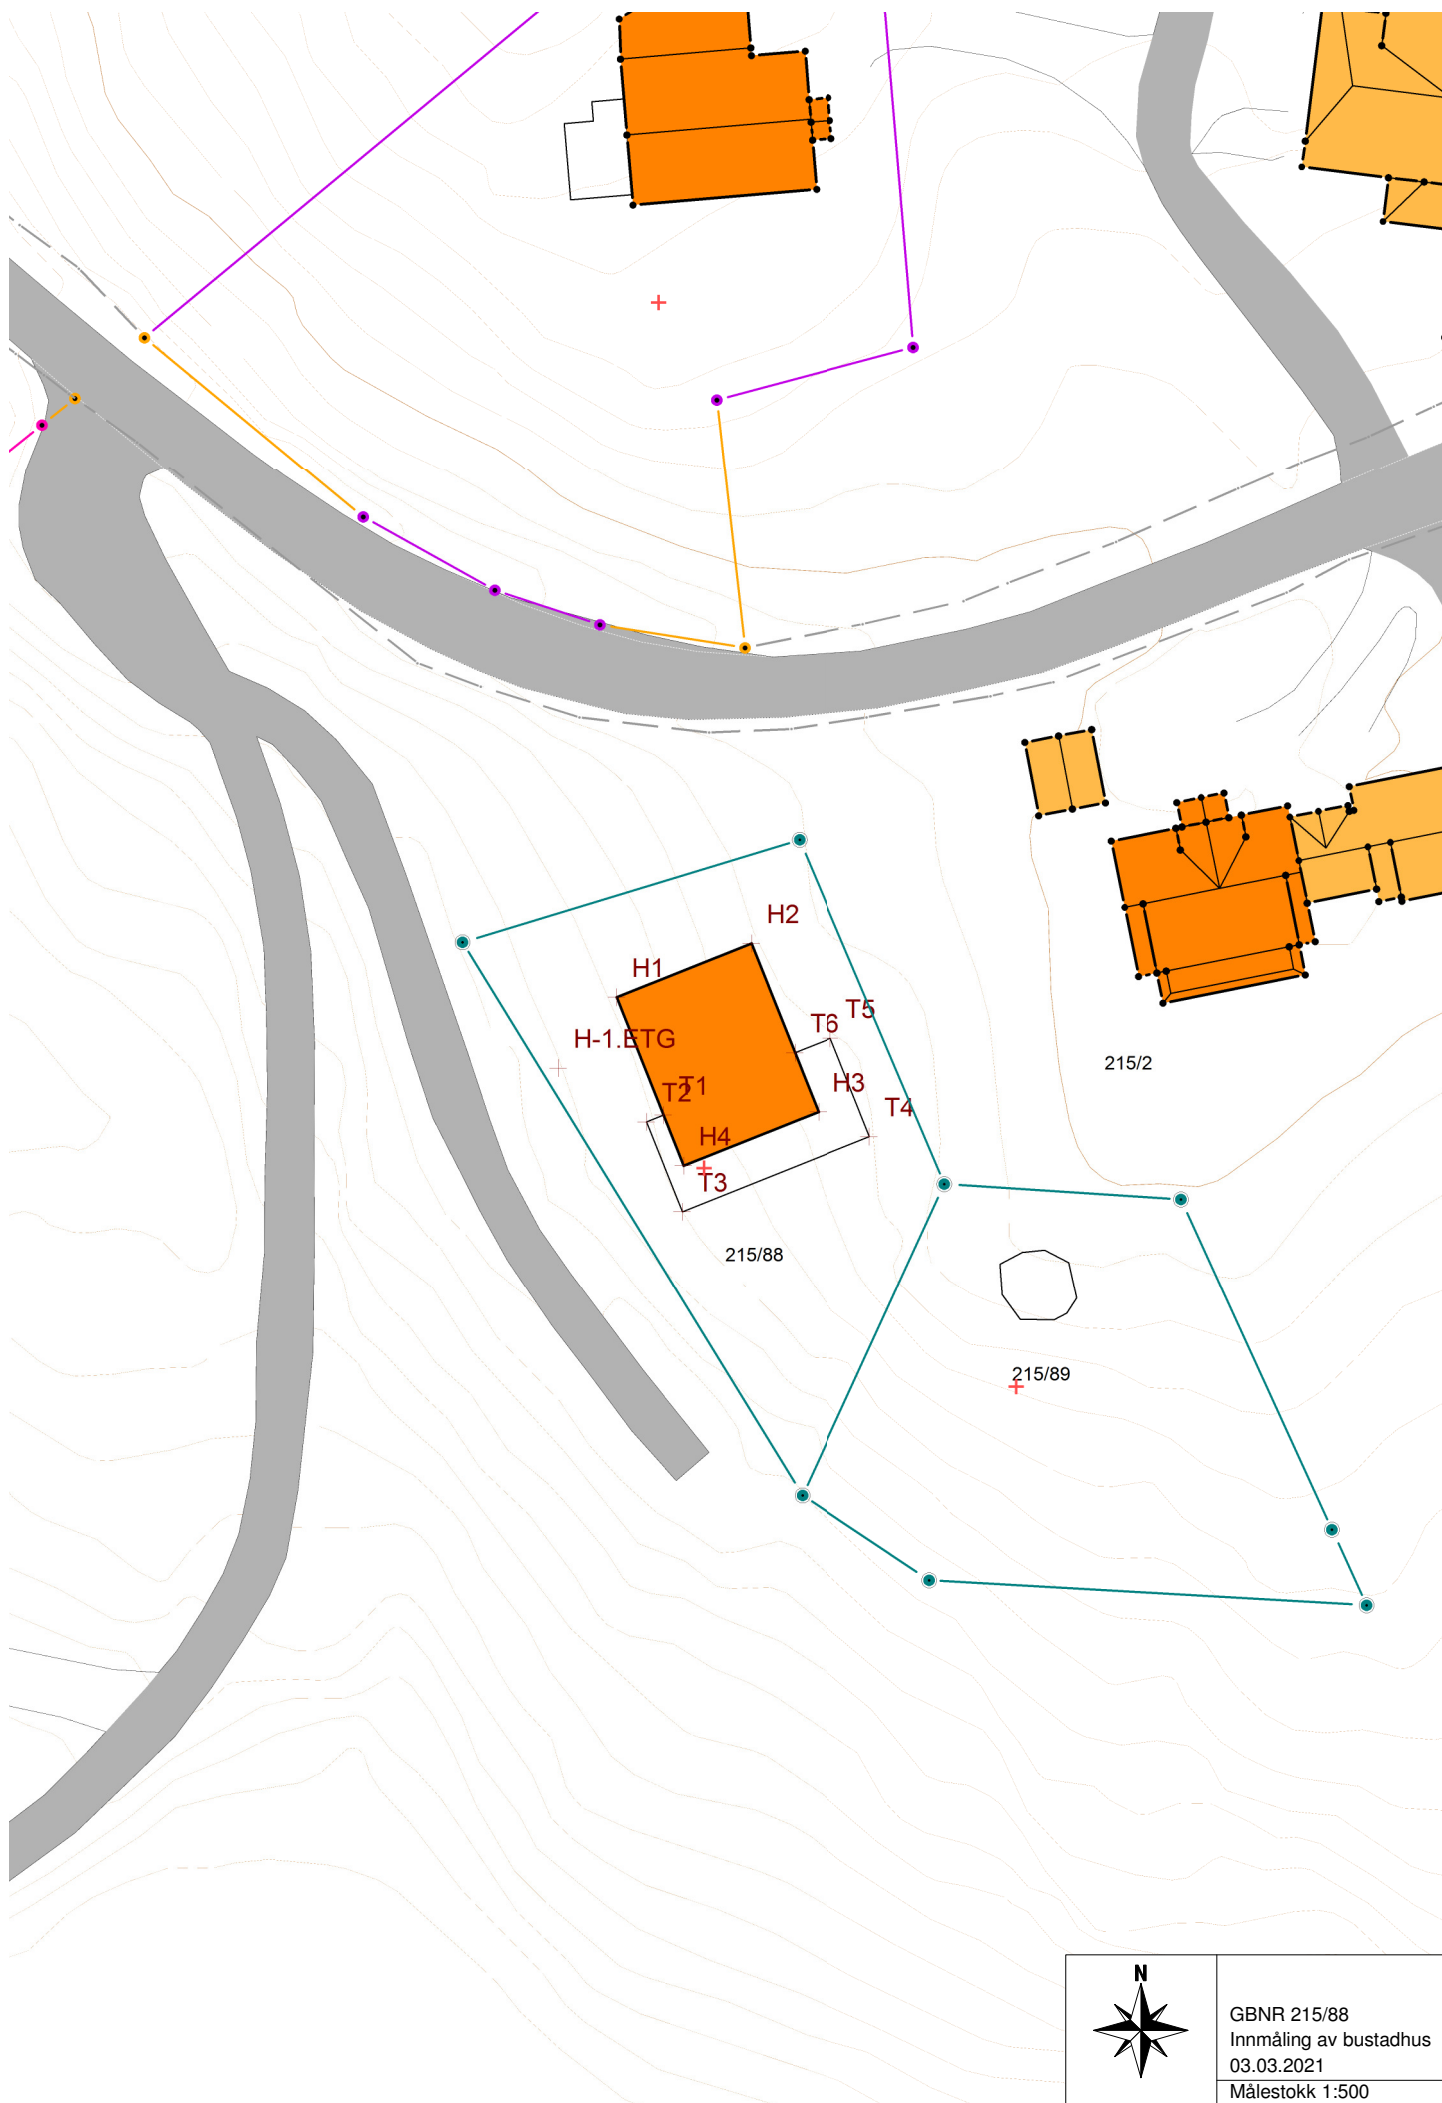

GBNR 215/88
Innmåling av bustadhus
03.03.2021
Målestokk 1:500