


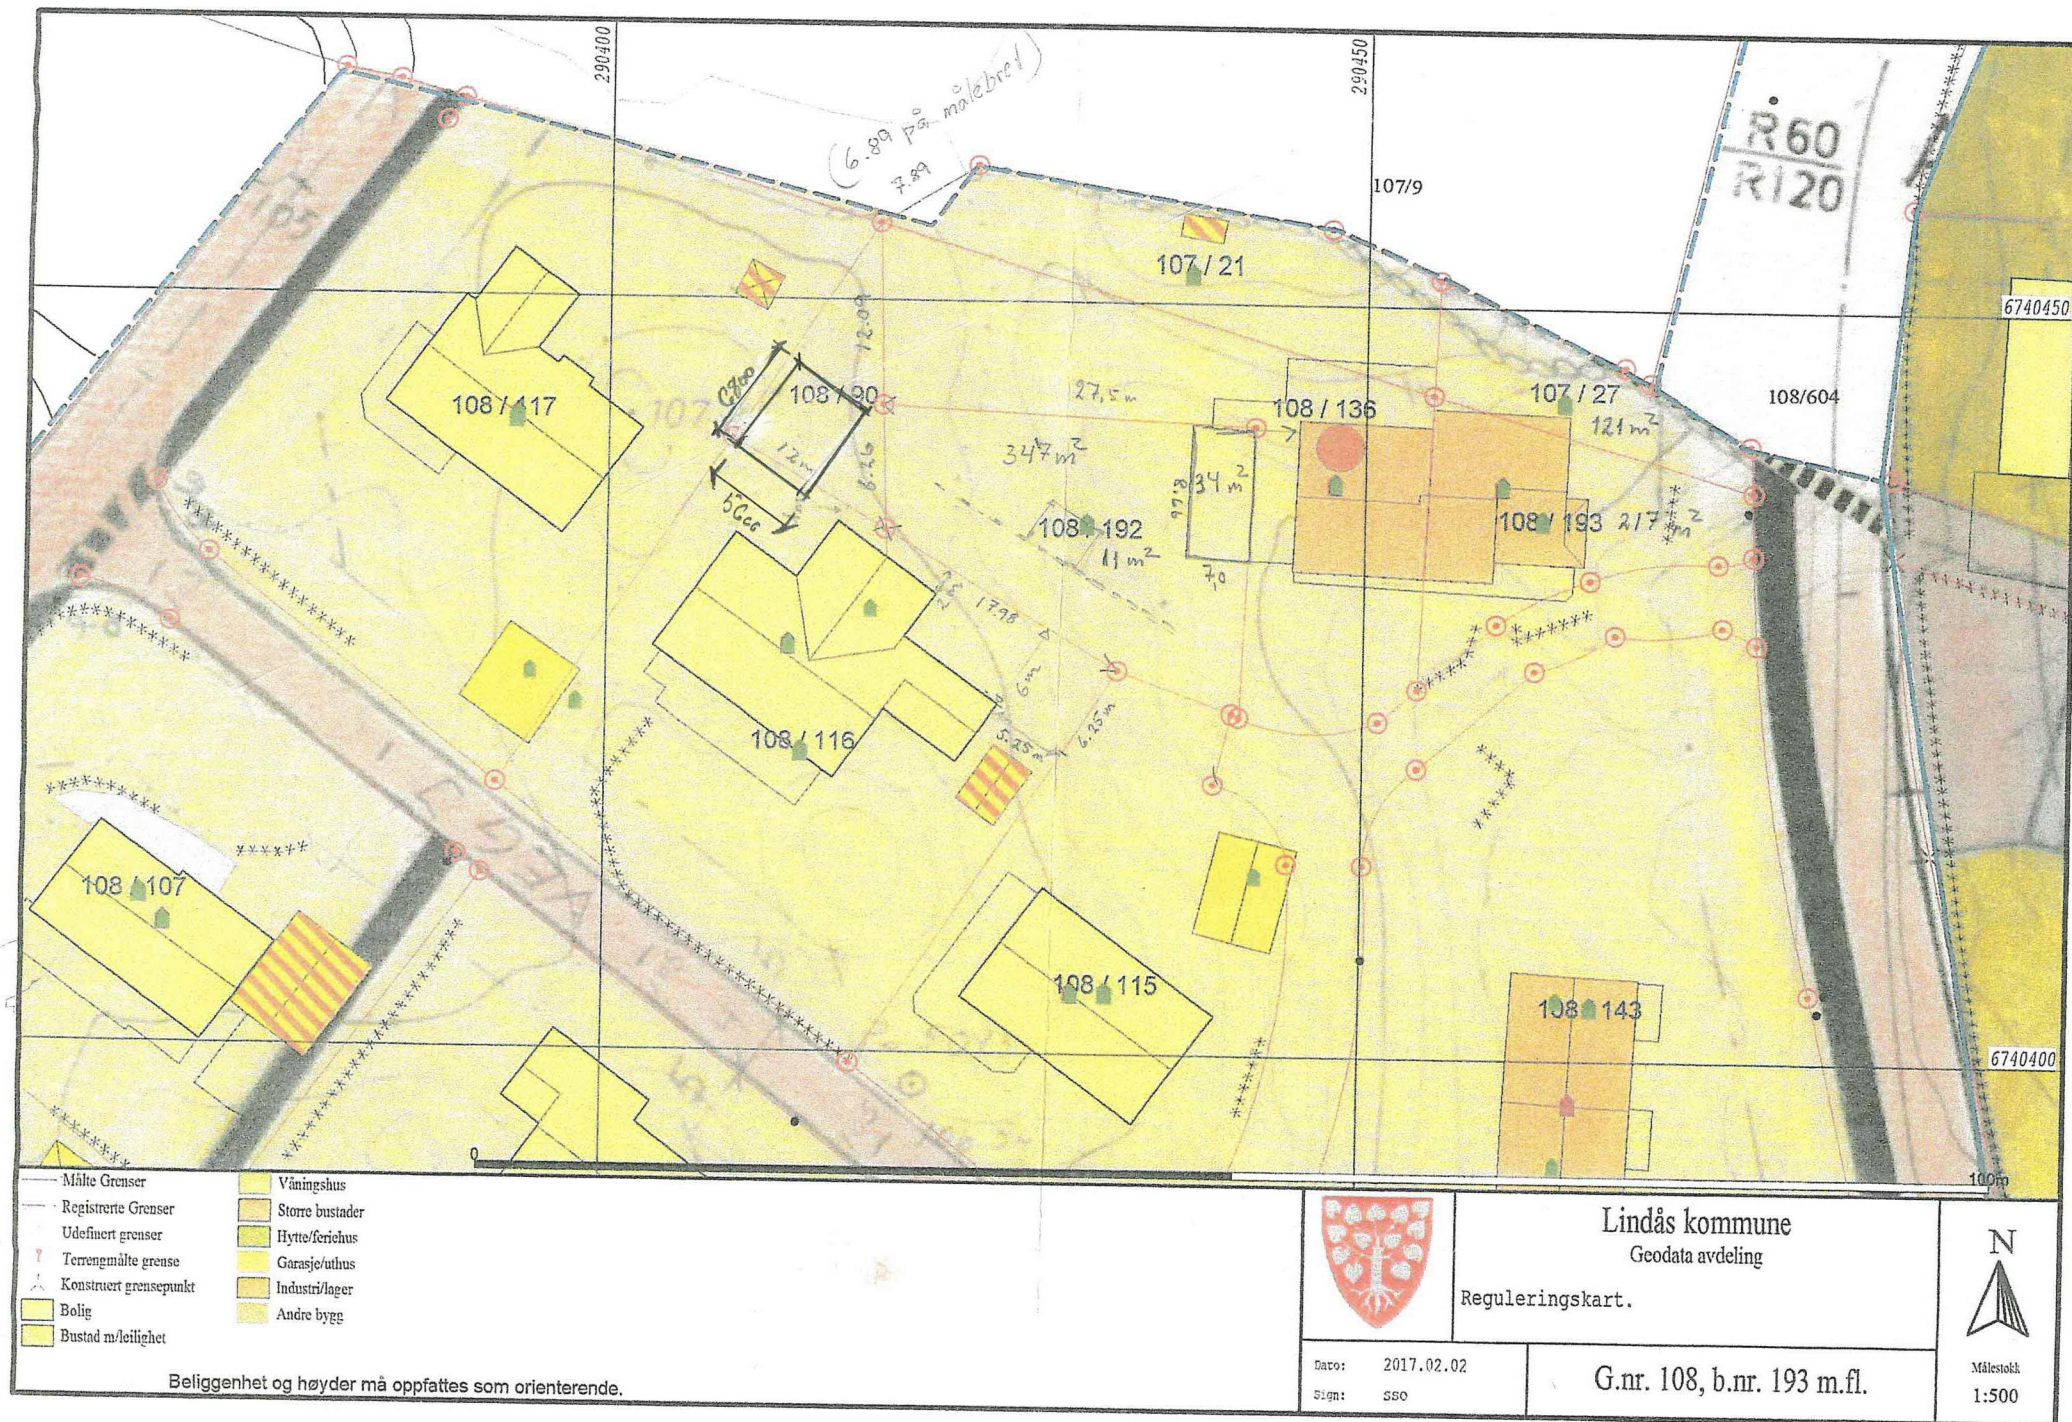

Lindås kommune
Geodata avdeling

Reguleringskart.

Dato: 2017.02.02
Sign: SSO

G.nr. 108, b.nr. 193 m.fl.