


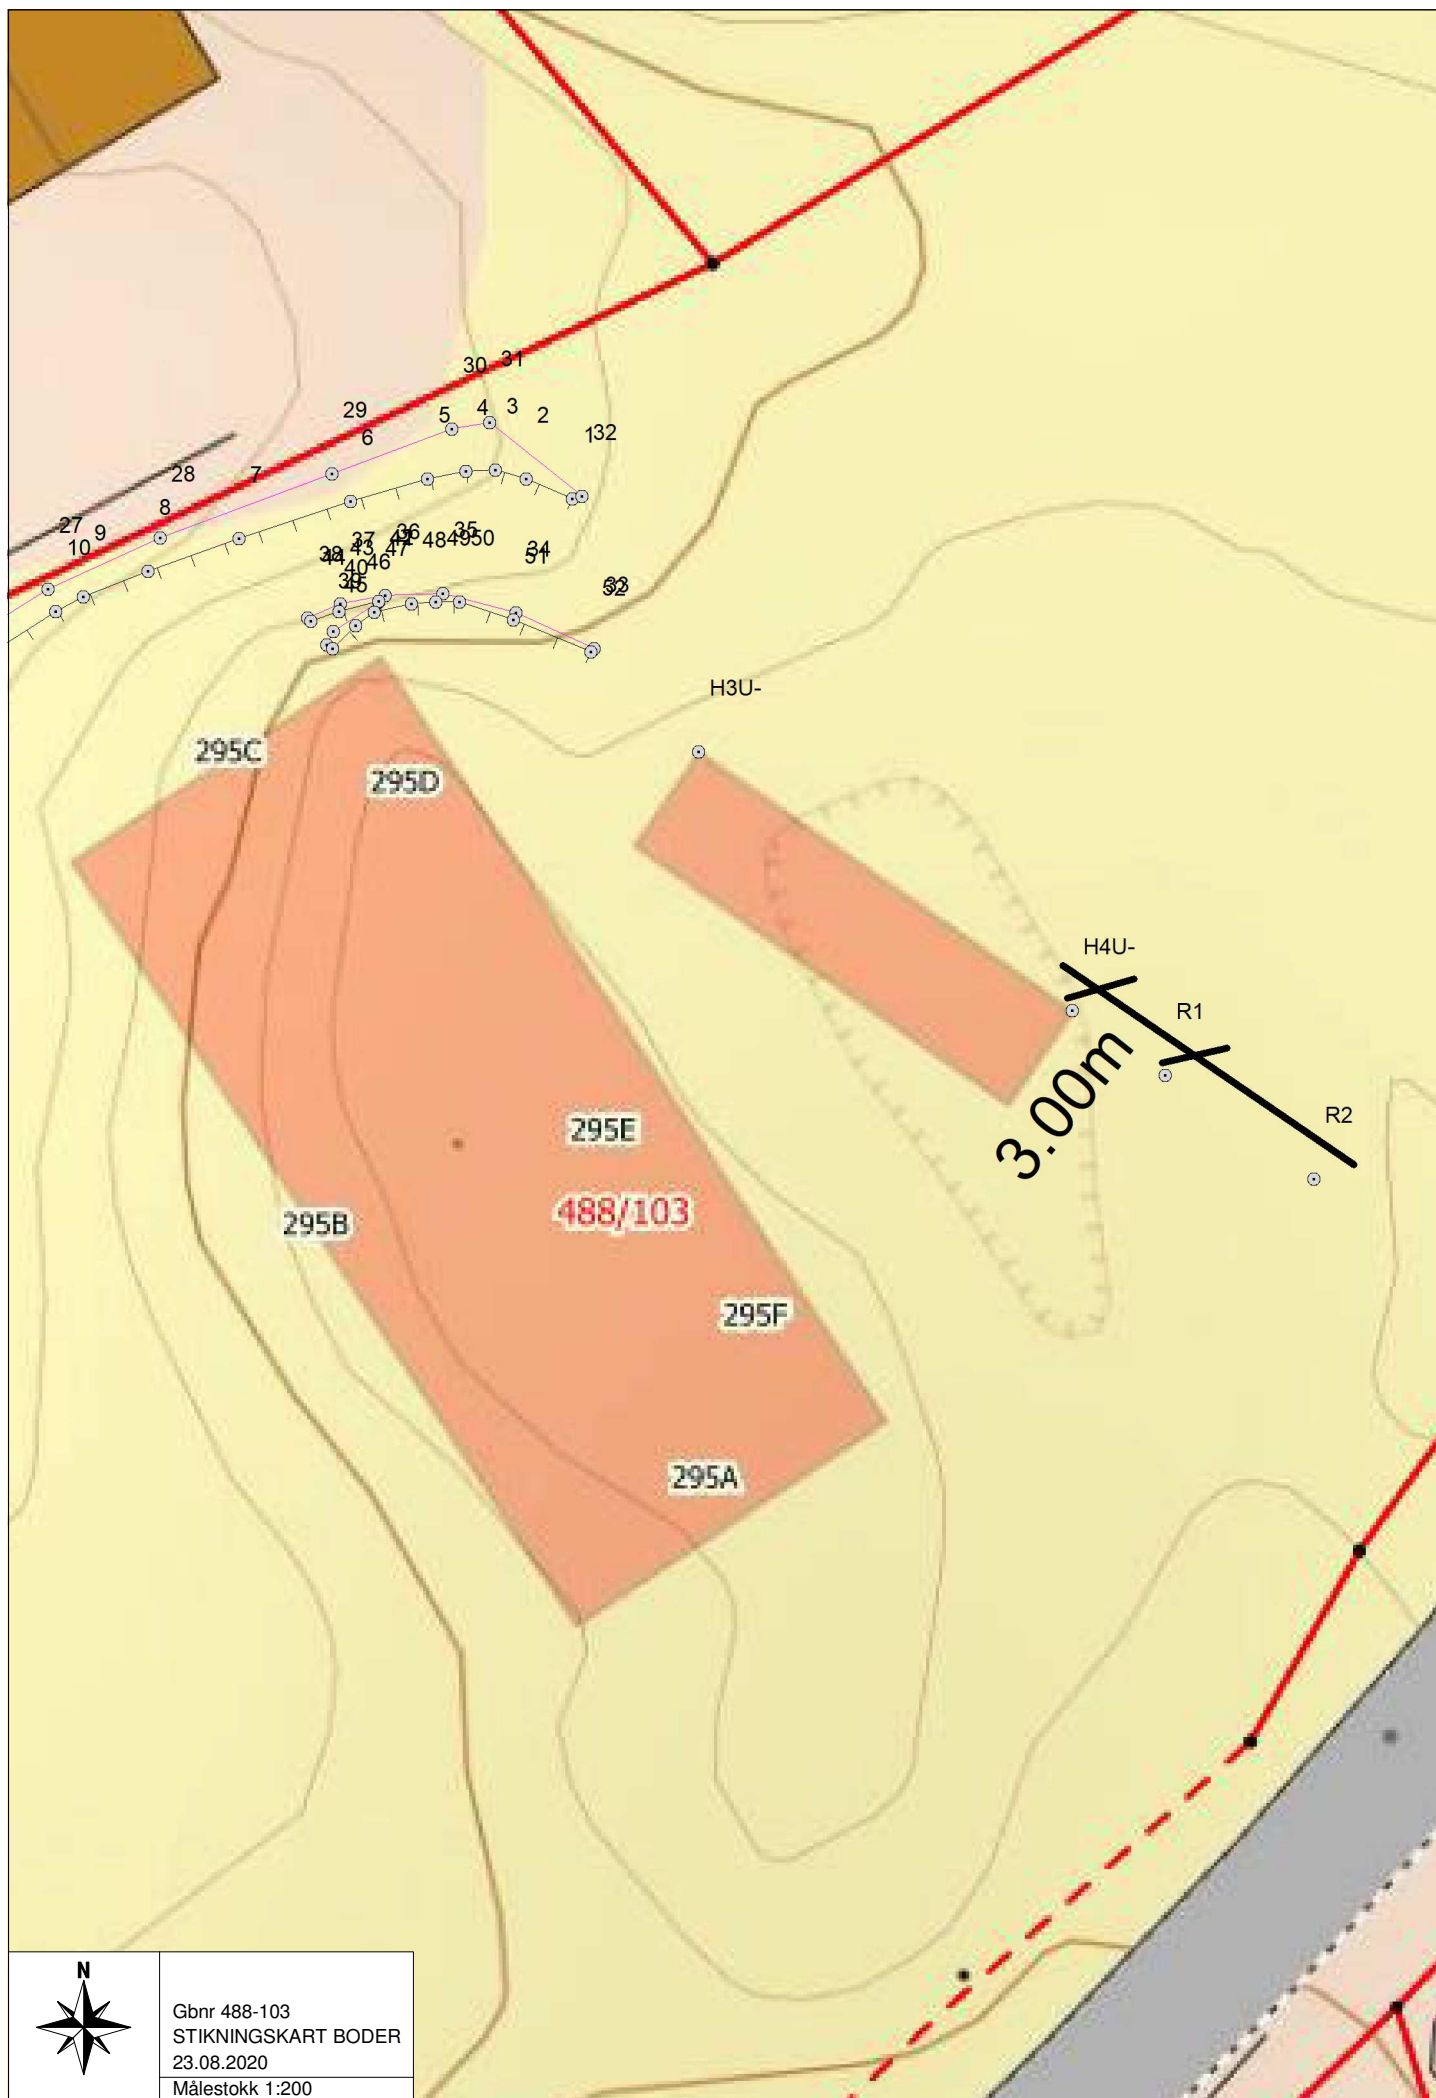

Gbnr 488-103
STIKNINGSKART BODER
23.08.2020
Målestokk 1:200