


06.01.2016

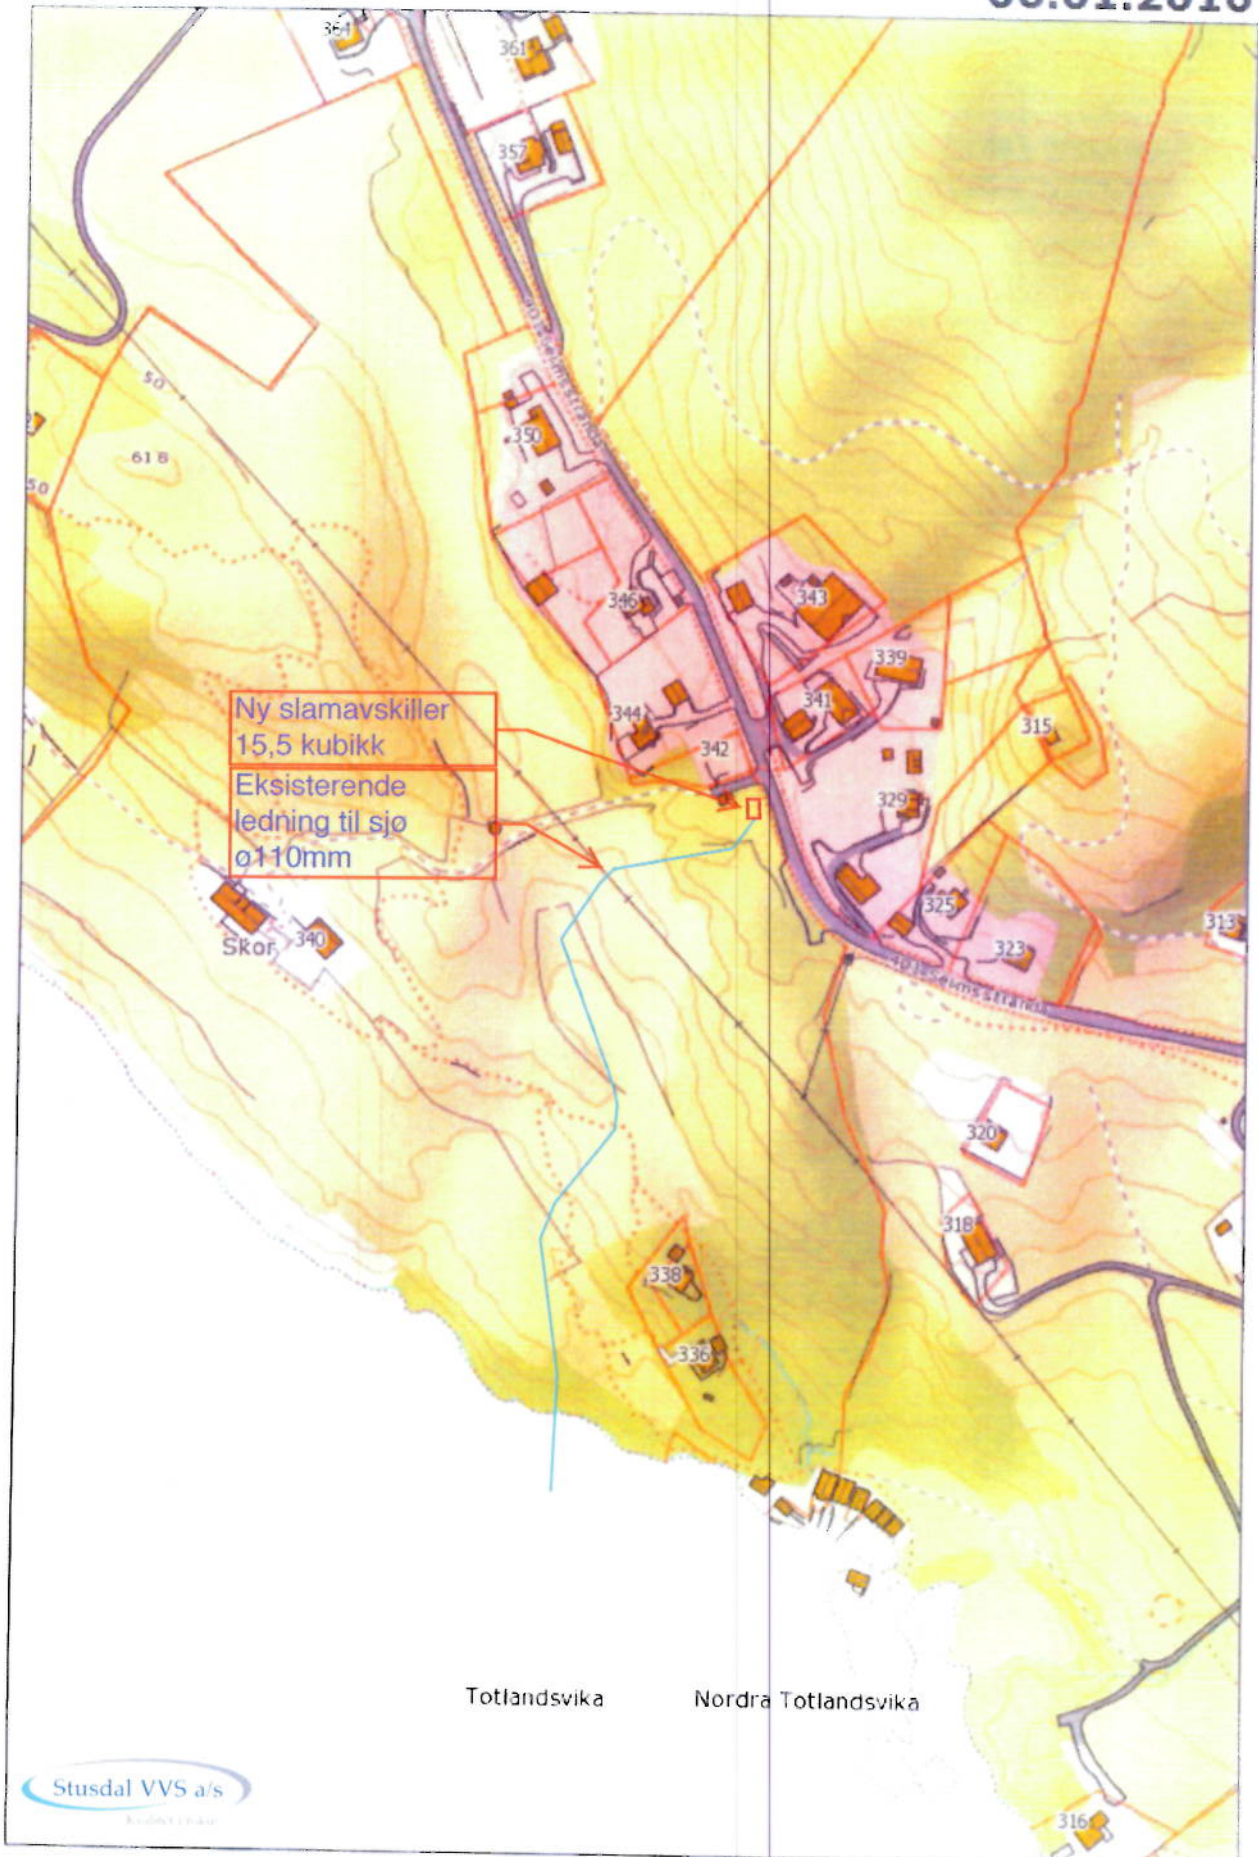

Stusdal VVS a/s
Kvalitet i praksis

Målestokk: 1:2 500

06.01.2016

