


35

Pannert

30

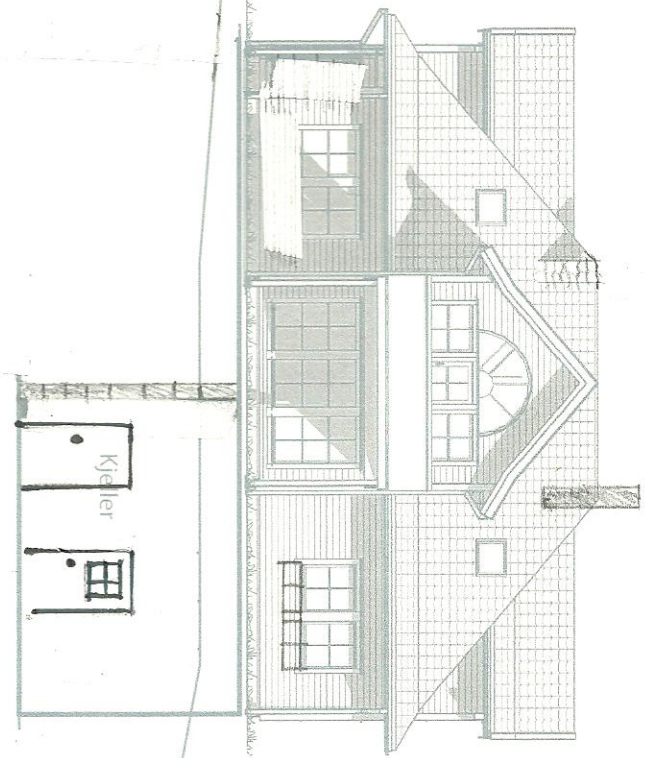

Eks. terreng

25

0

5

10

15

20

25