



# Fyllingsnes Fisk AS lokalitet Ospeneset – «as built»

Anlegg: Ospeneset

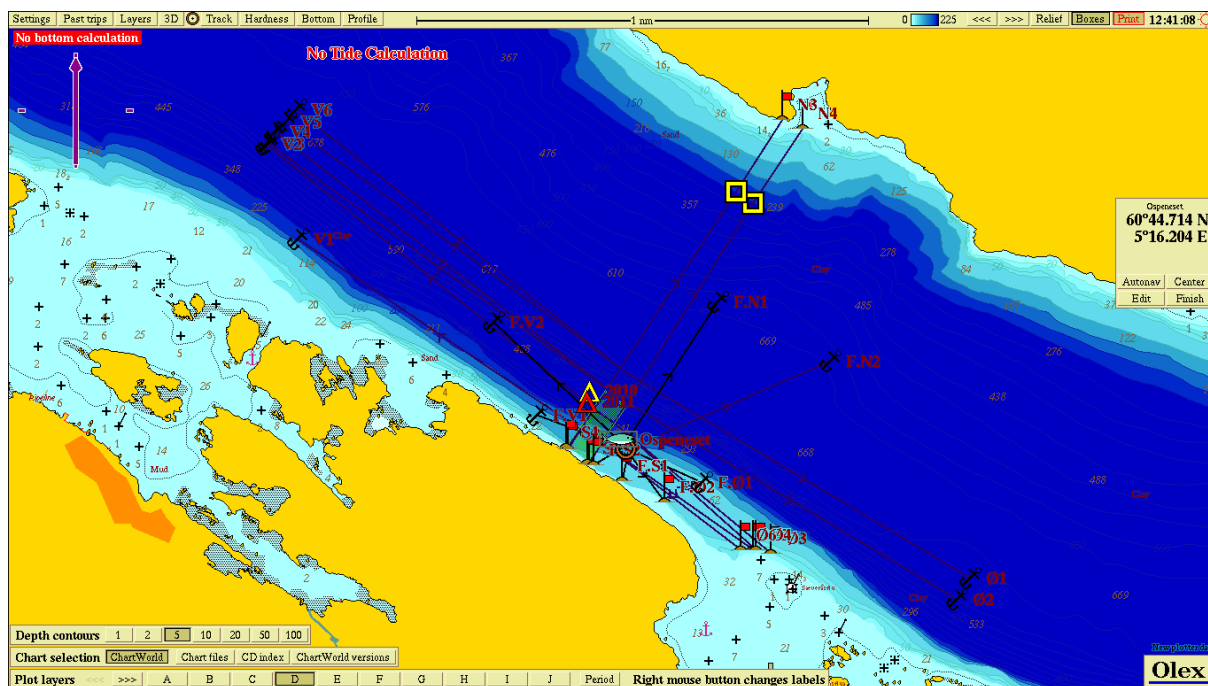

| Punkt/Line  | START       |             | SLUTT       |             |
|-------------|-------------|-------------|-------------|-------------|
|             | Breddegr.   | Lengdegr.   | Breddegr.   | Lengdegr.   |
| Fiskeridir. | 60°44,714 N | 05°16,204 Ø | -           | -           |
| Midtpunkt   | 60°44,787 N | 05°16,168 Ø | -           | -           |
| NV          | 60°44,871 N | 05°16,213 Ø | -           | -           |
| NØ          | 60°44,841 N | 05°16,305 Ø | -           | -           |
| SØ          | 60°44,706 N | 05°16,124 Ø | -           | -           |
| SV          | 60°44,735 N | 05°16,031 Ø | -           | -           |
| S1          | 60°44,706 N | 05°16,124 Ø | 60°44,709 N | 05°16,112 Ø |
| S2          | 60°44,706 N | 05°16,124 Ø | 60°44,709 N | 05°16,112 Ø |
| S3          | 60°44,735 N | 05°16,031 Ø | 60°44,738 N | 05°16,023 Ø |
| S4          | 60°44,735 N | 05°16,031 Ø | 60°44,738 N | 05°16,023 Ø |
| V1          | 60°44,735 N | 05°16,031 Ø | -           | -           |
| V2          | 60°44,780 N | 05°16,092 Ø | -           | -           |
| V3          | 60°44,826 N | 05°16,152 Ø | 60°45,369 N | 05°14,624 Ø |
| V4          | 60°44,826 N | 05°16,152 Ø | -           | -           |
| V5          | 60°44,871 N | 05°16,213 Ø | -           | -           |
| V6          | 60°44,871 N | 05°16,213 Ø | -           | -           |
| N3          | 60°44,871 N | 05°16,213 Ø | 60°45,404 N | 05°16,640 Ø |
| N4          | 60°44,841 N | 05°16,305 Ø | 60°45,412 N | 05°16,770 Ø |
| Ø1          | 60°44,841 N | 05°16,305 Ø | 60°44,407 N | 05°17,796 Ø |
| Ø2          | 60°44,796 N | 05°16,244 Ø | 60°44,360 N | 05°16,732 Ø |
| Ø3          | 60°44,751 N | 05°16,184 Ø | 60°44,745 N | 05°16,174 Ø |
| Ø4          | 60°44,751 N | 05°16,184 Ø | 60°44,745 N | 05°16,174 Ø |
| Ø5          | 60°44,706 N | 05°16,124 Ø | 60°44,709 N | 05°16,112 Ø |
| Ø6          | 60°44,706 N | 05°16,124 Ø | 60°44,709 N | 05°16,112 Ø |

## Flåte: Ospeneset

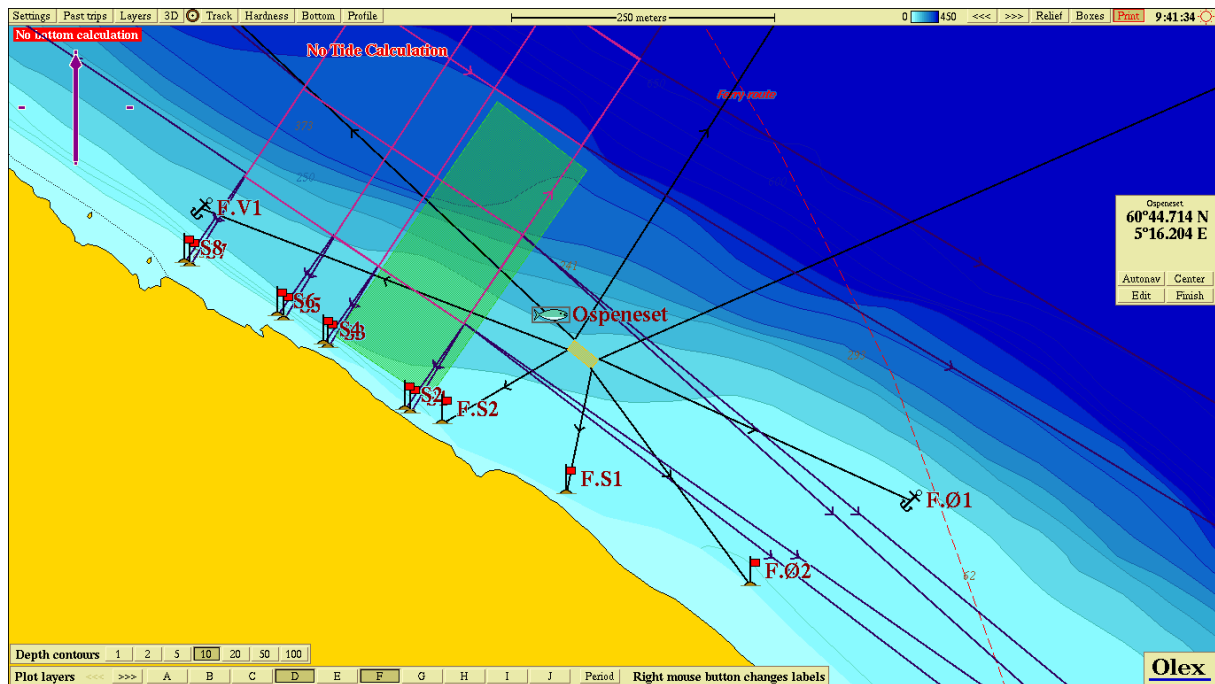

| Punkt/Line  | START       |             | SLUTT       |             |
|-------------|-------------|-------------|-------------|-------------|
|             | Breddegr.   | Lengdegr.   | Breddegr.   | Lengdegr.   |
| Fiskeridir. | 60°44,714 N | 05°16,204 Ø | -           | -           |
| Midtpunkt   | 60°44,693 N | 05°16,237 Ø | -           | -           |
| NV          | 60°44,701 N | 05°16,228 Ø | -           | -           |
| NØ          | 60°44,691 N | 05°16,253 Ø | -           | -           |
| SØ          | 60°45,686 N | 05°16,246 Ø | -           | -           |
| SV          | 60°44,696 N | 05°16,221 Ø | -           | -           |
| F.S1        | 60°44,686 N | 05°16,246 Ø | 60°44,686 N | 05°16,246 Ø |
| F.S2        | 60°44,696 N | 05°16,221 Ø | 60°44,696 N | 05°16,221 Ø |
| F.V1        | 60°44,696 N | 05°16,221 Ø | 60°44,802 N | 05°15,693 Ø |
| F.V2        | 60°44,701 N | 05°16,228 Ø | 60°44,973 N | 05°15,638 Ø |
| F.N1        | 60°44,701 N | 05°16,228 Ø | 60°45,019 N | 05°16,653 Ø |
| F.N2        | 60°44,691 N | 05°16,253 Ø | 60°44,886 N | 05°17,159 Ø |
| F.Ø1        | 60°44,691 N | 05°16,253 Ø | 60°44,594 N | 05°16,576 Ø |
| F.Ø2        | 60°44,686 N | 05°16,246 Ø | 60°44,686 N | 05°16,246 Ø |

NB!

Start: Er posisjonen oppe på anlegget.

Stopp: Er posisjonen nede på bunnfestet/ev. bolt

Byggeperiode: september/oktober 2015