


Løe 194/5

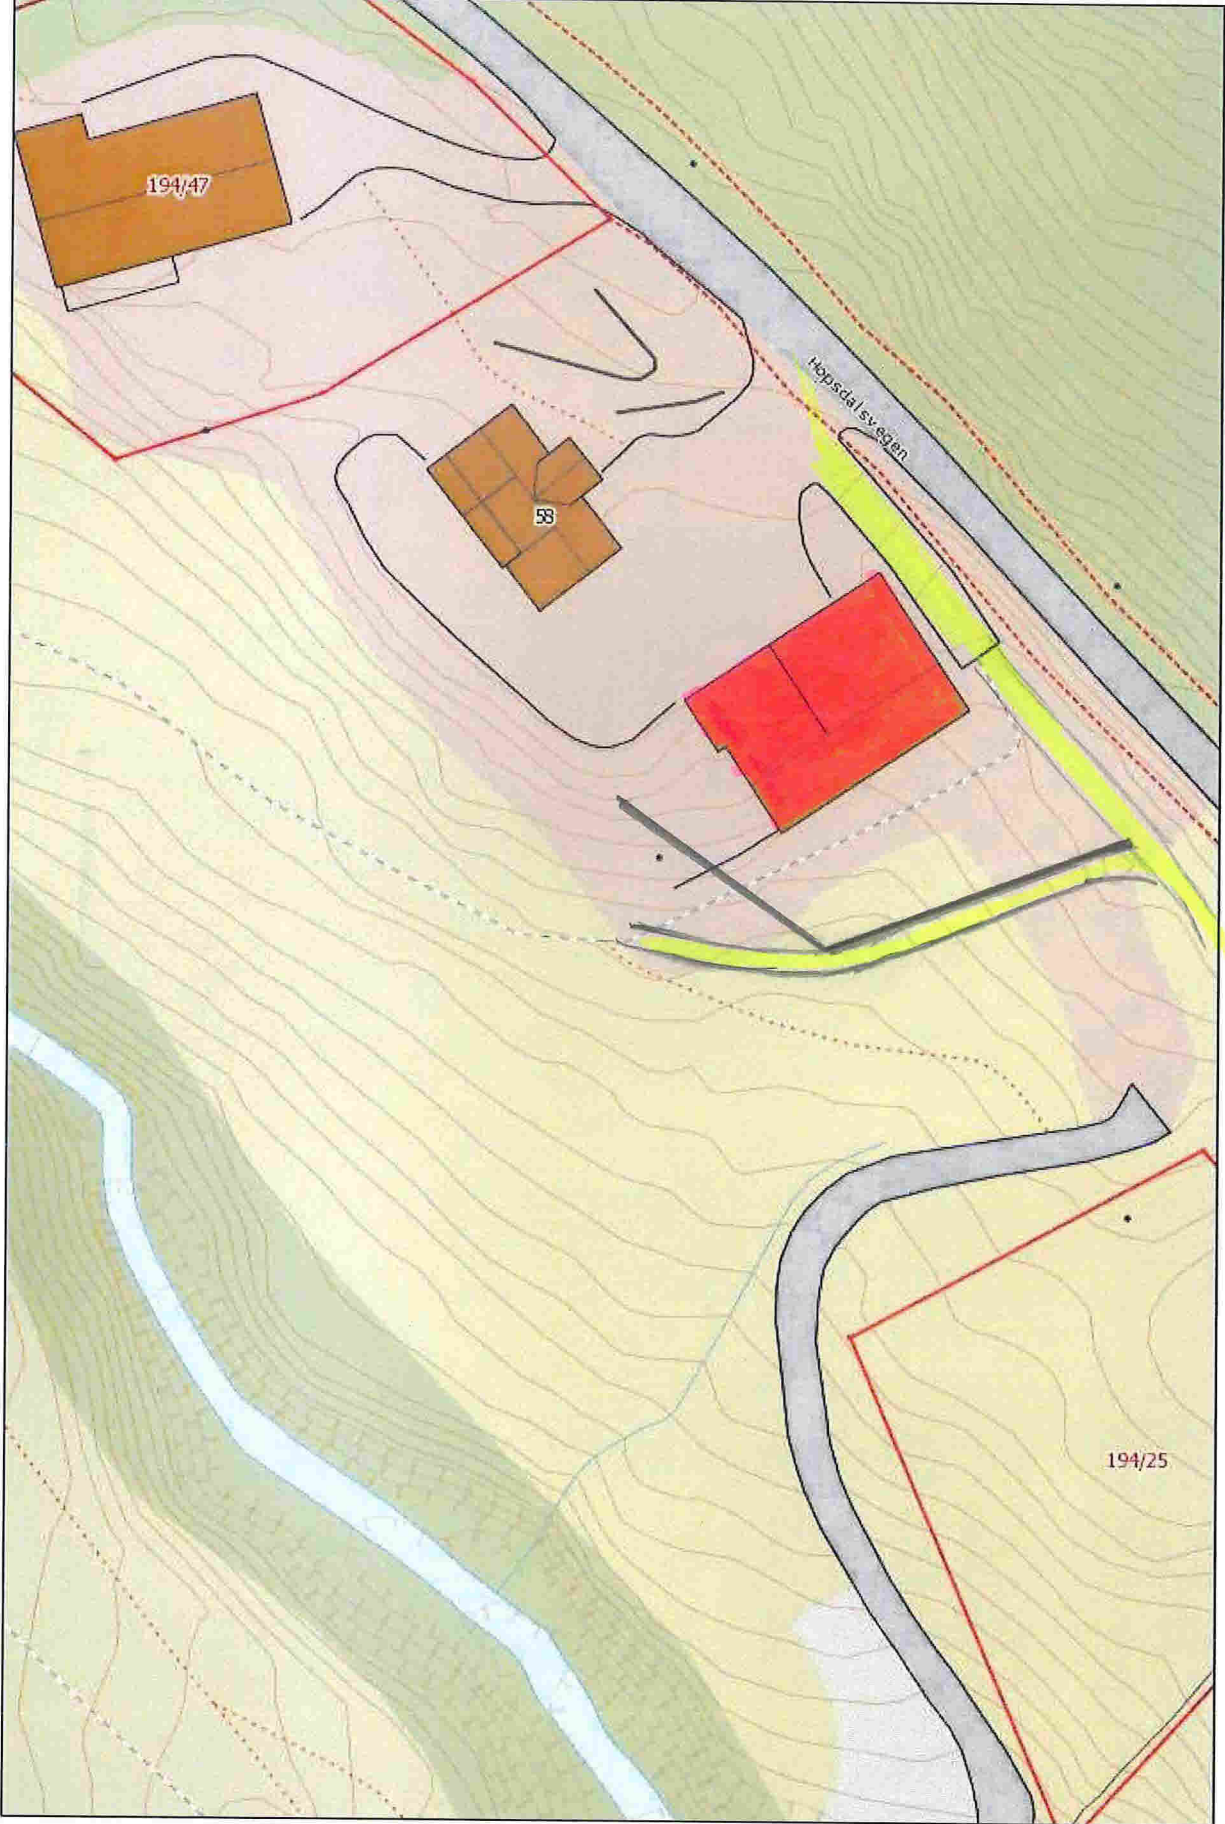

Målestokk: 1:500