


Bunker Oil Austmarka

18.03.2016

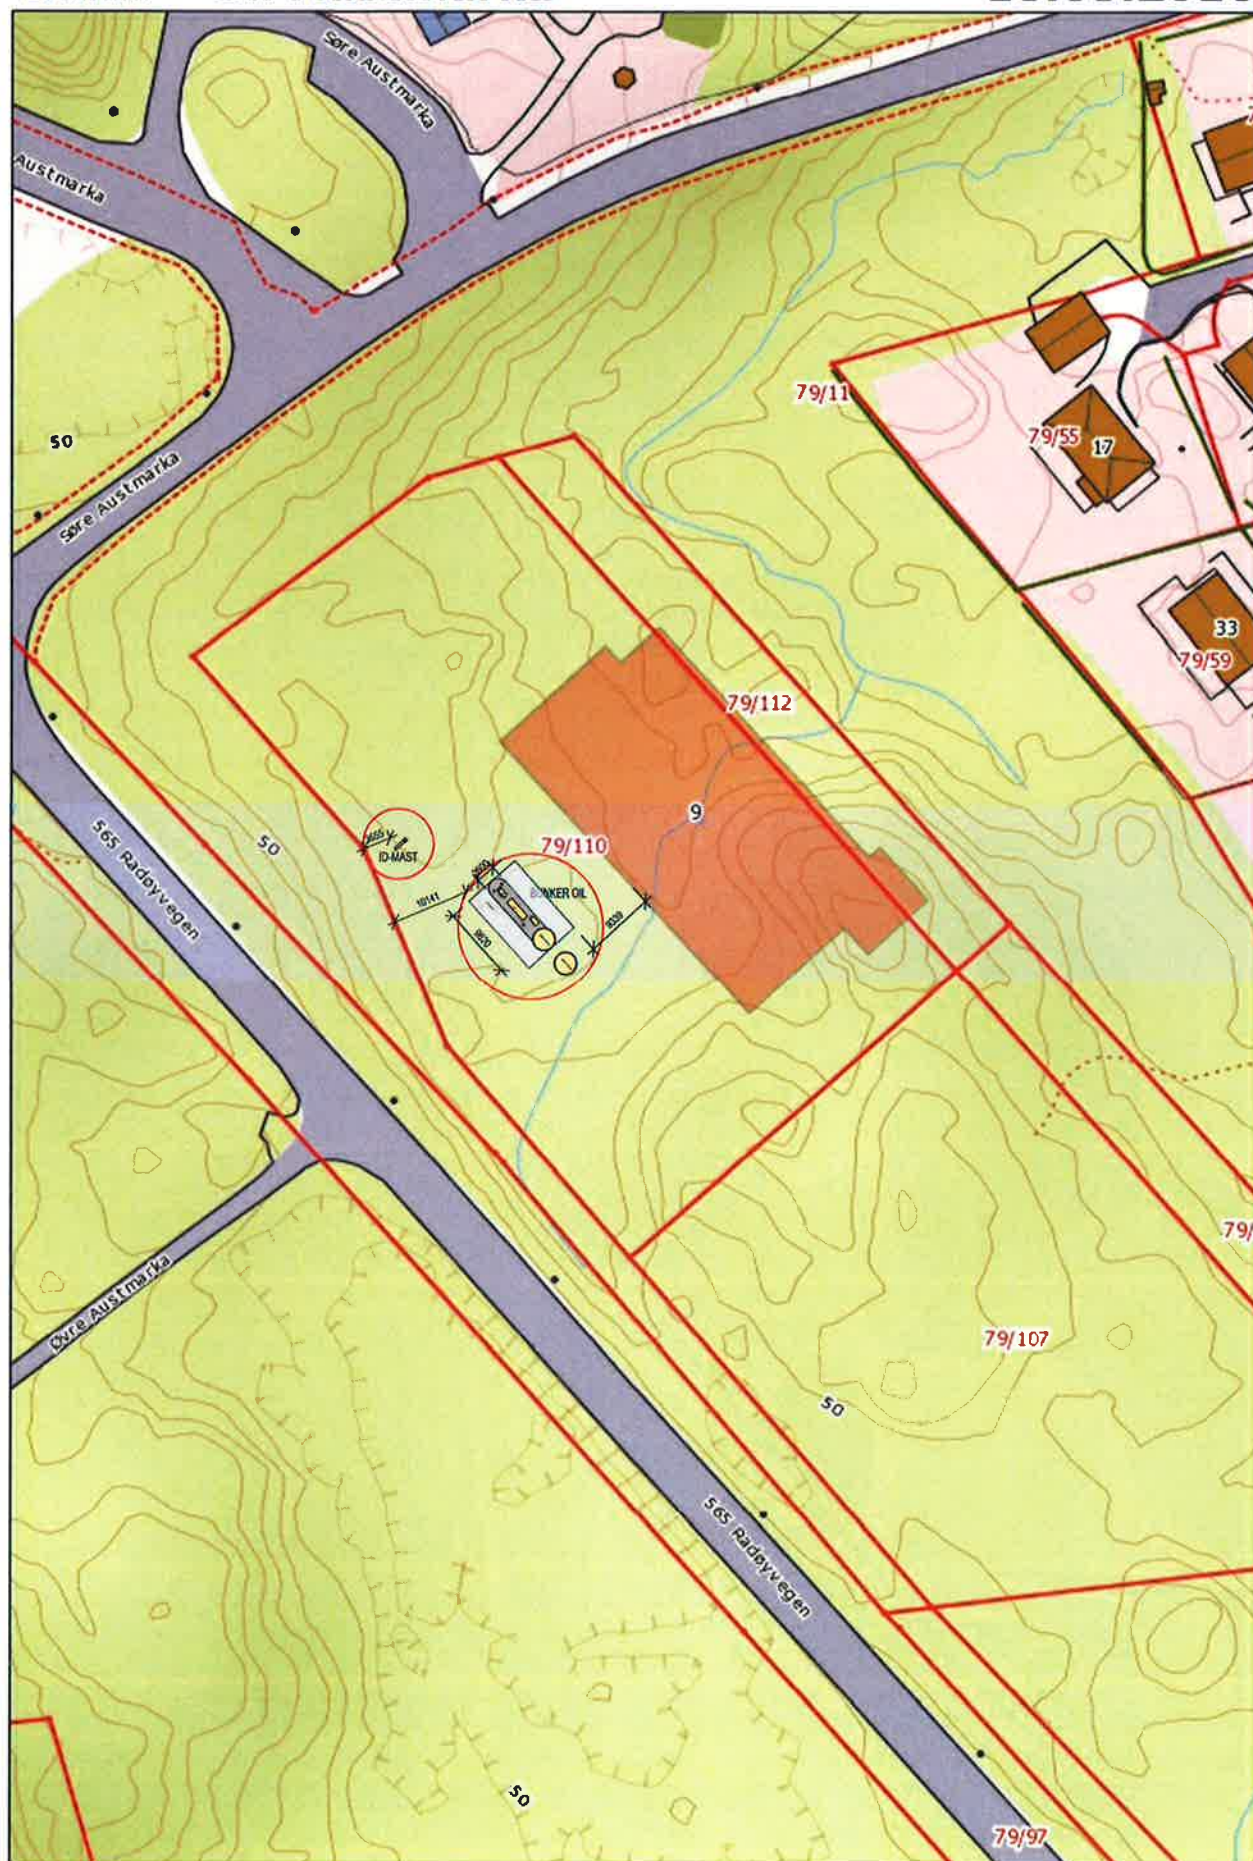

Målestokk: 1:1 000