


Area for temporary wet storage of subsea scrap cable near Kuvågen (Hjeltefjorden)

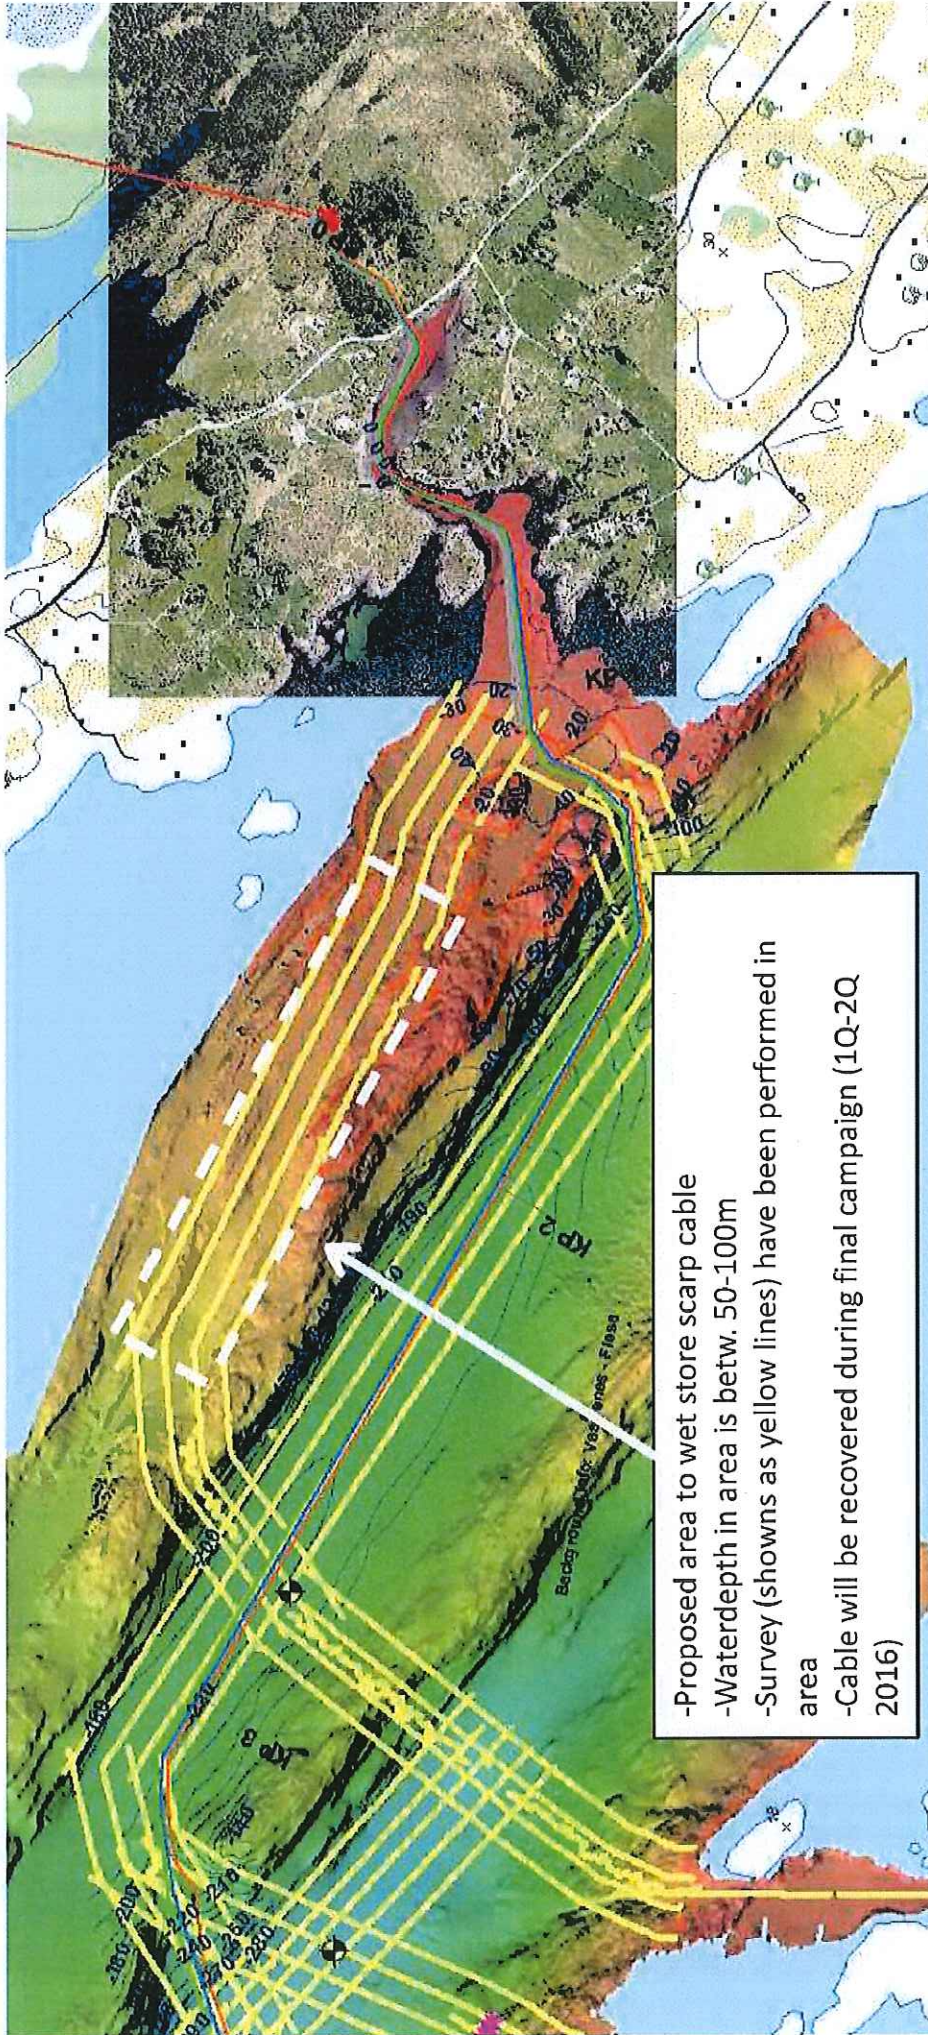

-Proposed area to wet store scrap cable
-Waterdepth in area is betw. 50-100m
-Survey (shown as yellow lines) have been performed in area
-Cable will be recovered during final campaign (1Q-2Q 2016)


Handwritten signature

GODKJENT
KYSTVERKET
VEST

7-7-2016
Handwritten signature

Kollnes

GODKJENT
3.9.2013
KYSTVERKET
VEST
EWF.

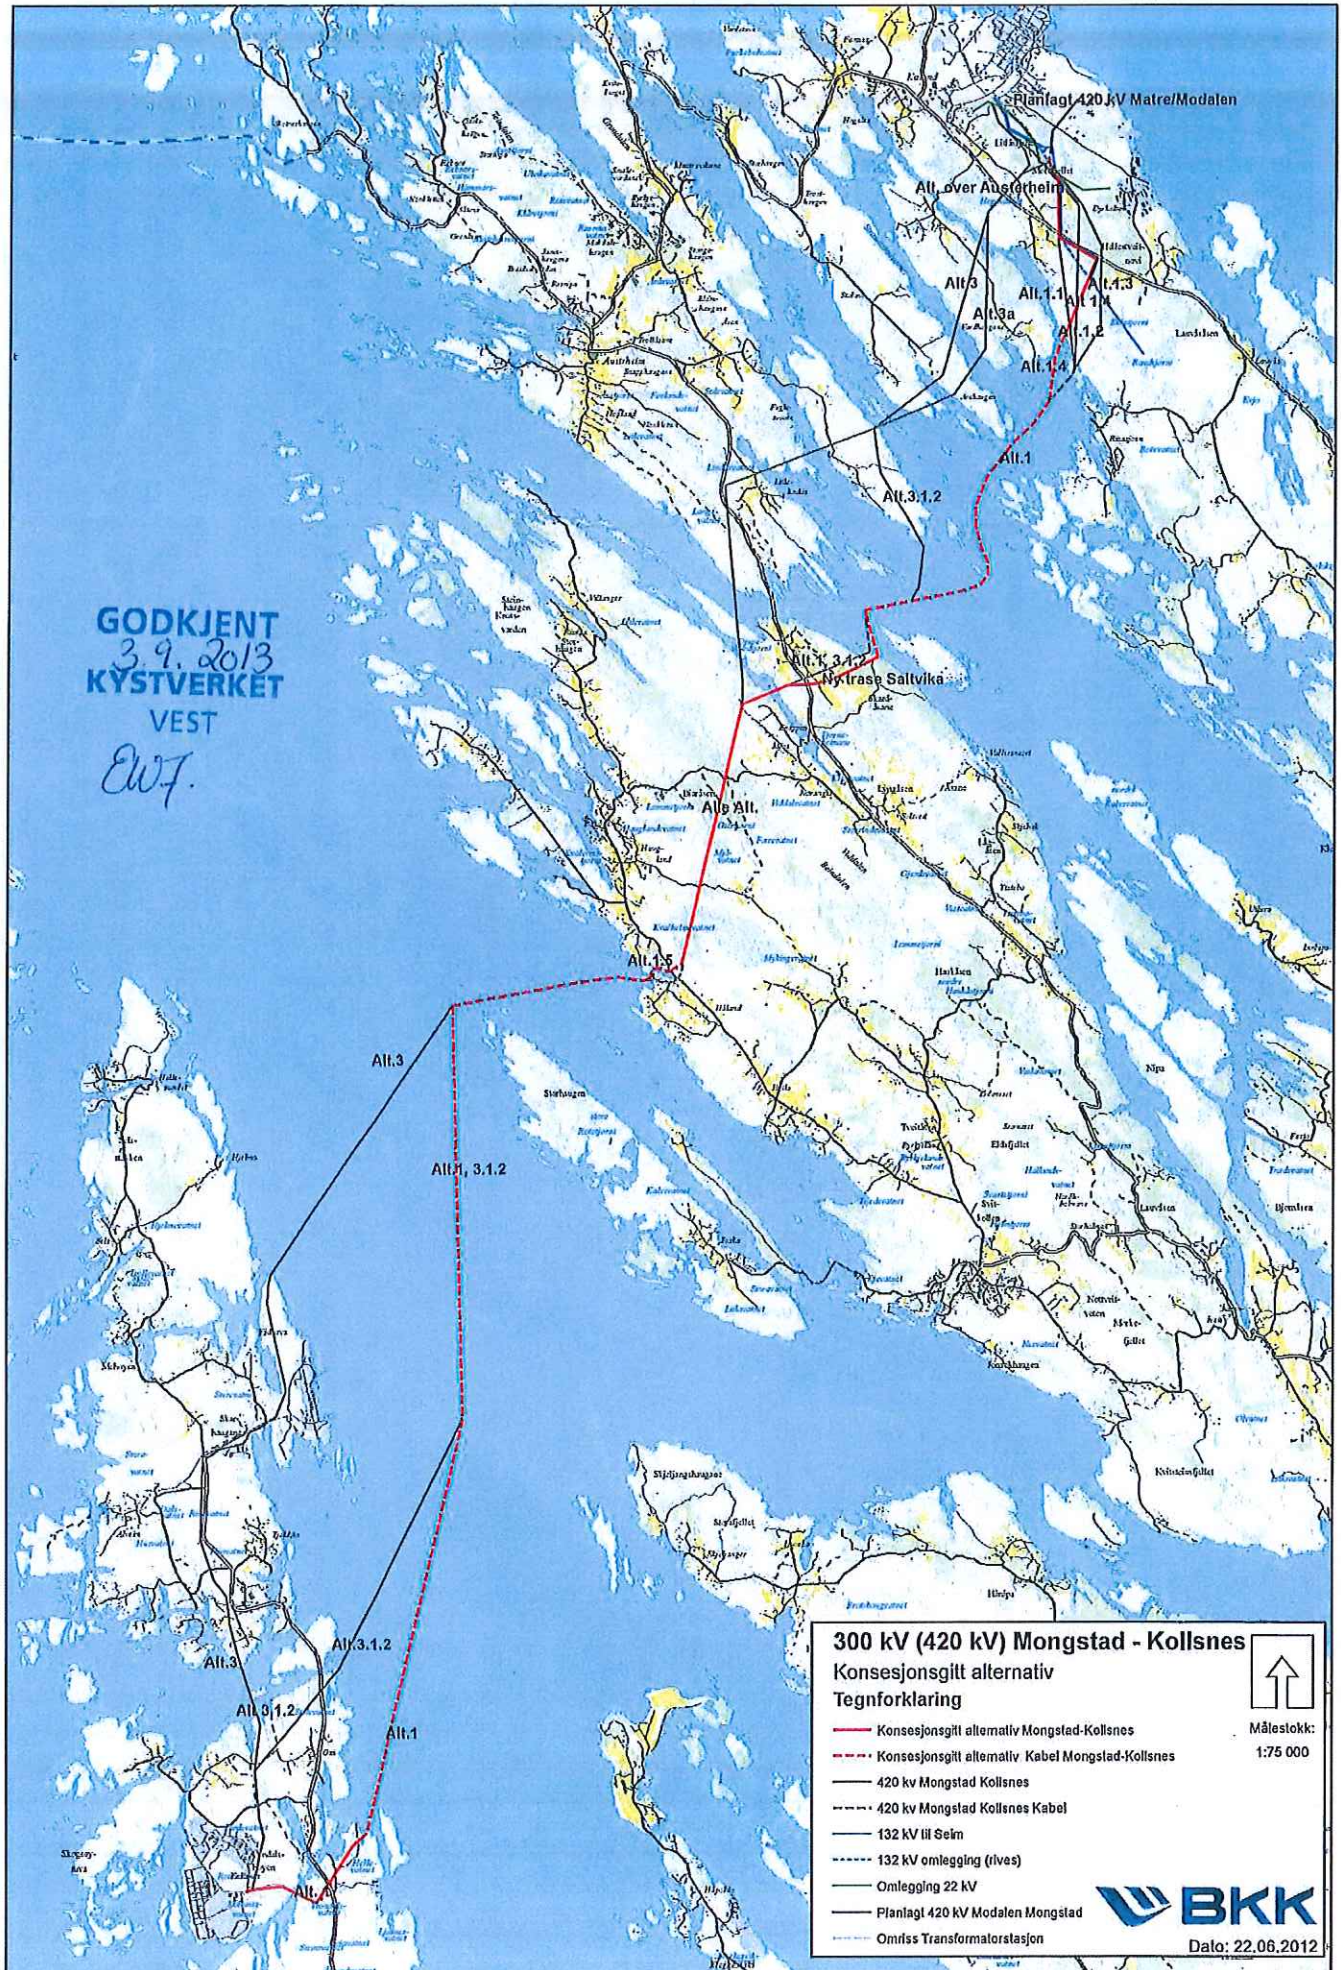

300 kV (420 kV) Mongstad - Kollnes
 Konesjonsgilt alternativ
 Tegnforklaring

- Konesjonsgilt alternativ Mongstad-Kollnes
- - - Konesjonsgilt alternativ Kabel Mongstad-Kollnes
- 420 kv Mongstad Kollnes
- - - 420 kv Mongstad Kollnes Kabel
- - - 132 kv til Seim
- - - 132 kv omlegging (rivas)
- Omlegging 22 kv
- Planlagt 420 kv Modalen Mongstad
- - - Omriss Transformatorstasjon

Målestokk:
1:75 000

BKK
 Dato: 22.06.2012