

196/162

Midtgård

2Hy

Hjelmas  
vvs<sup>2/3</sup>


90

9.5m

9.5m

3m

90

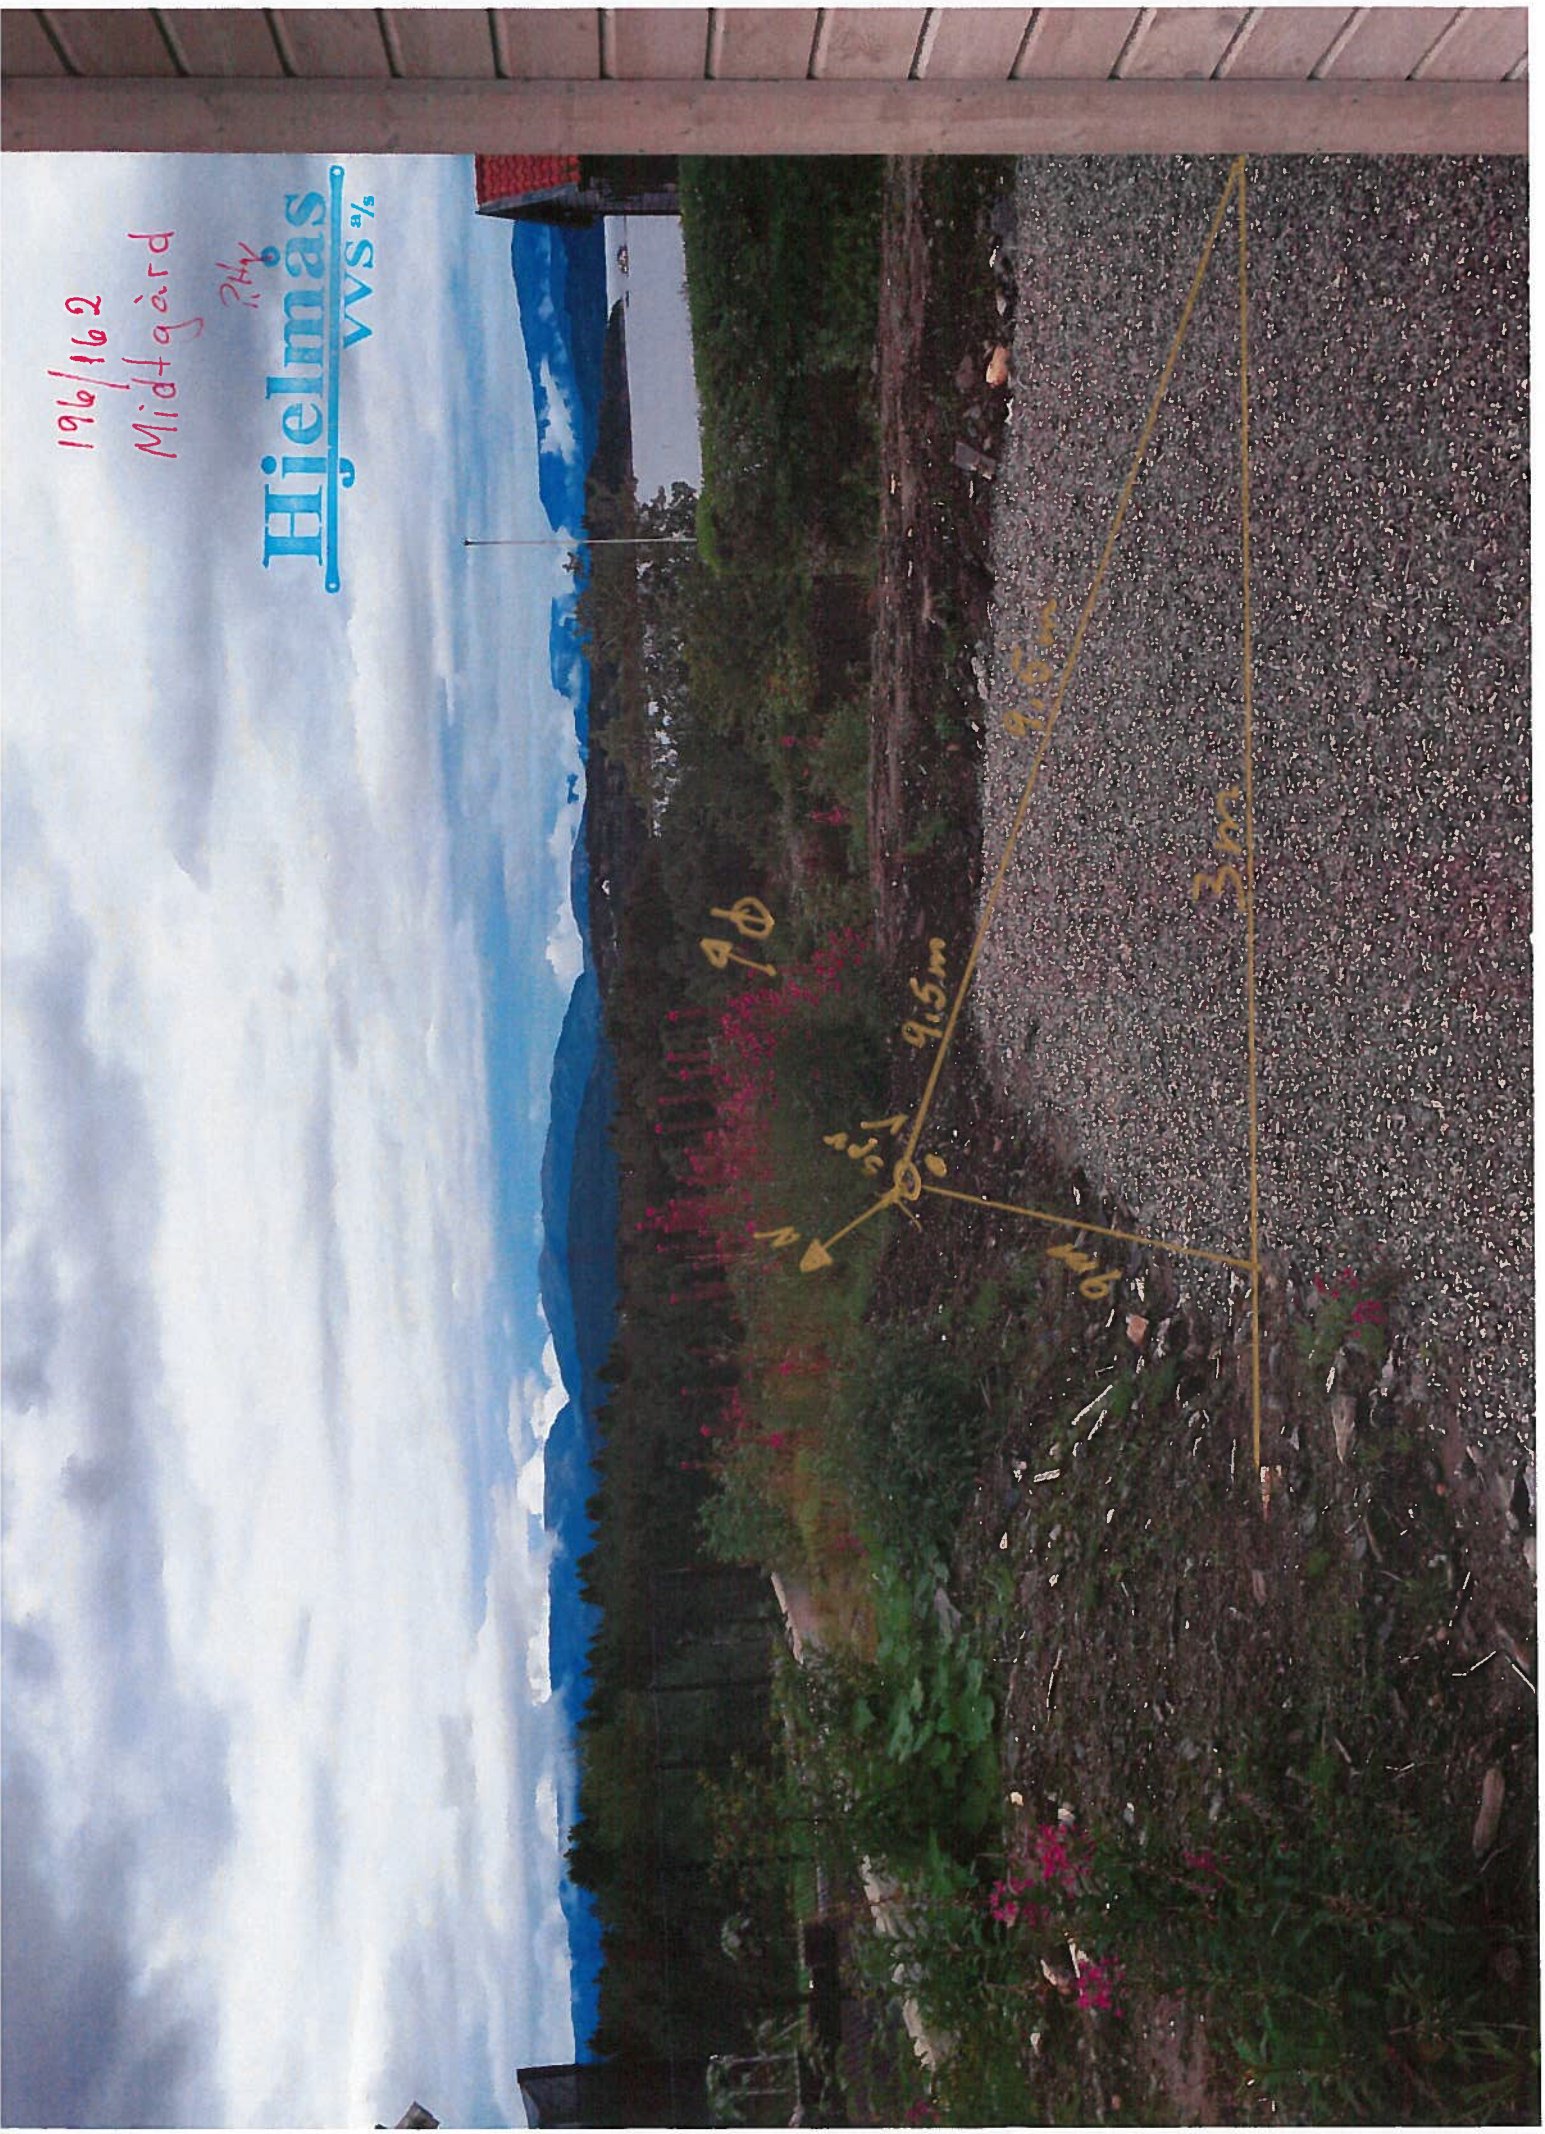

196/162  
Midtgård

Hjelmås  
vvs AB



↑ N

Gravel

3m → 9m

1.5m

1.5m