


Gnr 110 - bnr 7 - Syslake

Sak 96/16 - Korrigent

Totalareal for 2 tomtar

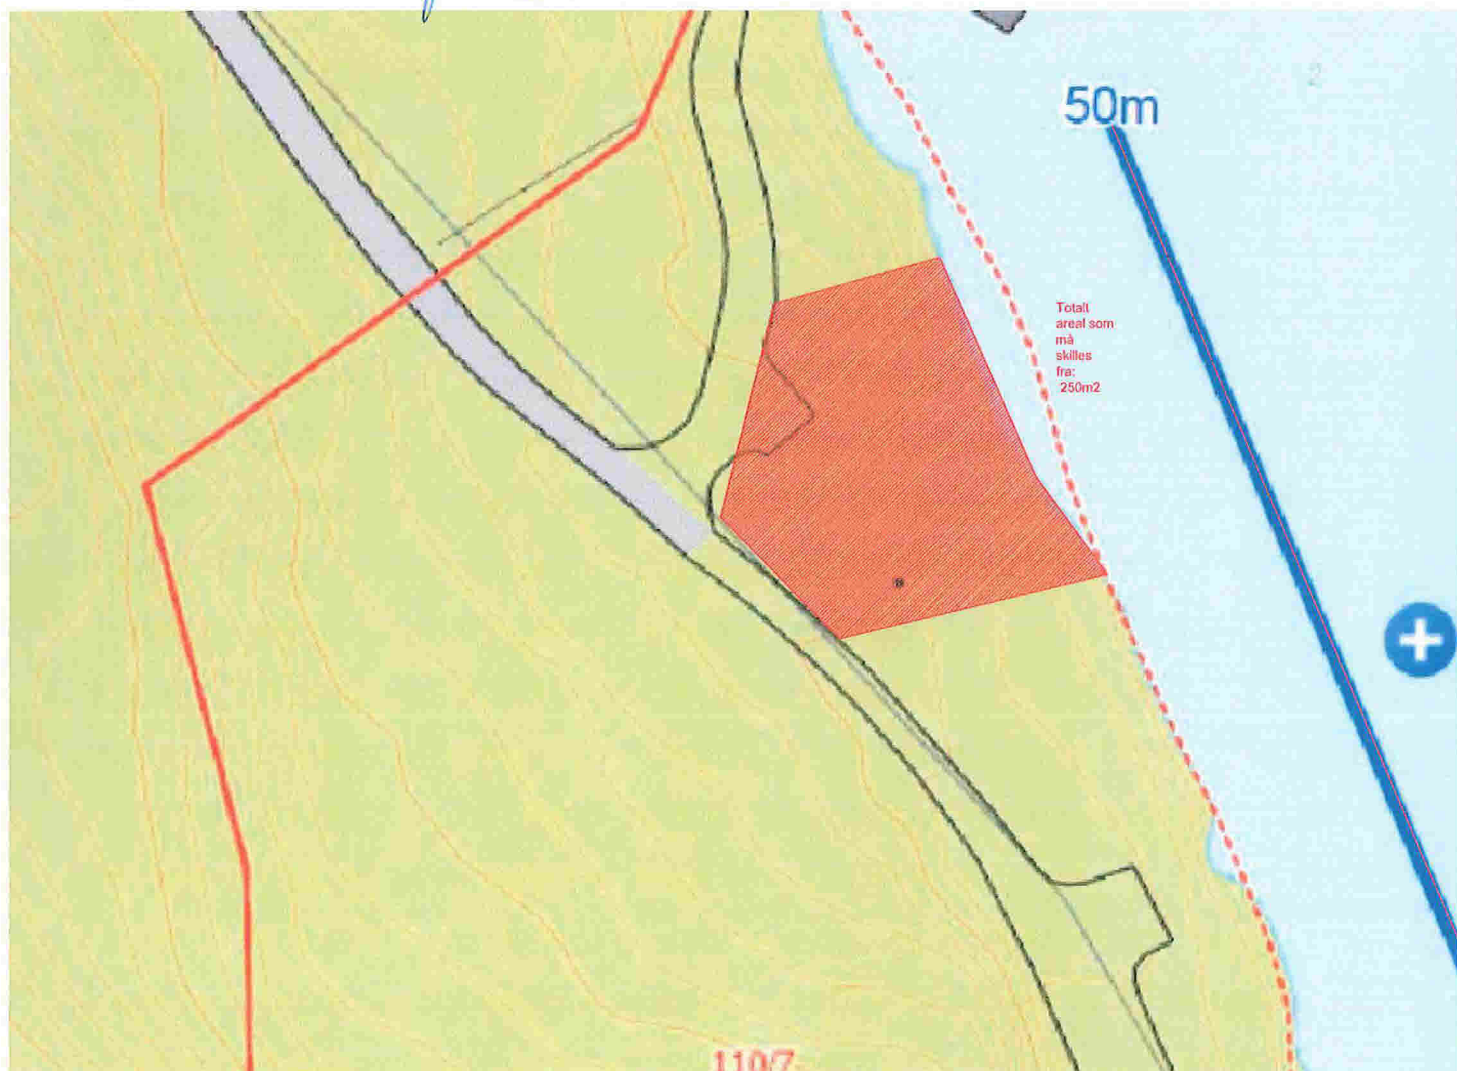

Gnr 110 - bnr 7 - Sjøslak

Sak 96/16 - korrigert

Slik tenkjer vi at 2 nausttomtar kan plasserast.

