


6752700
6752705
6752710
6752715
6752720
6752725
6752730
6752735
6752740
6752745
6752750
6752755
6752760
6752765
6752770
6752775
6752780
6752785
6752790
6752795
6752800
6752805
6752810

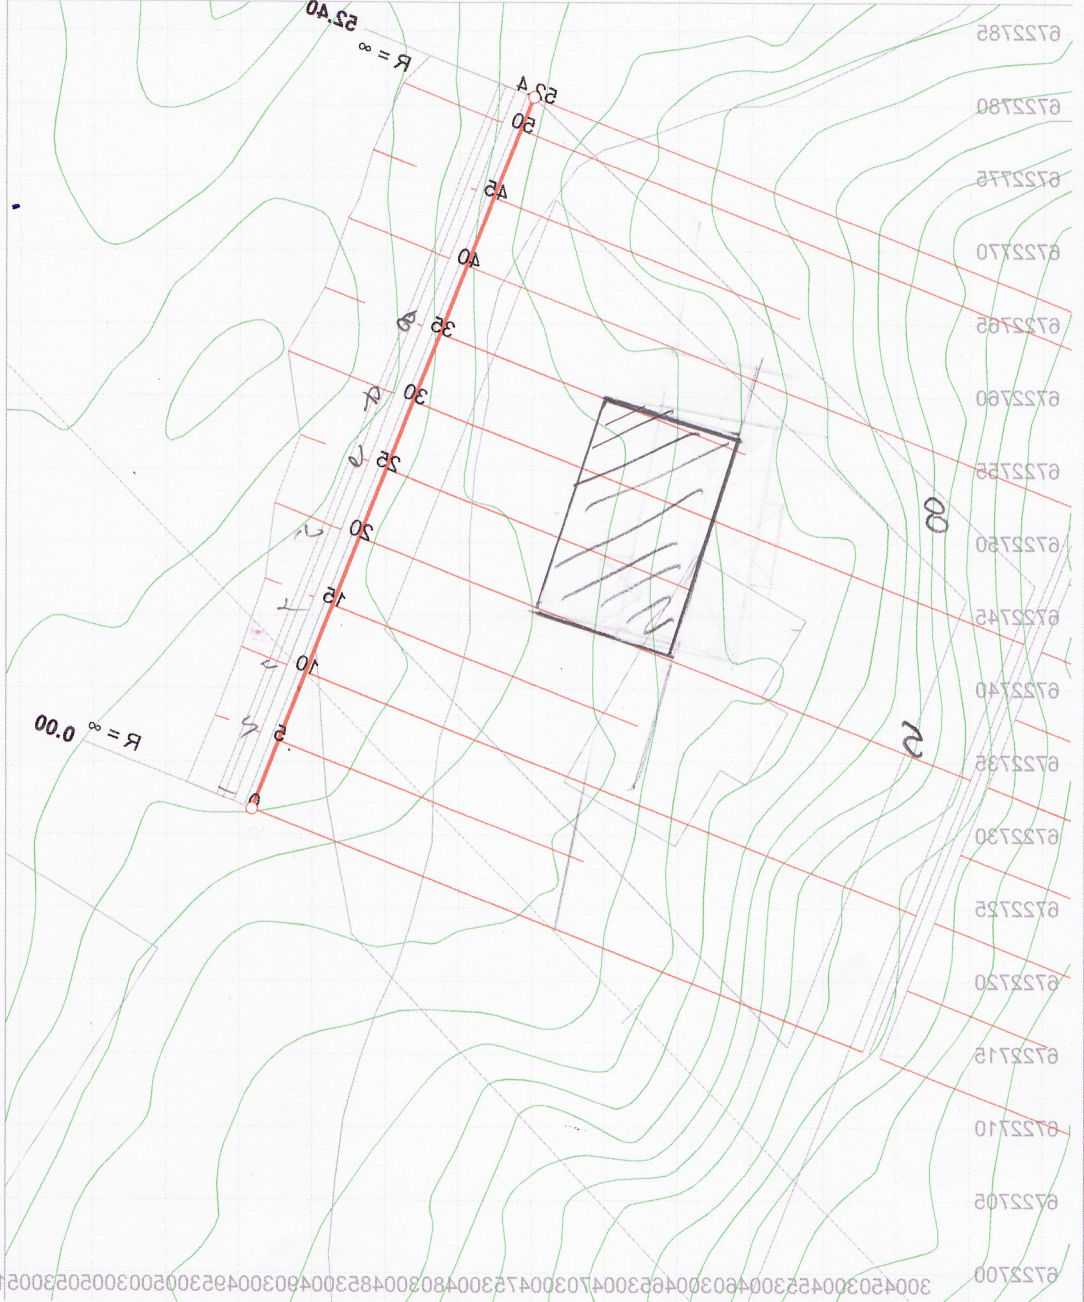

30045030045230046030046030047030047030047300480300482300490300492300500300502300510300512300520300522

LT: 4828186 E-Post: kjaeraga@online.no
Litvika 47, 2014 ledasta

Medgas Opbmaaling

Horisontalslusa

Gnr 202161

Teignr.	1
Proj.nr.	1: 500
Dato	31.10.2016
Stemningskont.	Projeksjonsvaerdi
Teignr. sv	KM
Saksforandrer	

