


Orresteinen

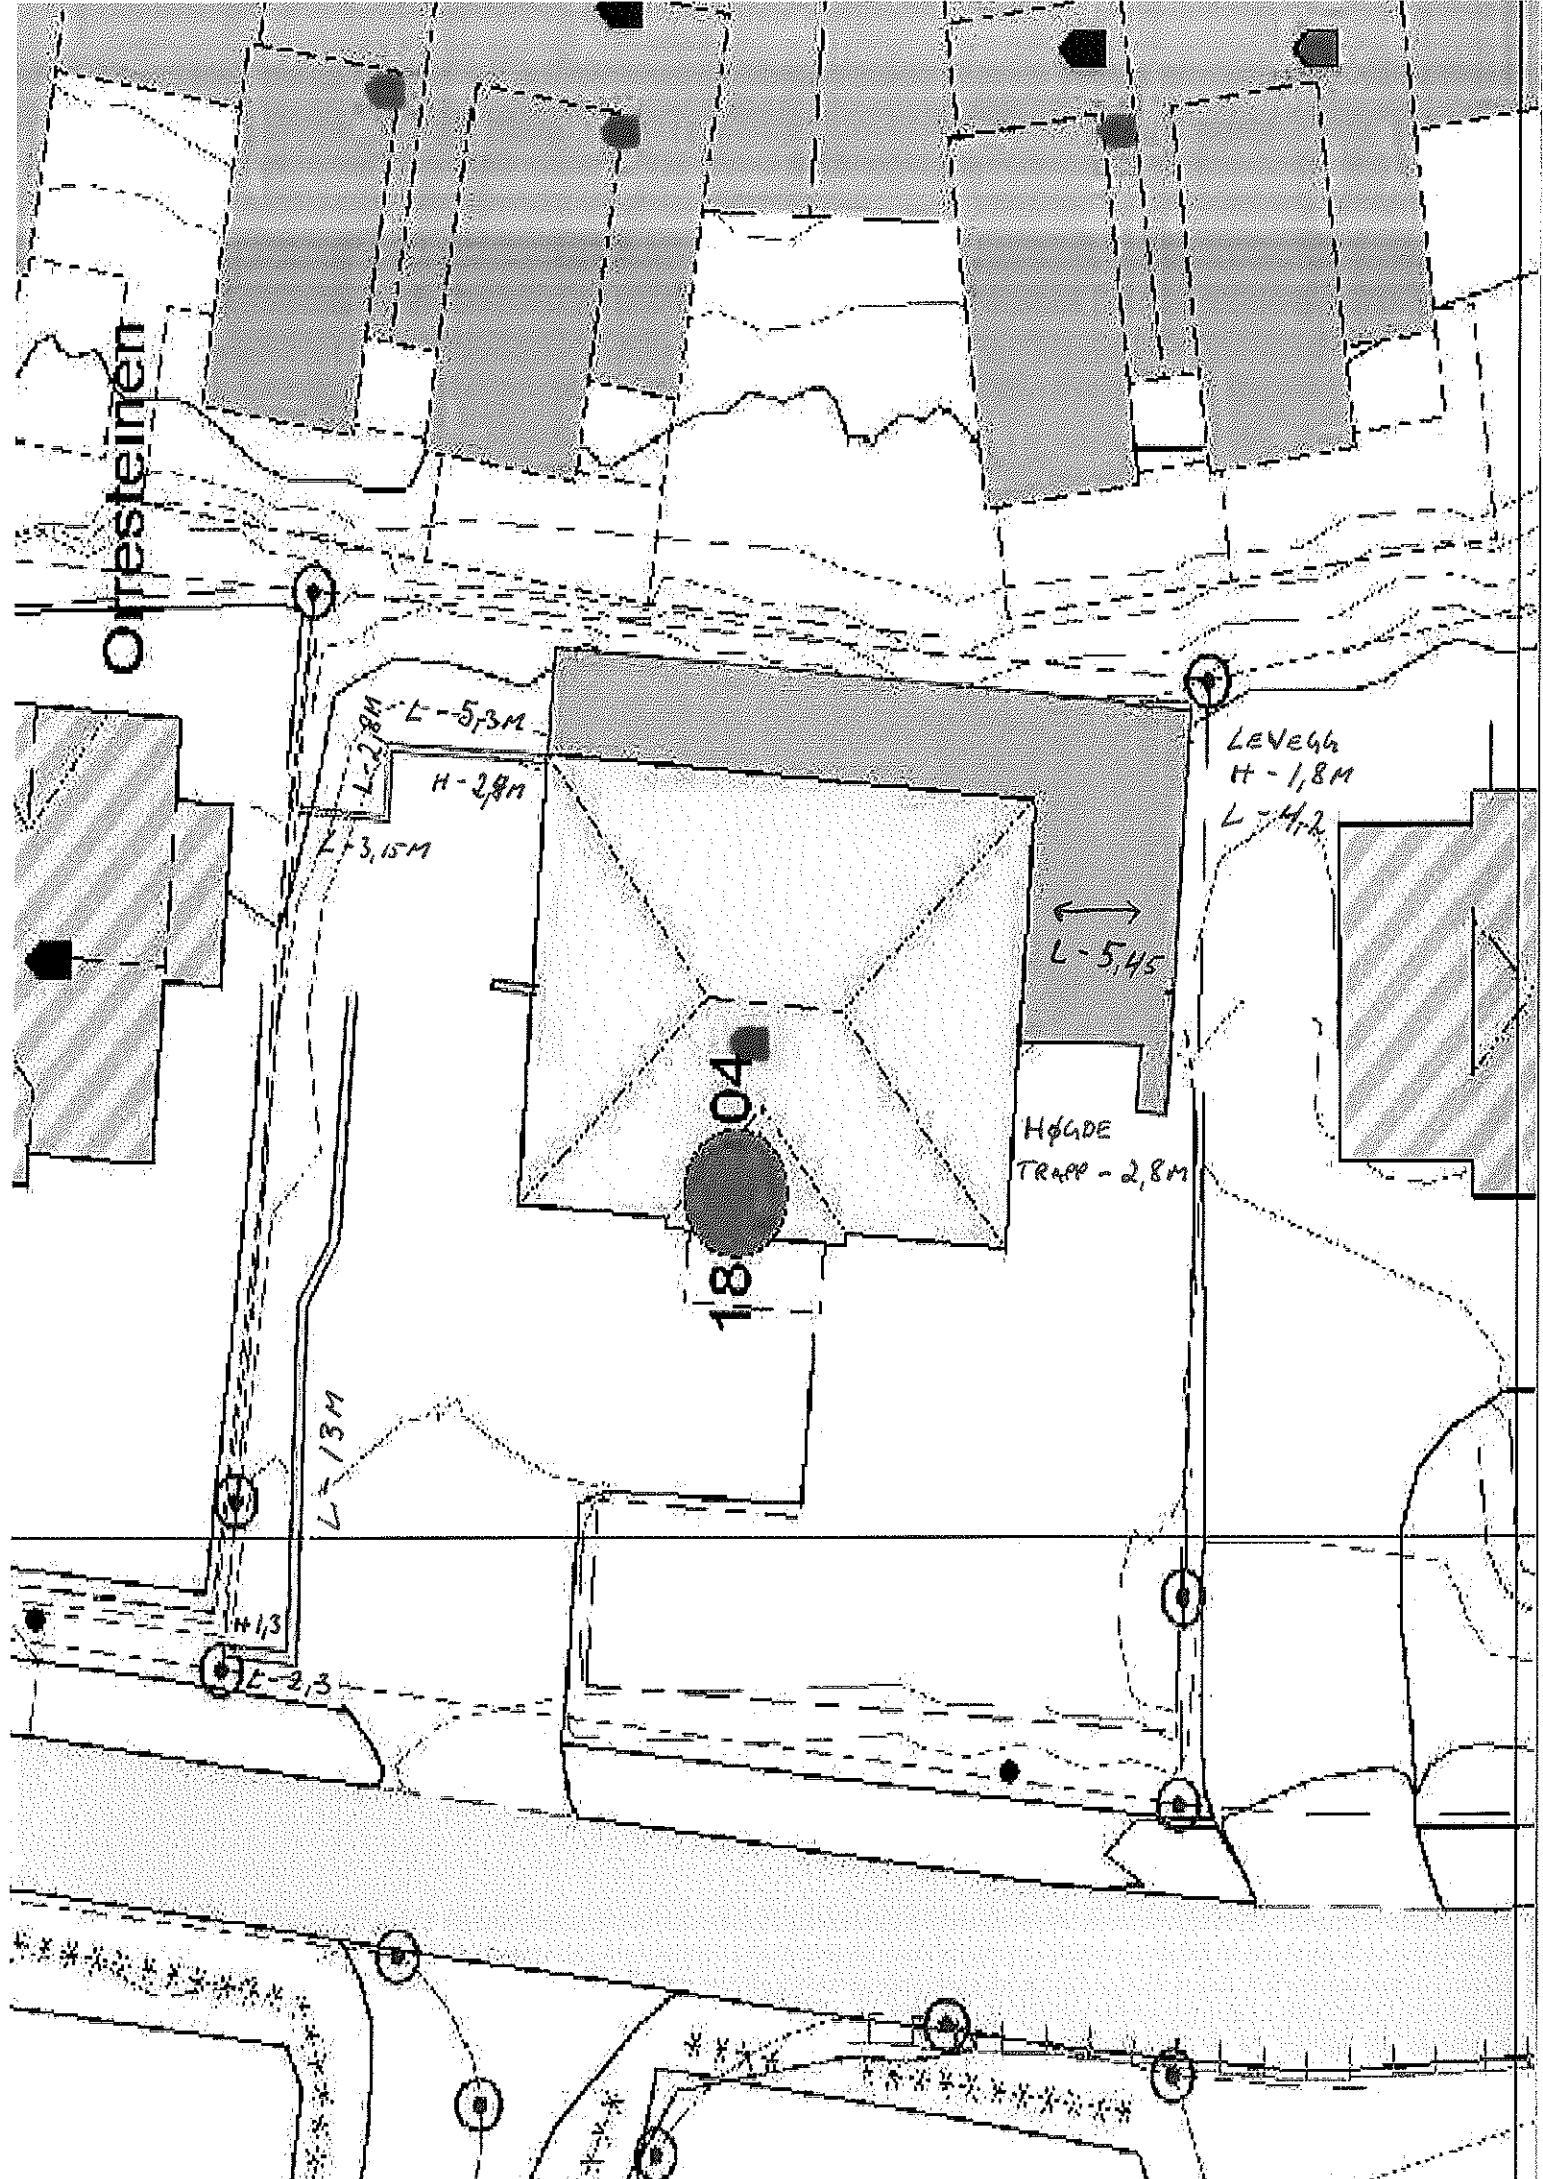

L=5,3M
H=2,8M

LEVEG
H=1,8M
L=4,2

L=5,45

HØGDE
TRAPP = 2,8M

18,04

L=1,3M

H=1,3
L=2,3