


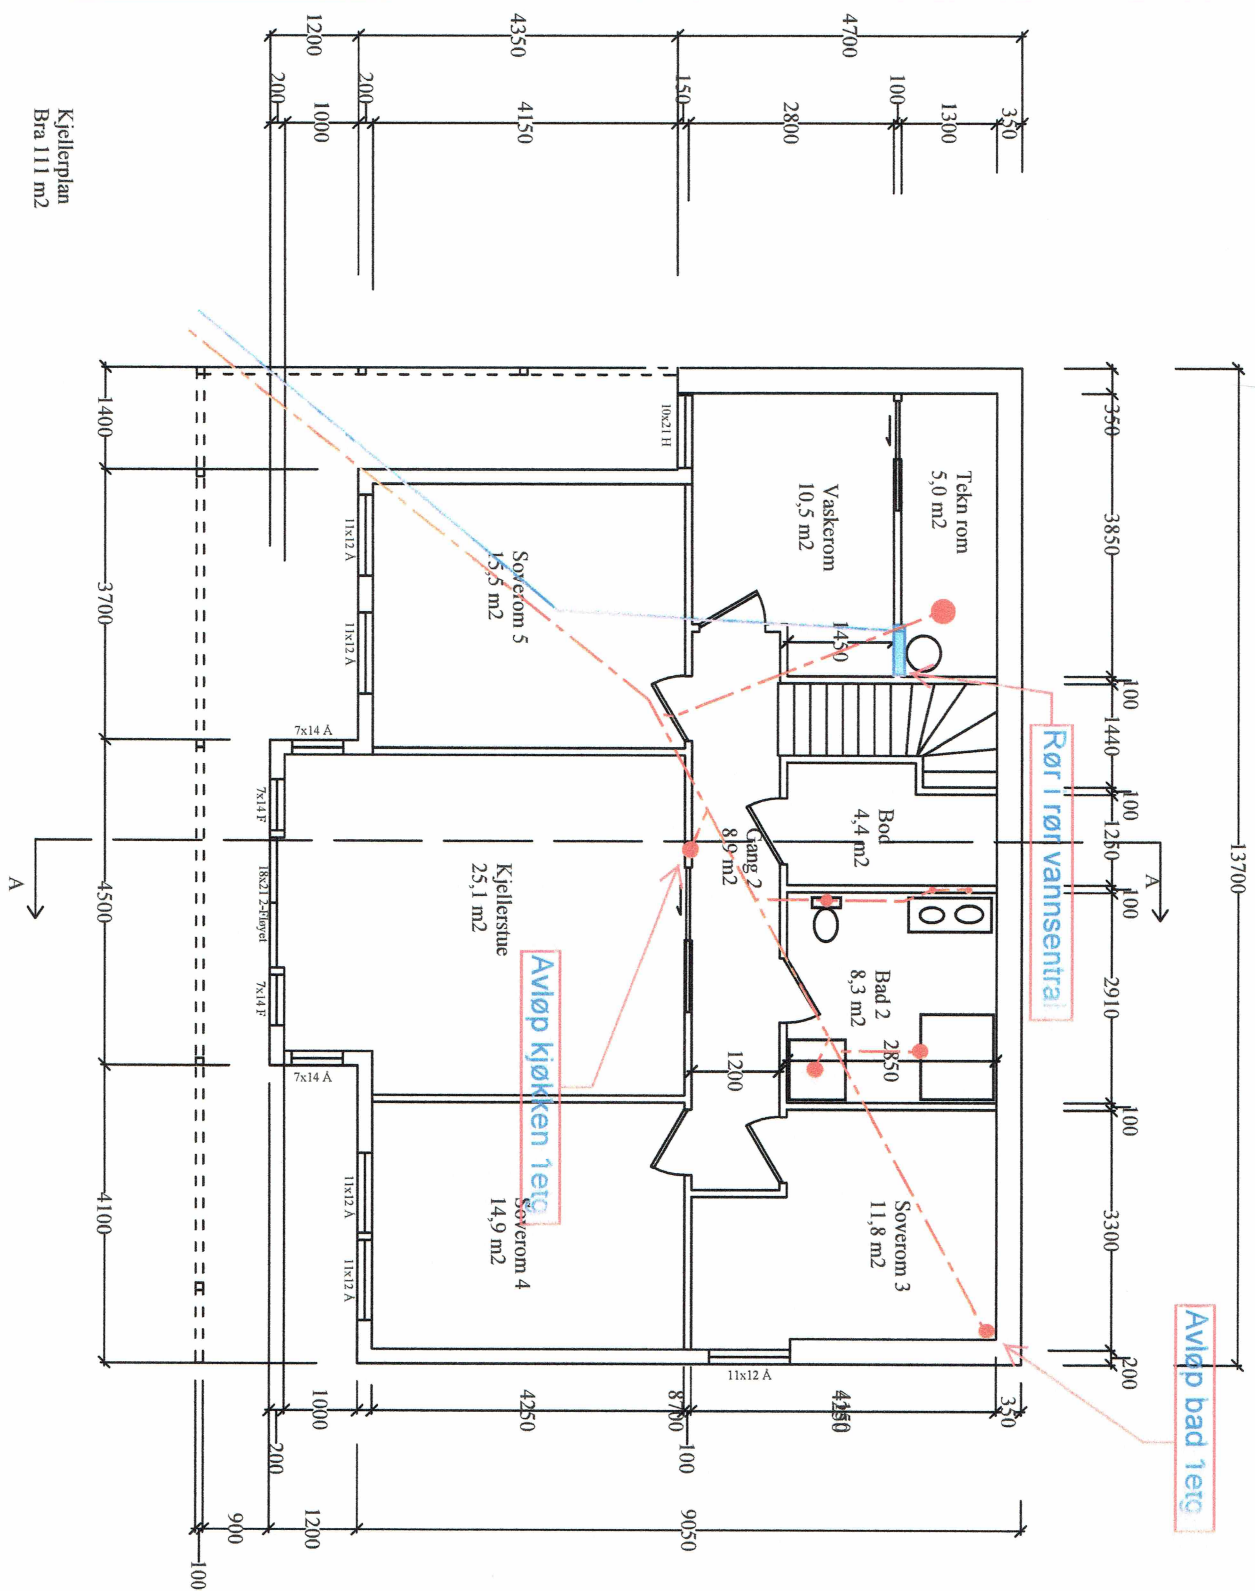

REV.	DATO	REVISJONEN GJELDER			SIGN.
Dato:	10.11.2016	Konstr. /Tegnet	Gnr./bnr:	Målestokk:	Tiltakshaver:
		DEH			Daniel Reknes
Tittel: Enebolig m/ garasje				1:100	
				Erstatning for:	Erstattet av:
Henvislning:		Beregning:		Format:	A4