


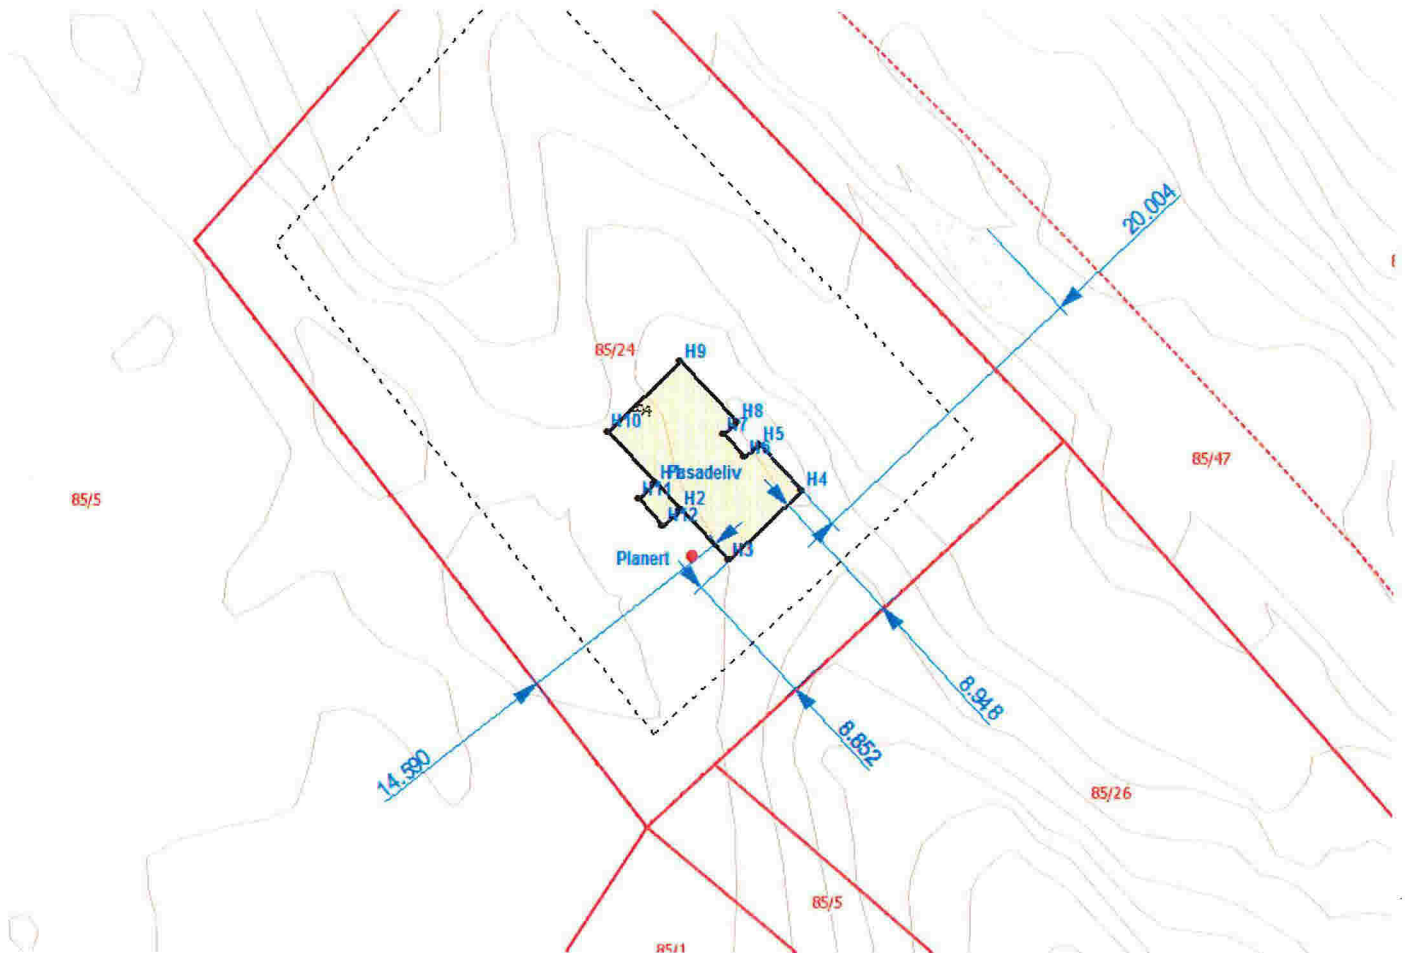

Lindås, gnr 85, bnr 24,  
Data på innmålt Fasadeliv

04.08.2016



| PunktID | N-koord.   | Ø-koord.  | Høyde |
|---------|------------|-----------|-------|
| H1      | 6736238,86 | 289921,45 |       |
| H2      | 6736237,20 | 289923,04 |       |
| H3      | 6736233,95 | 289926,14 |       |
| H4      | 6736238,44 | 289930,83 |       |
| H5      | 6736241,34 | 289928,04 |       |
| H6      | 6736240,50 | 289927,16 |       |
| H7      | 6736241,94 | 289925,78 |       |
| H8      | 6736242,78 | 289926,66 |       |
| H9      | 6736246,59 | 289923,01 |       |
| H10     | 6736242,11 | 289918,36 |       |
| H11     | 6736237,80 | 289920,35 |       |
| H12     | 6736236,14 | 289921,94 |       |
| Planert | 6736234,16 | 289923,84 | 37,34 |