


04.01.2017

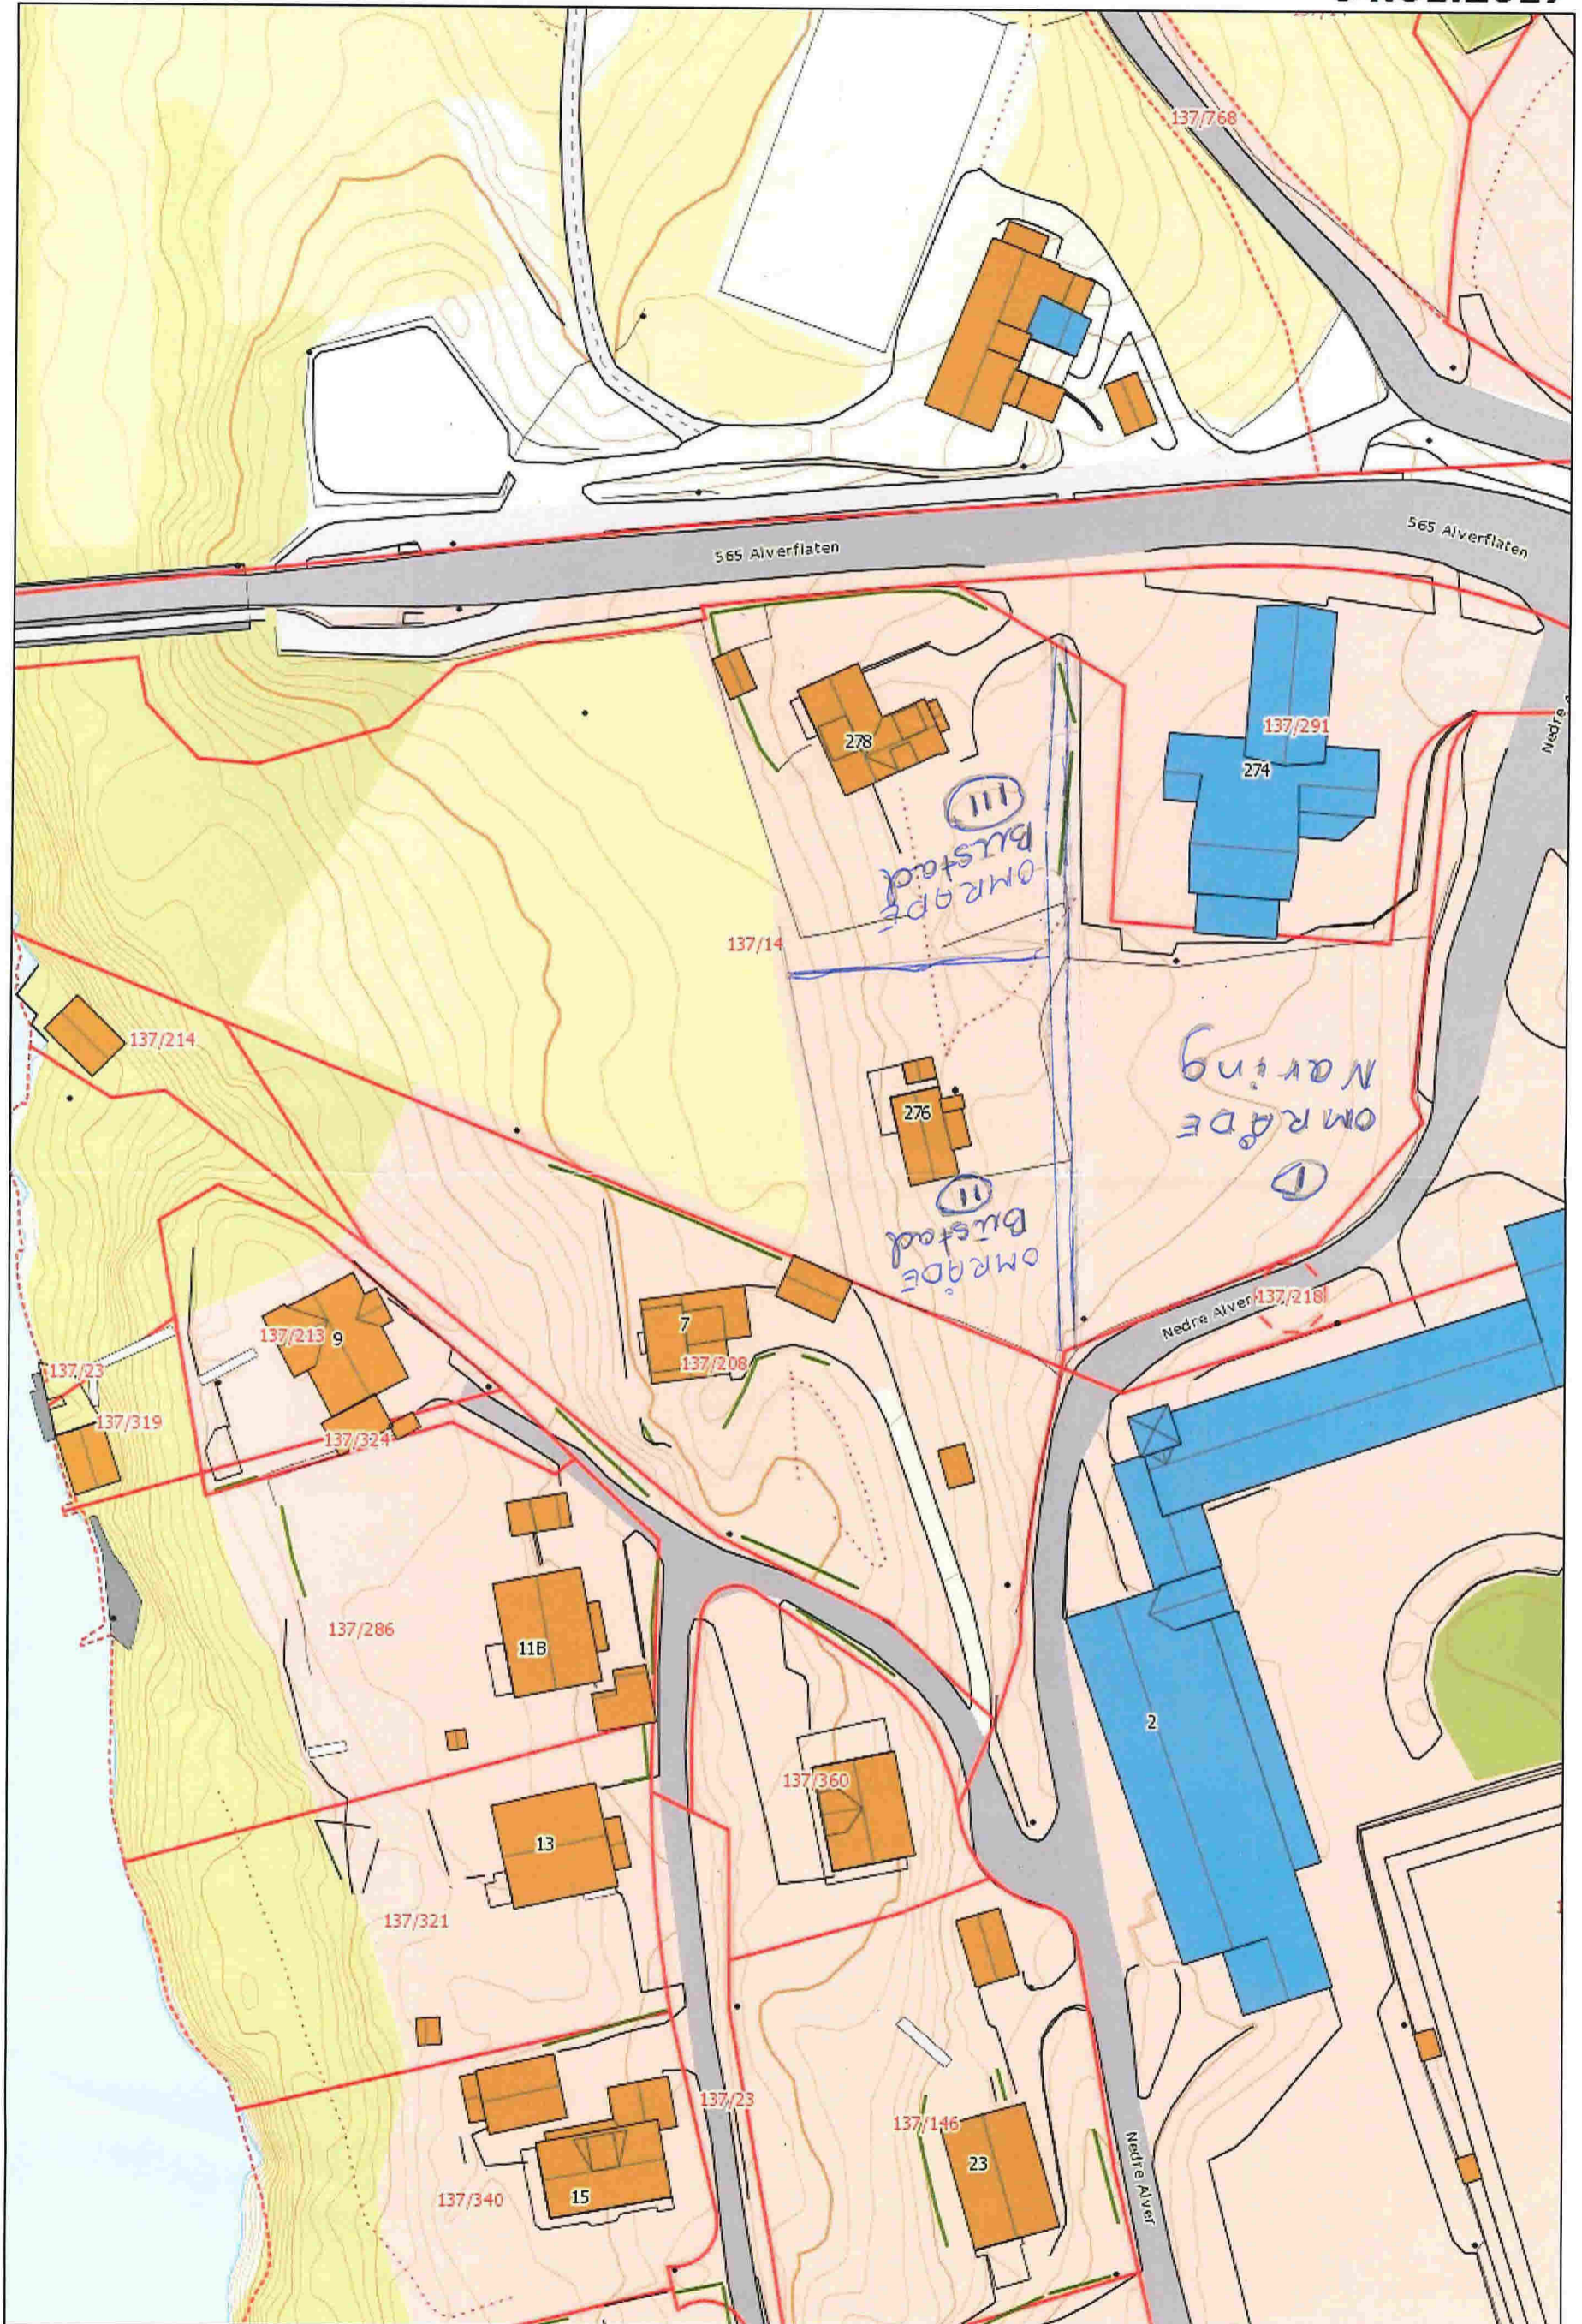

Målestokk: 1:708