
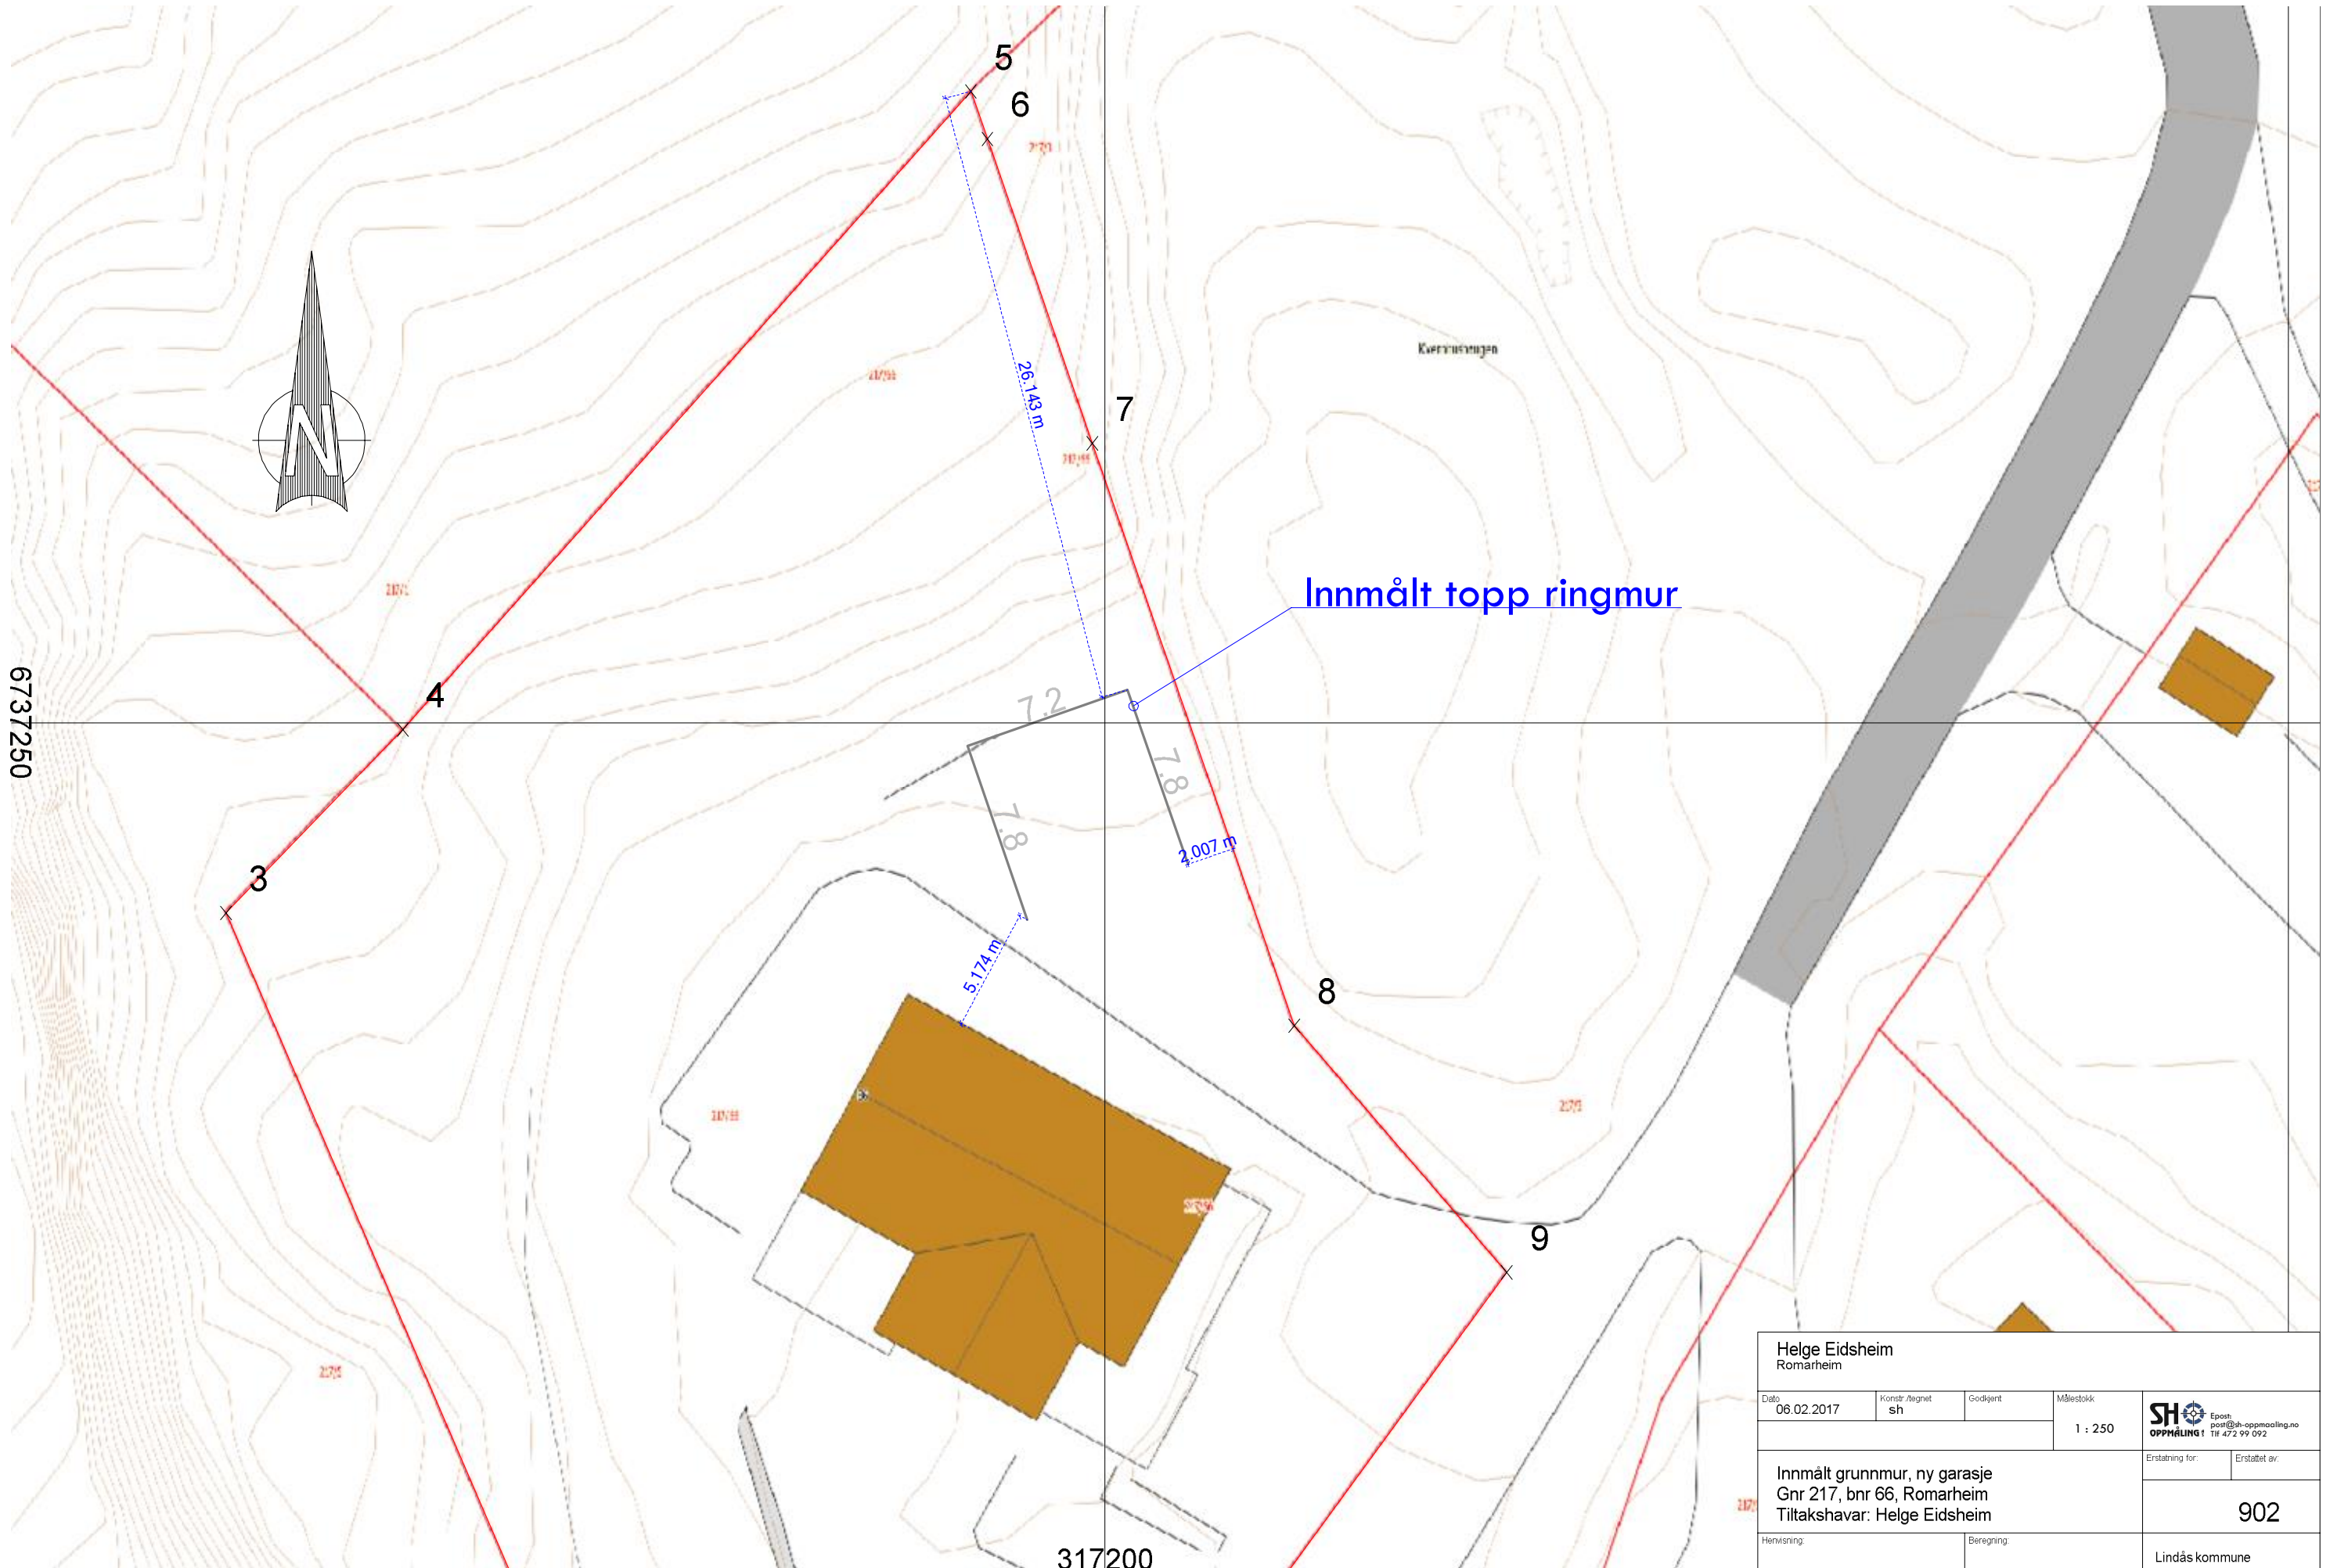


6737250

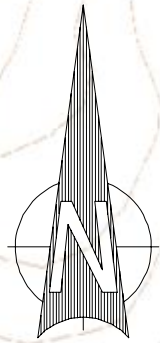

Helge Eidsheim Romarheim			
Dato 06.02.2017	Konstr. Ægnet sh	Godkjent	Målestokk 1 : 250
Innmålt grunnmur, ny garasje Gnr 217, bnr 66, Romarheim Tiltakshavar: Helge Eidsheim			SH Oppmåling 1 Espen post@sh-oppmaling.no Tlf 472 99 092
Erstatning for:		Erstatet av:	
		902	
Henvisning:		Beregning:	
Lindås kommune			