
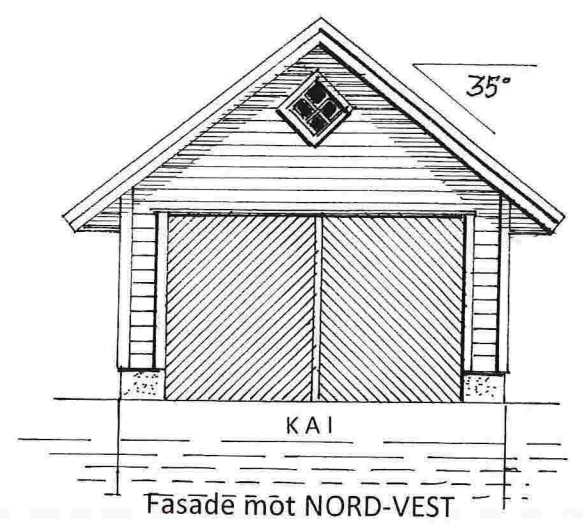
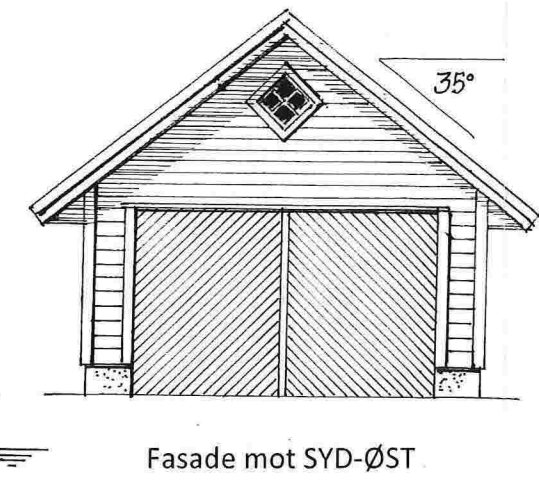
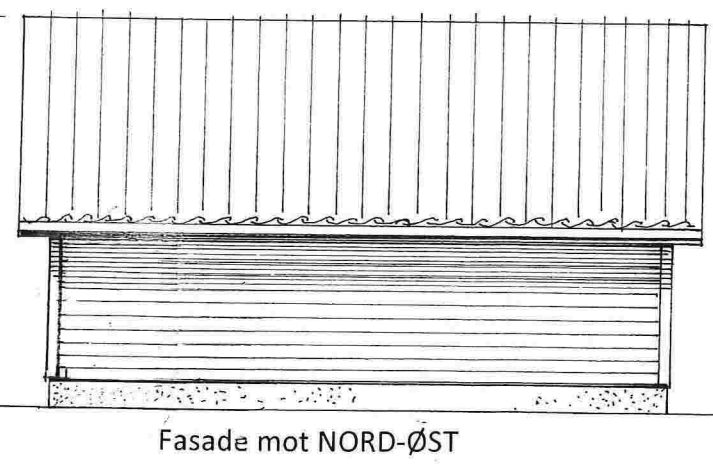
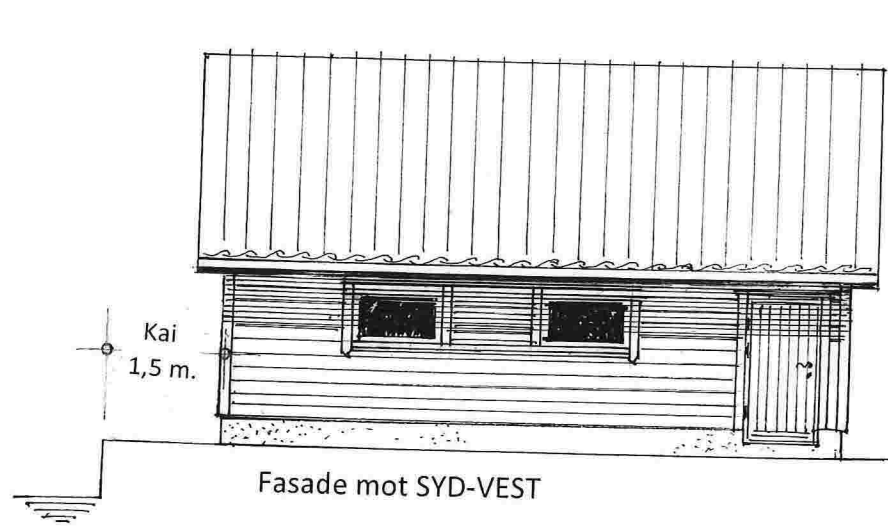
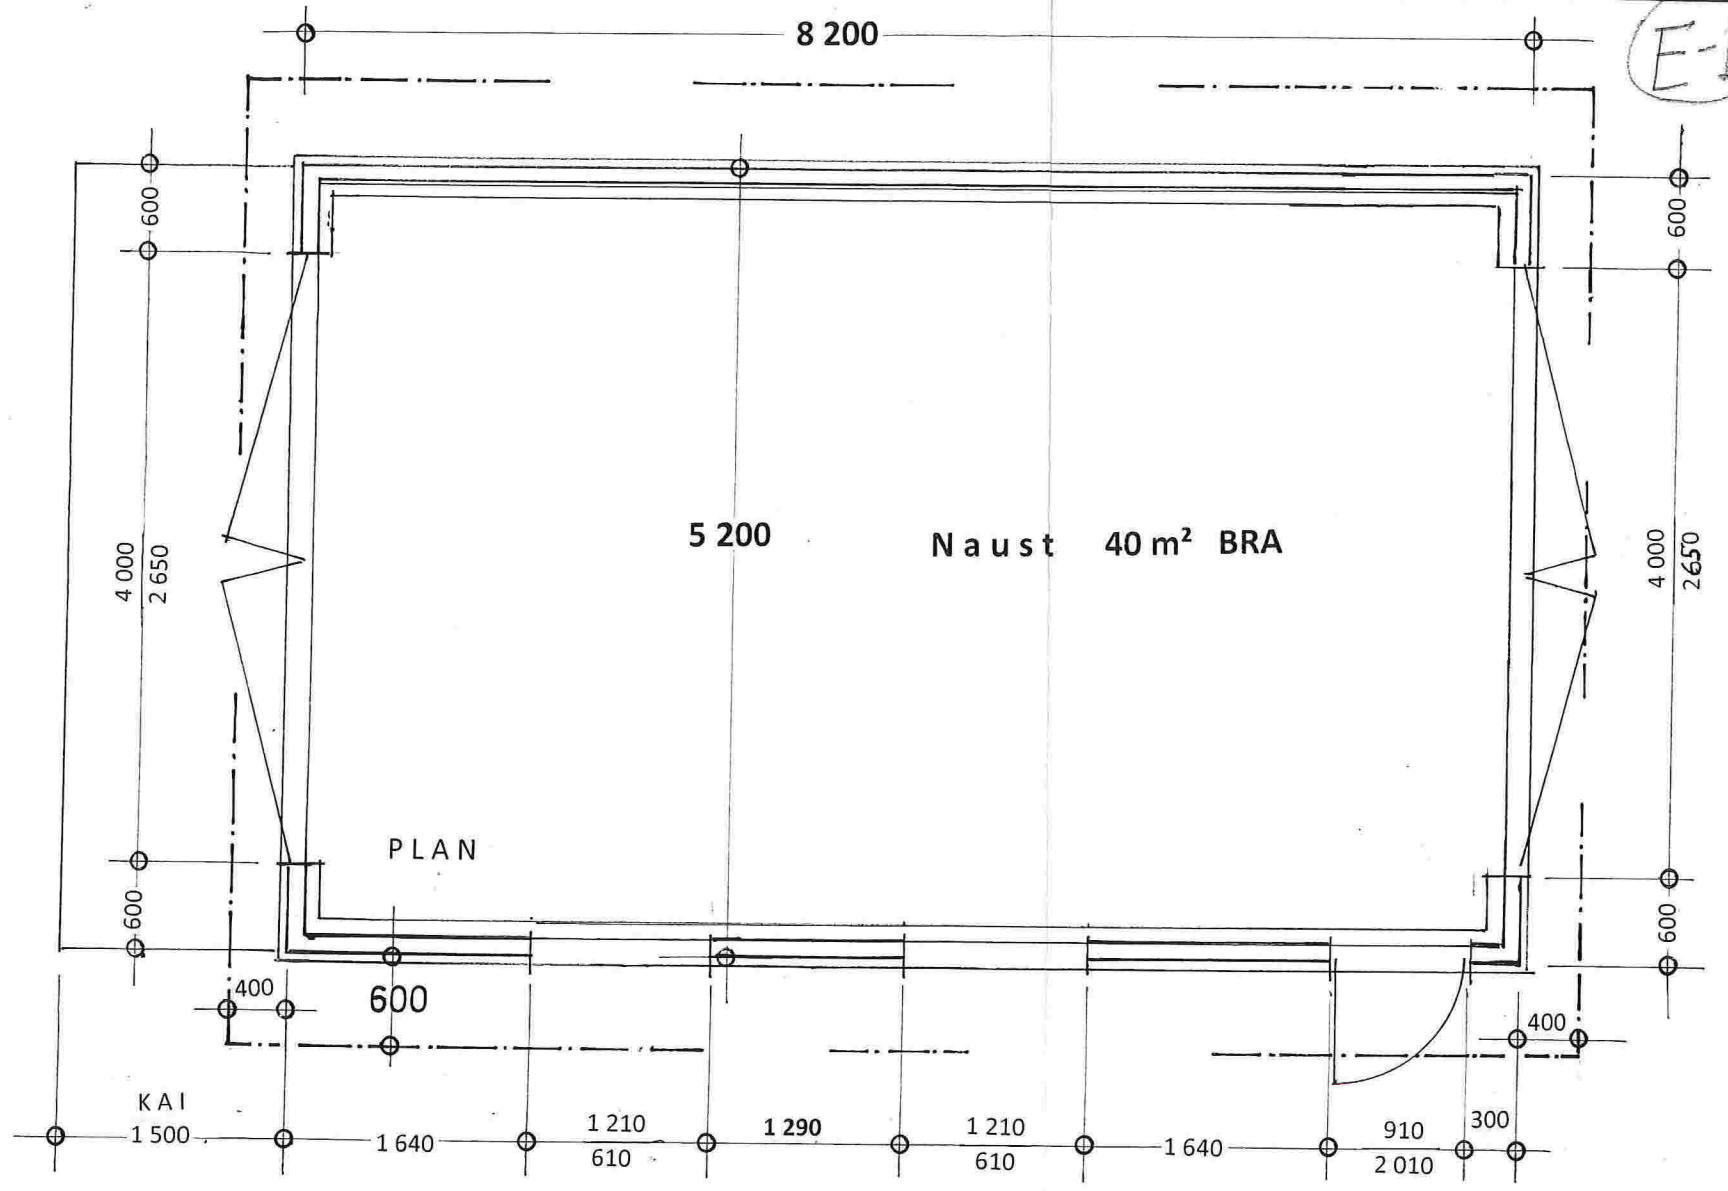


E-1

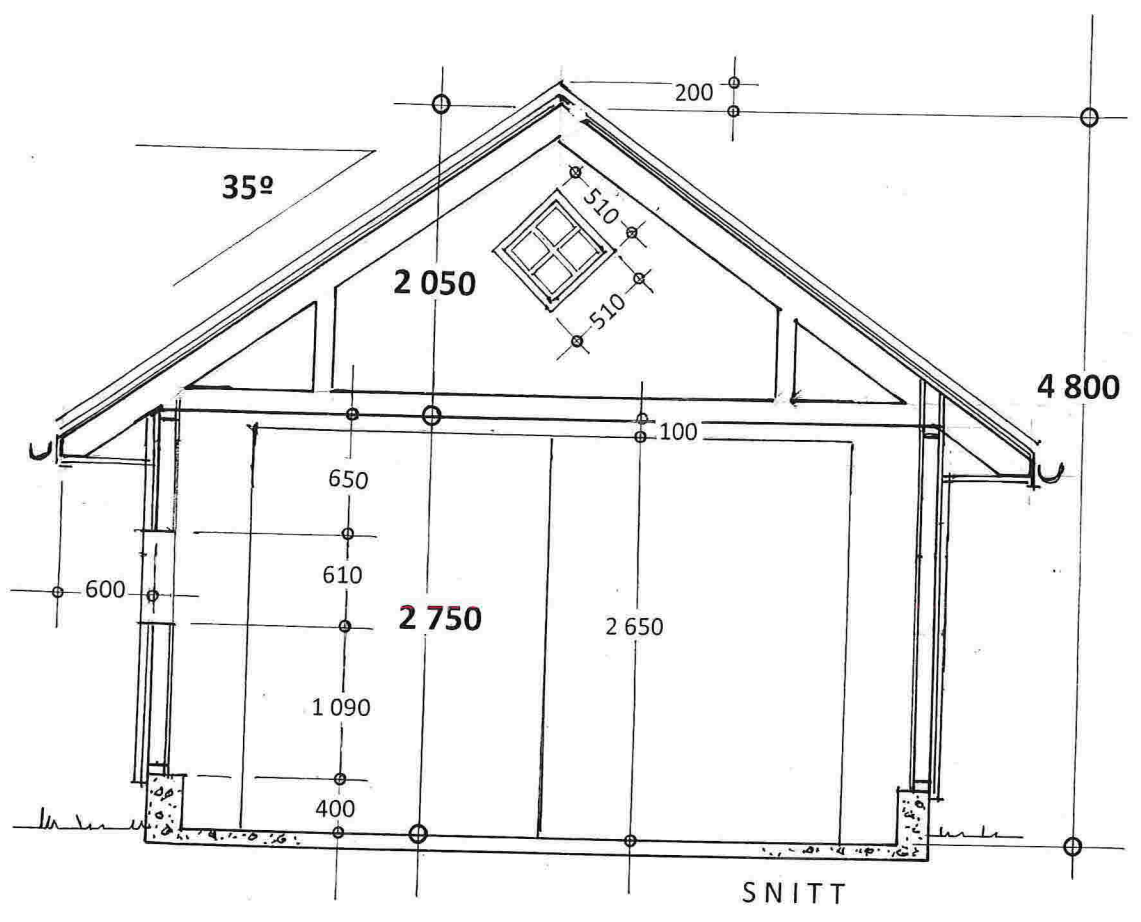

Prosj. naust på gnr. 123 , bnr. 189 i Lindås kommune
Tiltakshaver : Ove Kåre Risa

Plan – og Snitt i Mål = 1 :50 , Fasader i Mål = 1:100

Seim , 11. 03. 2017 , Arkitekt Knut Willie Jacobsen
Rettet: 14. 03. 2017