


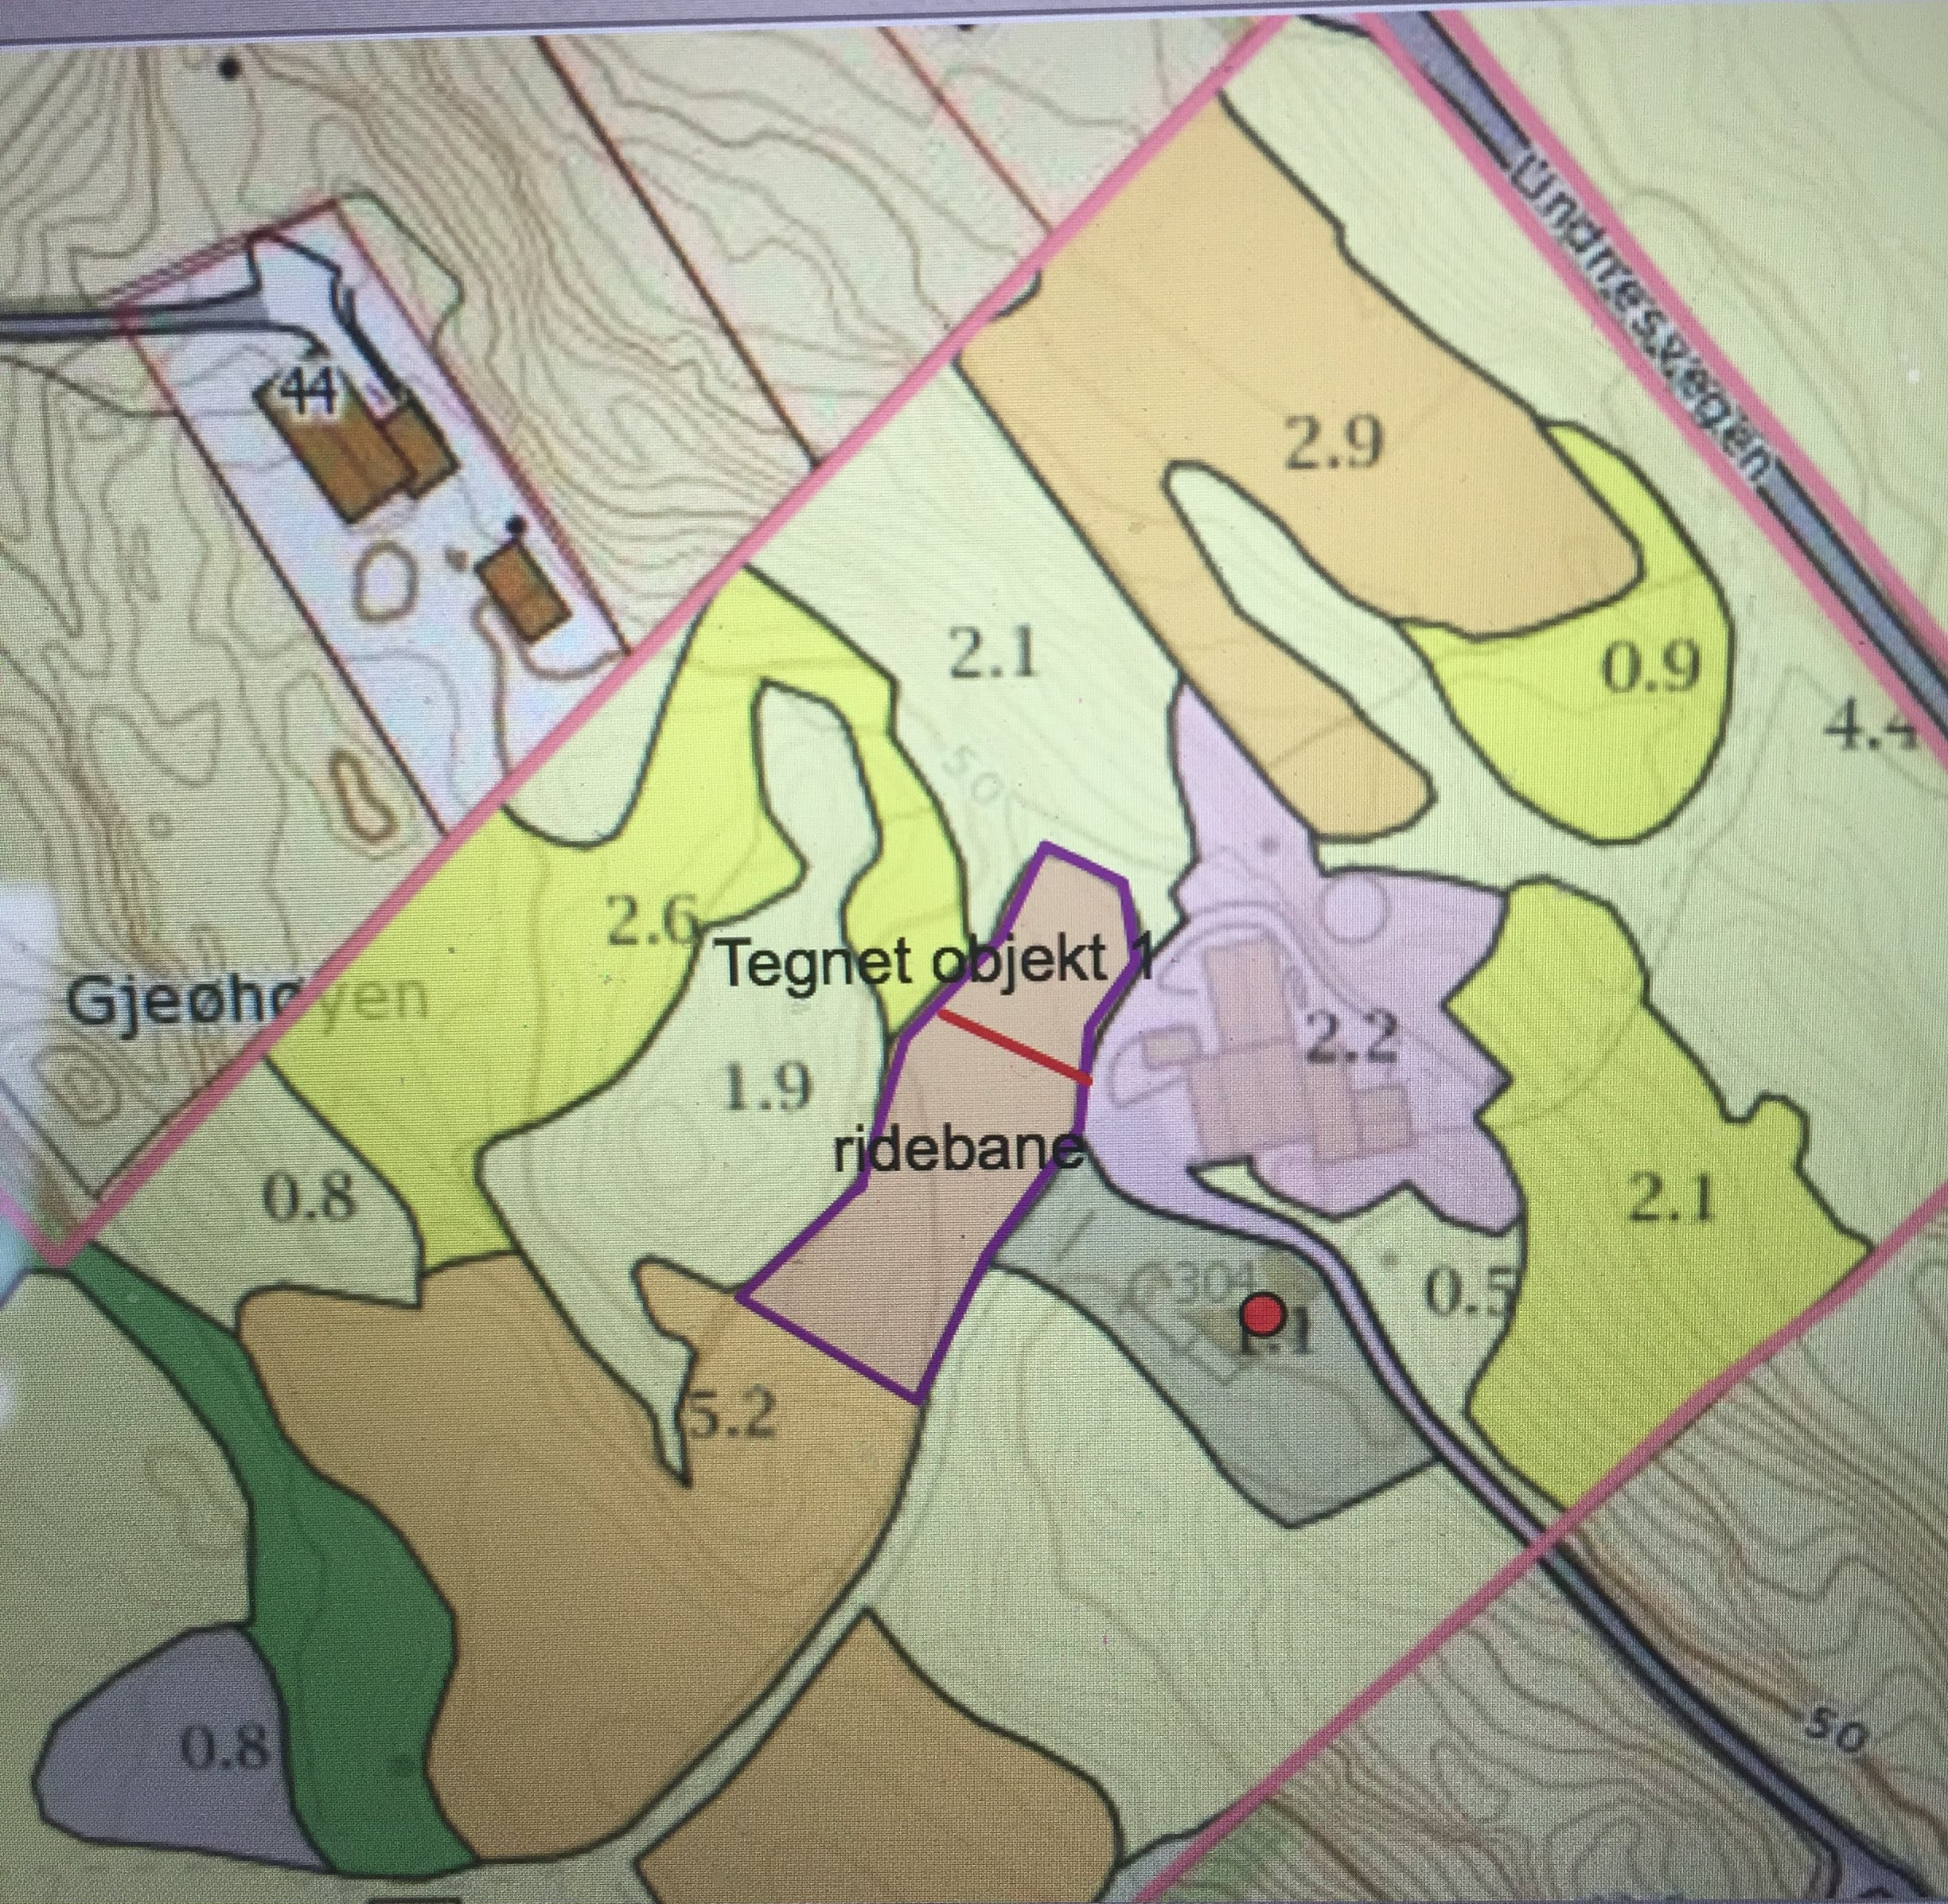

Legg til ▼



1... Innma... Skog, ... Skog, ... Skog, ... Skog, ... Uprod... My
beite høy b... høy b... midde... lav bo... skog