


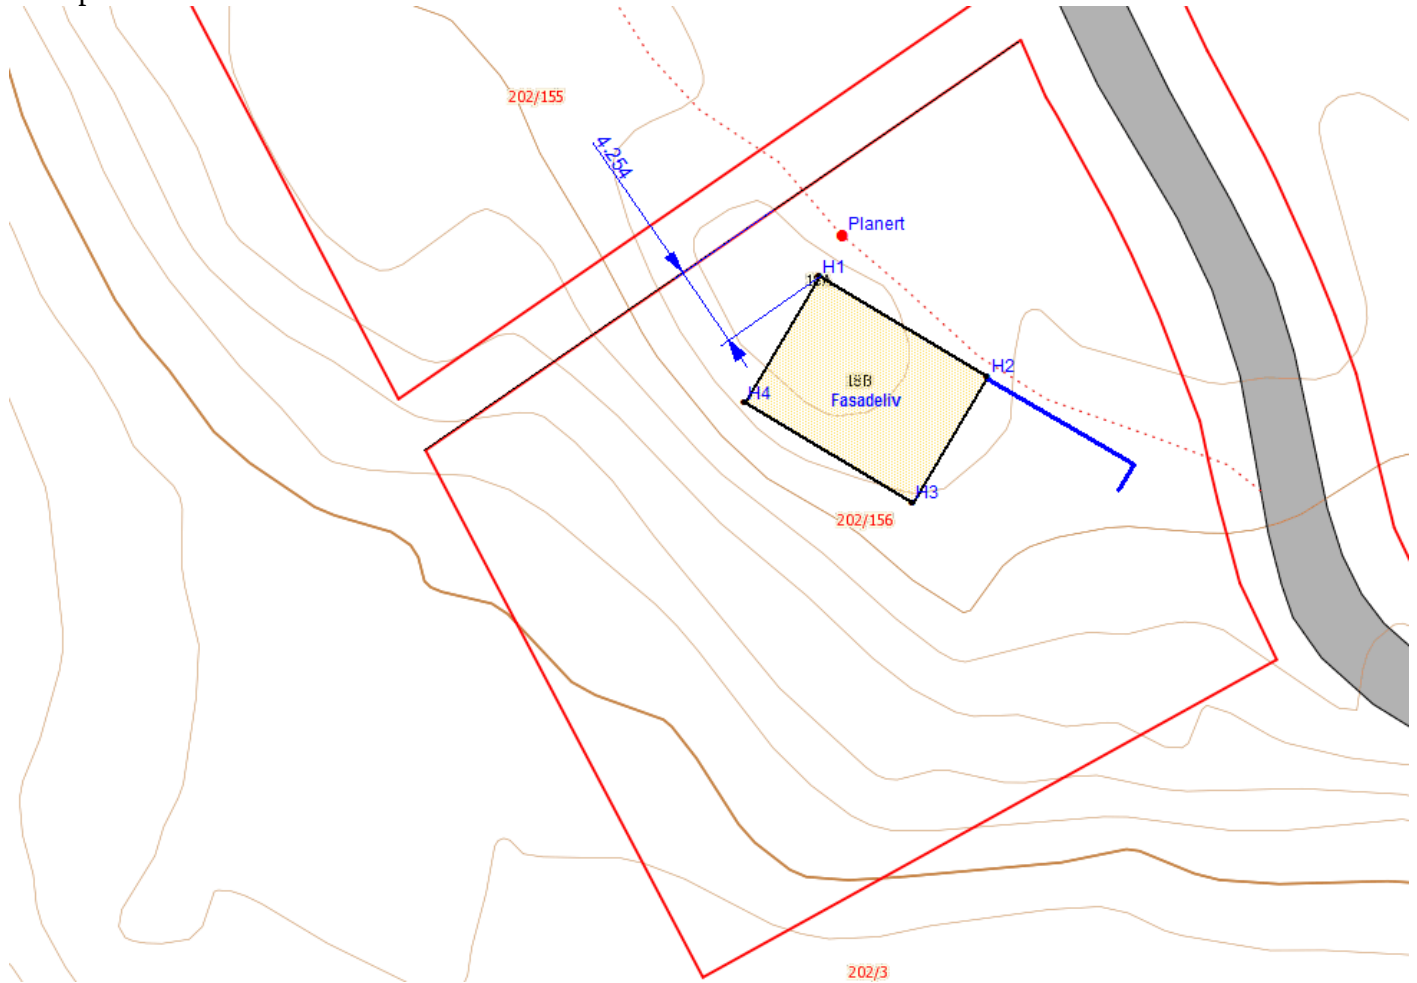

Lindås, gnr 202 bnr 156,
Data på innmålt fasadeliv

14.12.2016



PunktID	N-koord.	Ø-koord.	Høyde
H1	6722583,22	300518,83	
H2	6722578,04	300527,61	
H3	6722571,47	300523,71	
H4	6722576,67	300514,95	

Høyde planert: Kote +55,65

Planert	6722585,32	300520,07	55,65
---------	------------	-----------	-------