


1


12.04.2017

© www.avinet.no

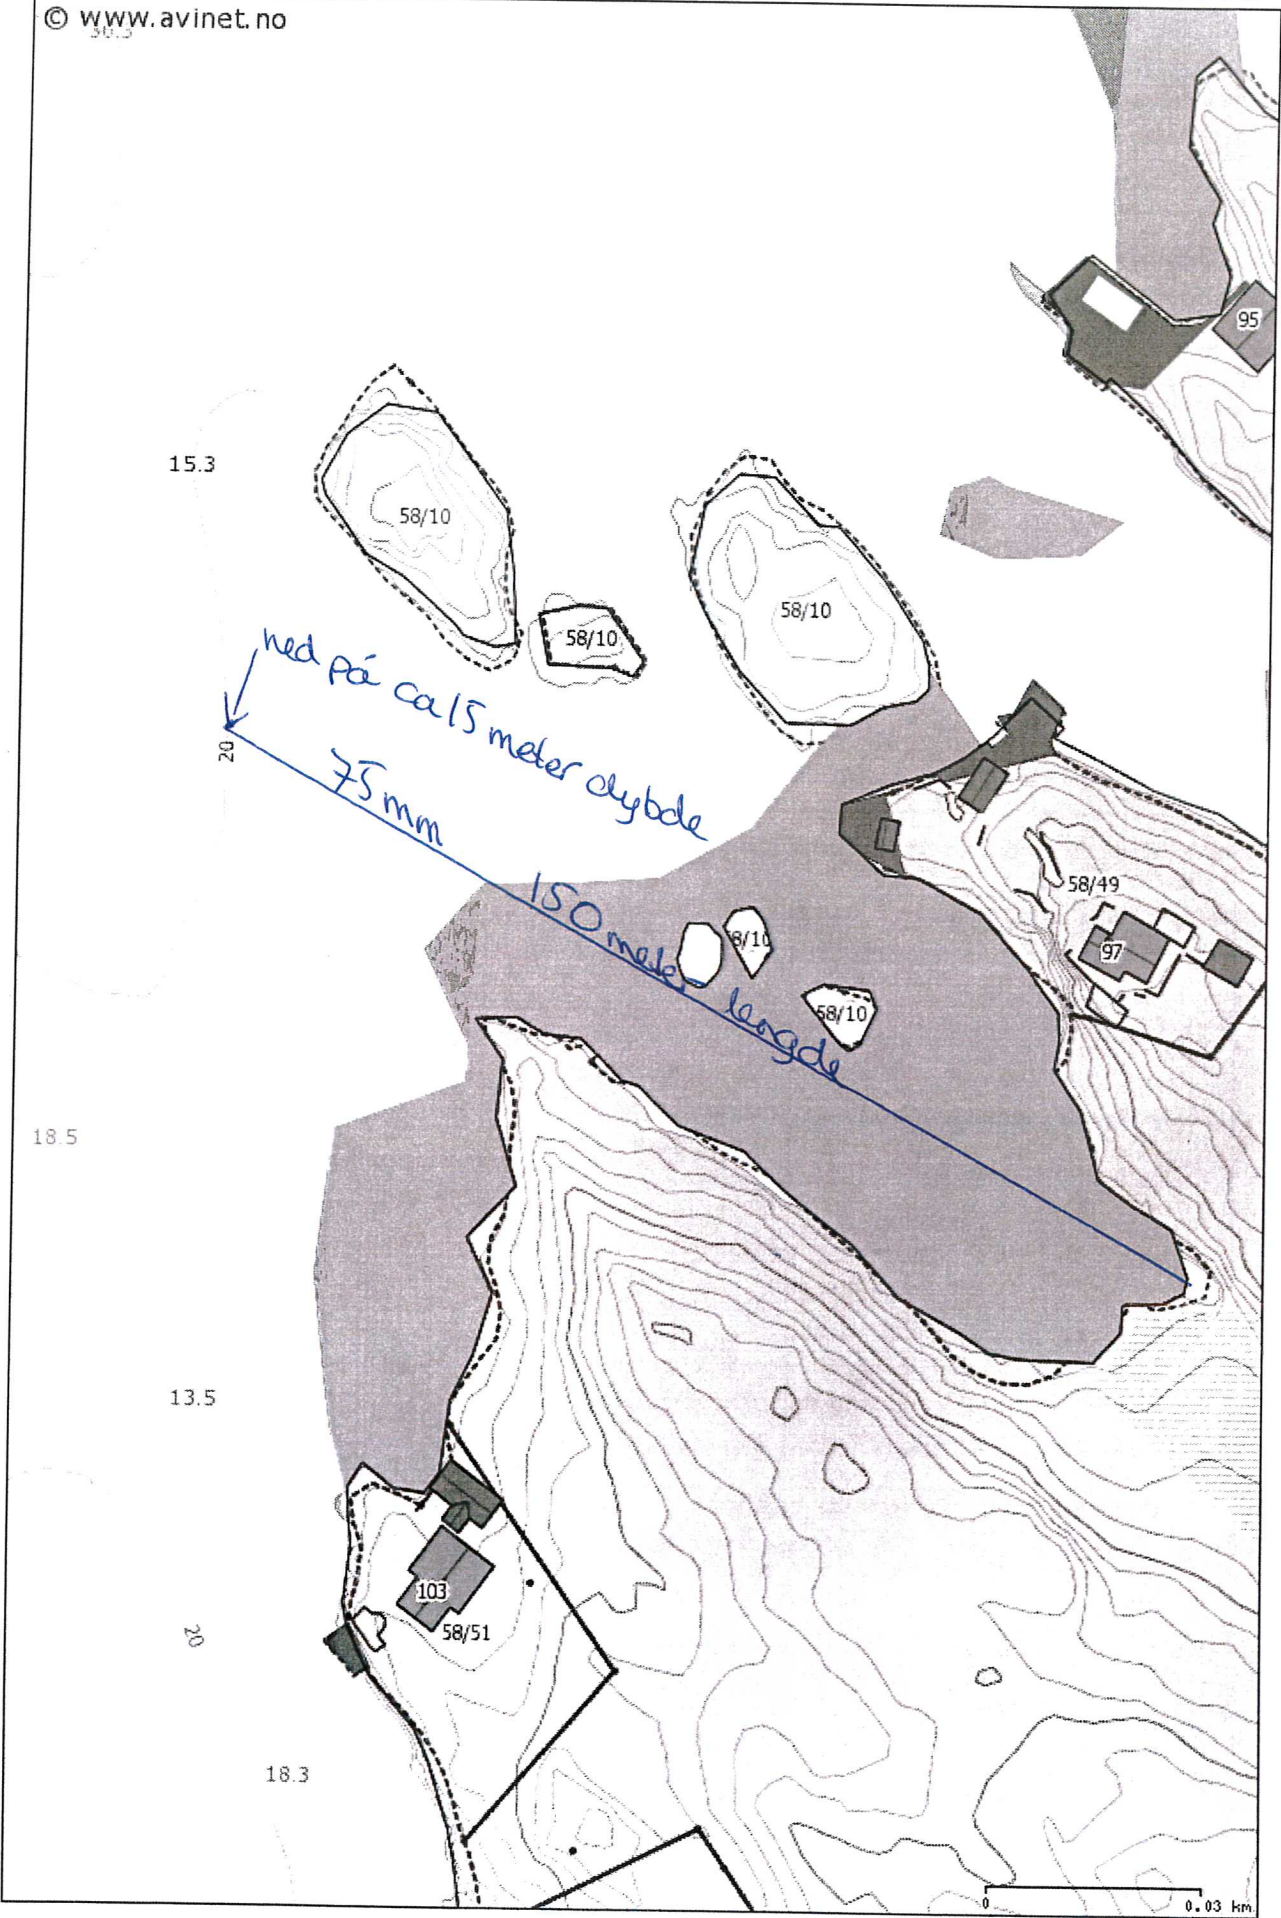

Målestokk: 1:1 000


12.04.2017

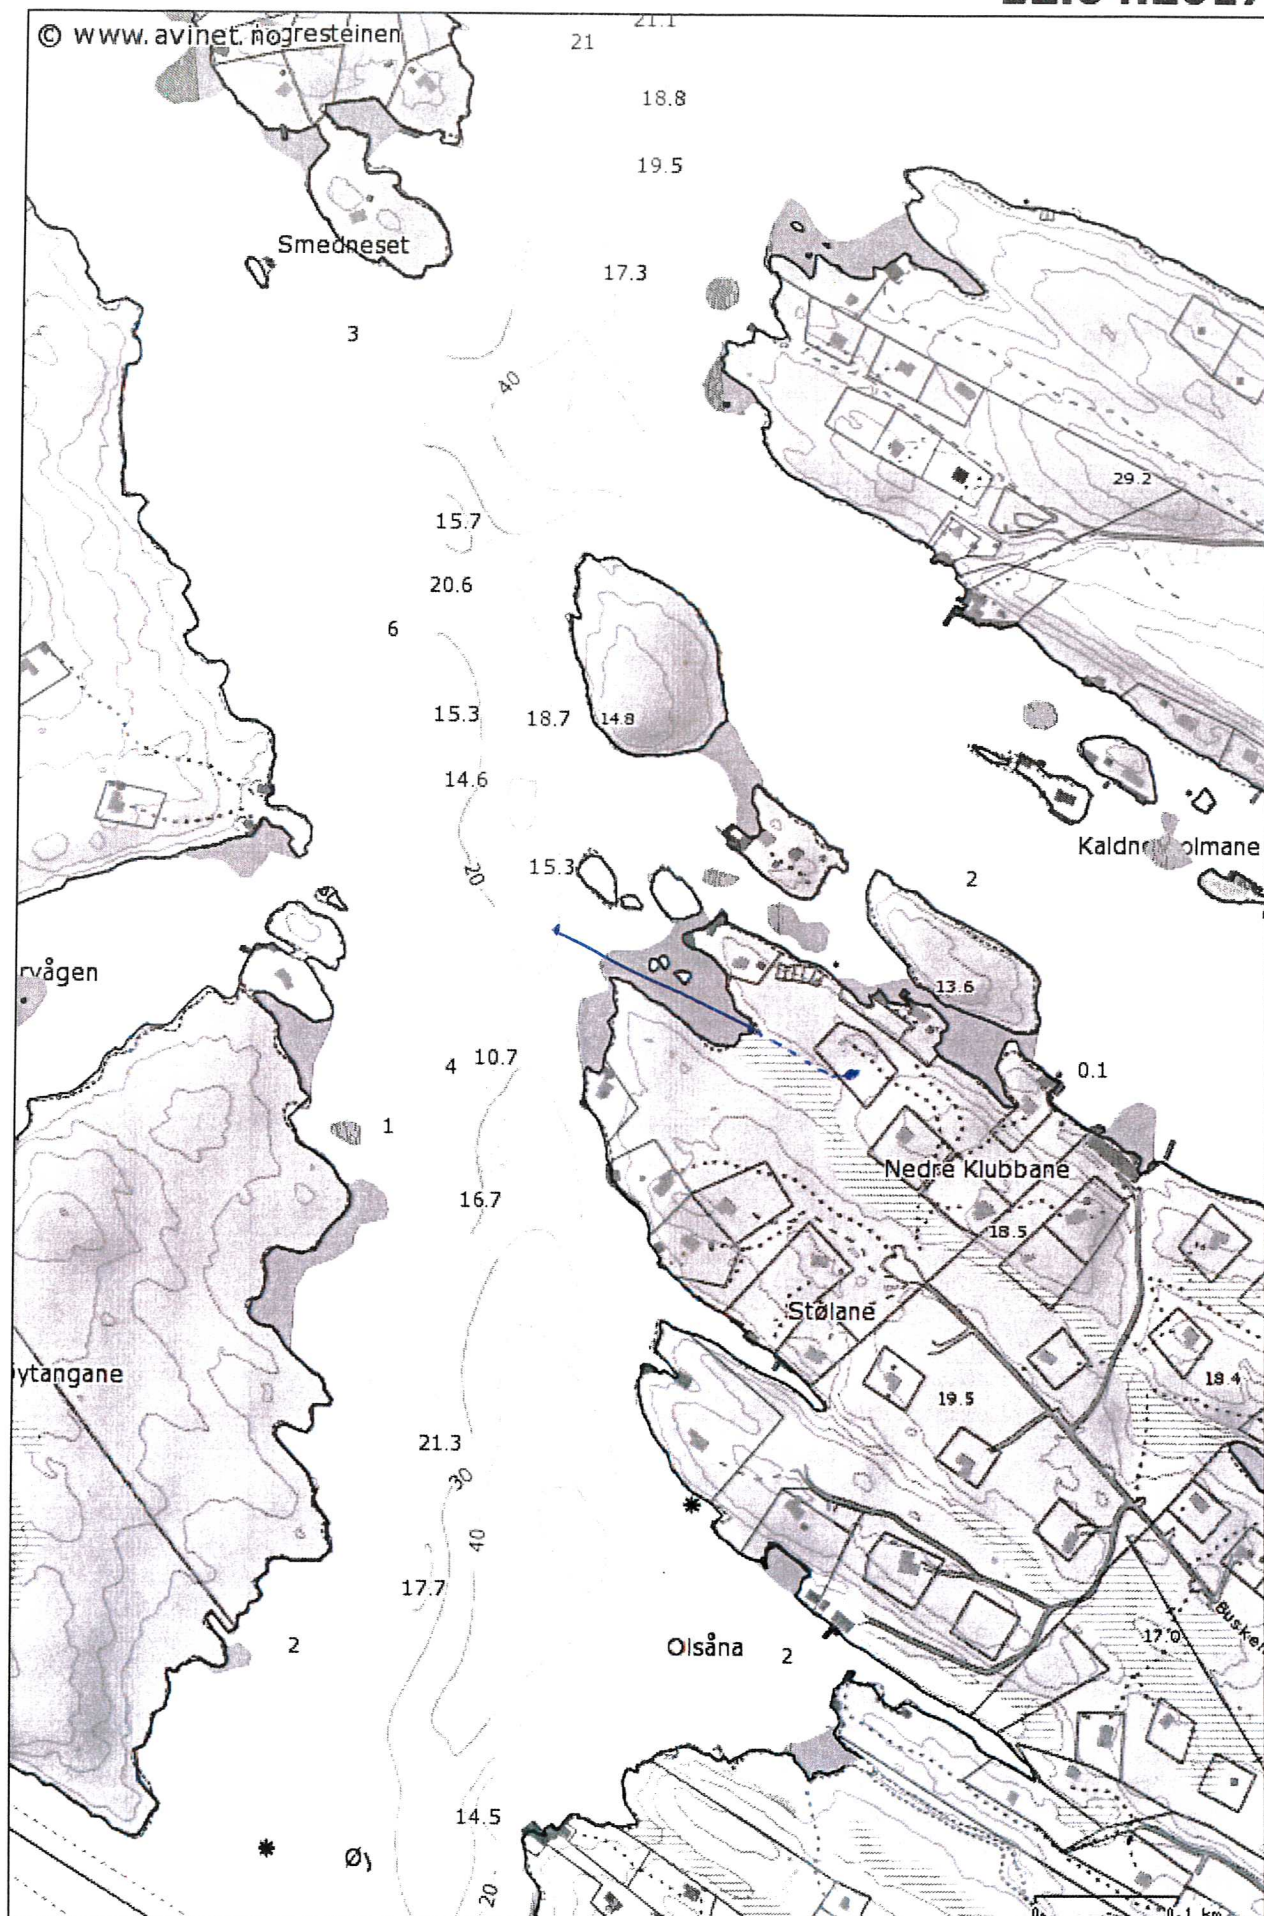

Målestokk: 1:5 000

(3)

19.04.2017

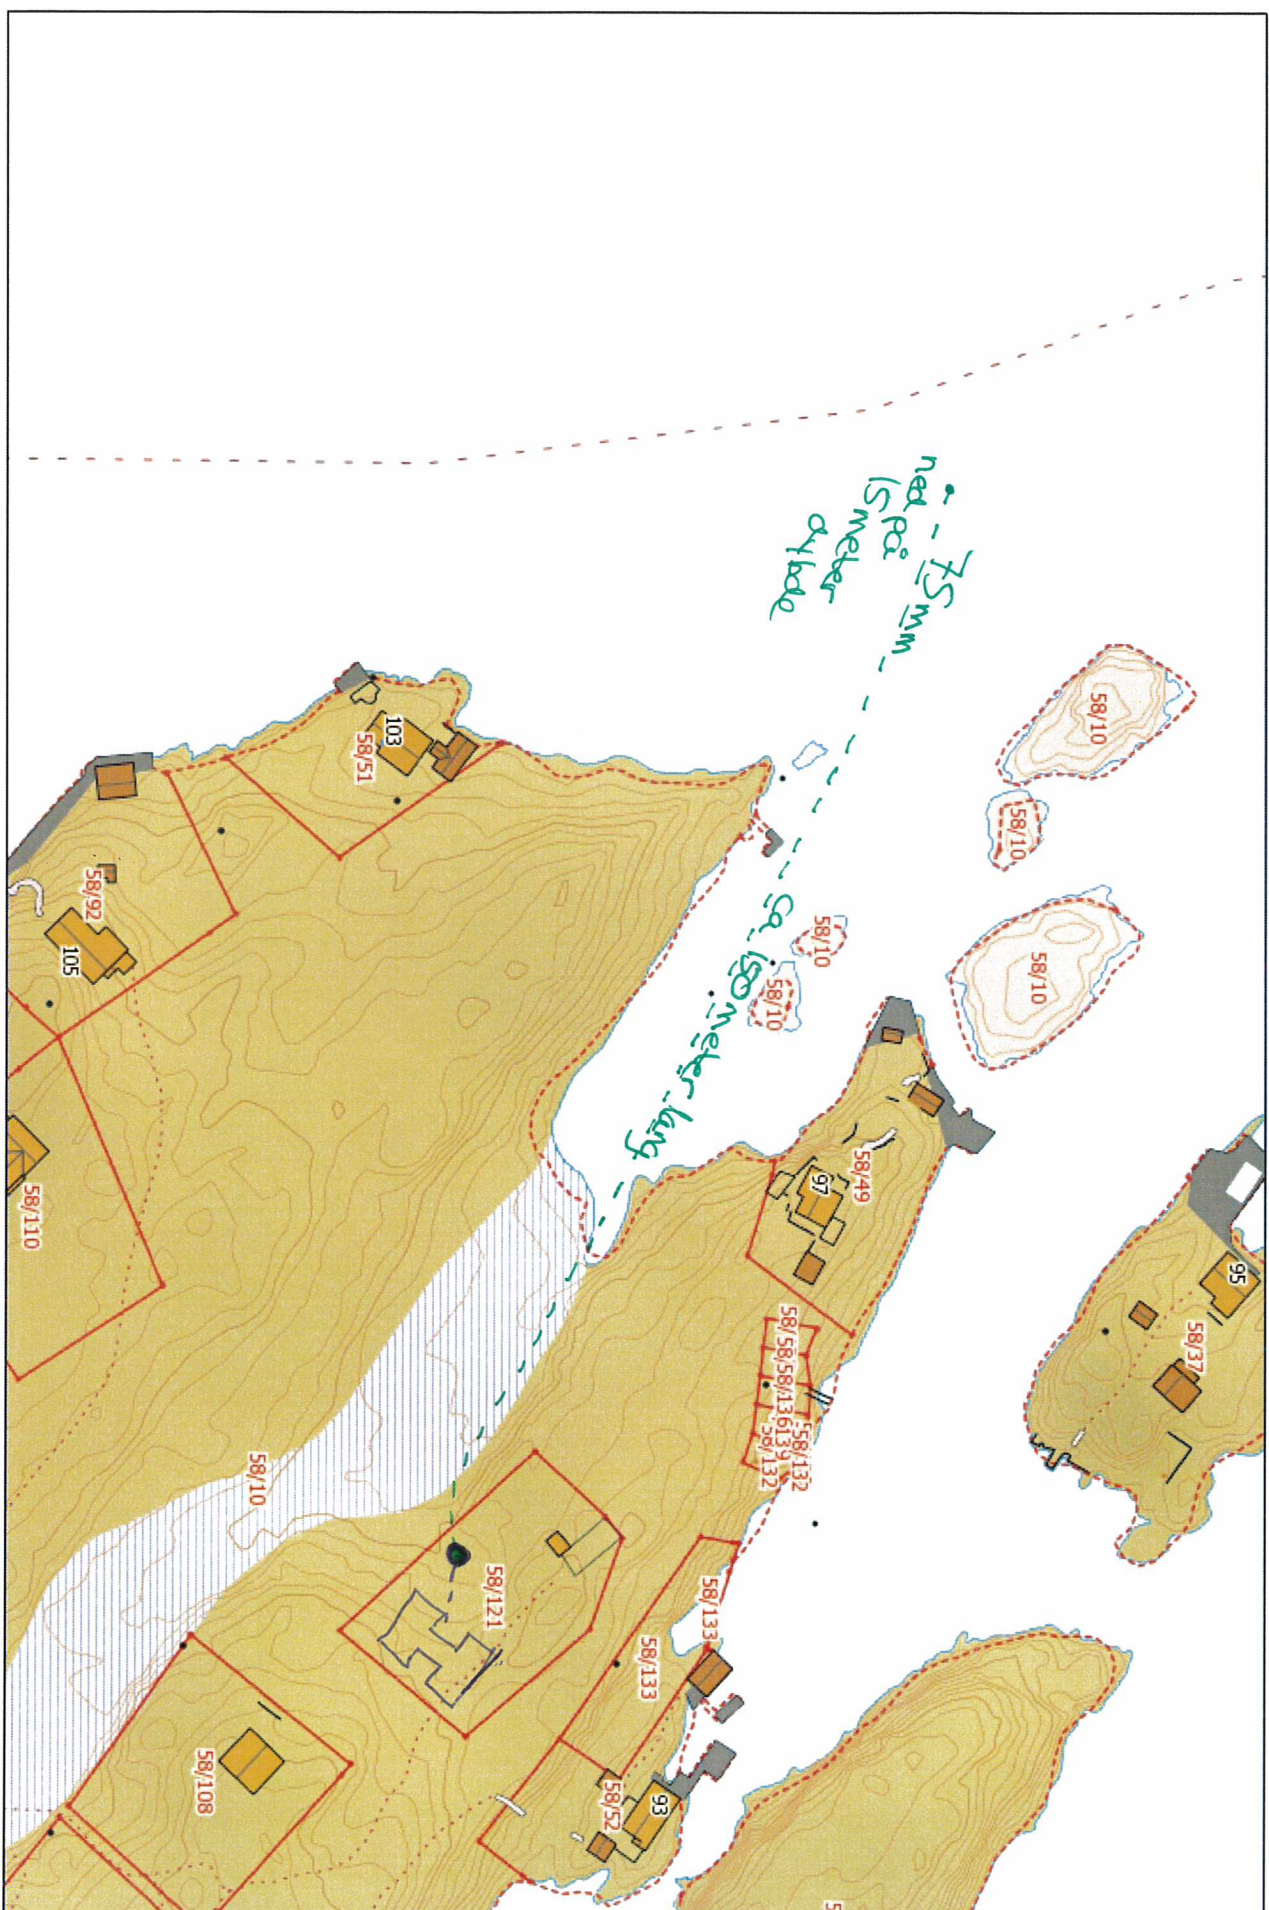

② = 4 m³ skumstiller