

façade West

Verasvegen 36  







Yngve Njotun

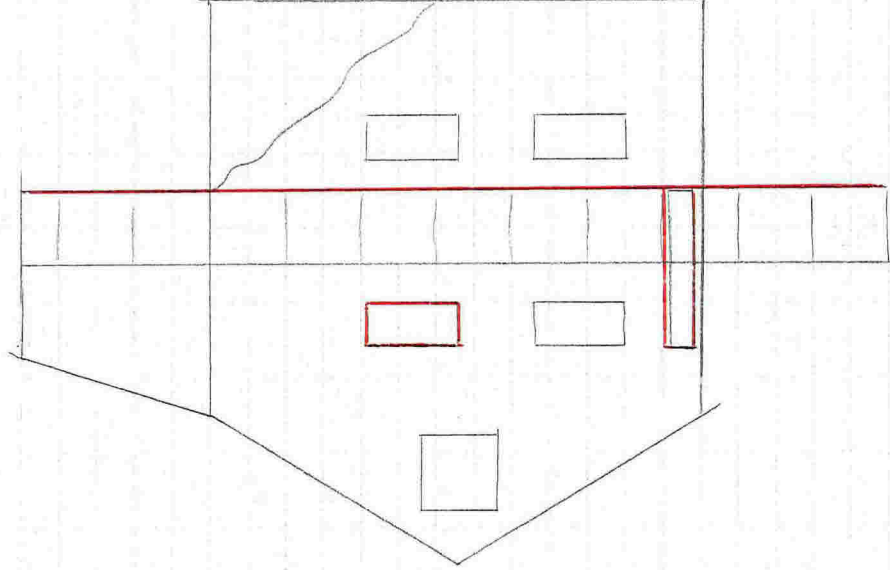

Fassade Sør




