



Feil på veilyskabel.

Ole O Dyrkolbotn
Anleggsleder

BKK EnoTek AS
Postboks 7050, 5020 Bergen
T: 55128179 M:95179353
Ole.Dyrkolbotn@bkk.no

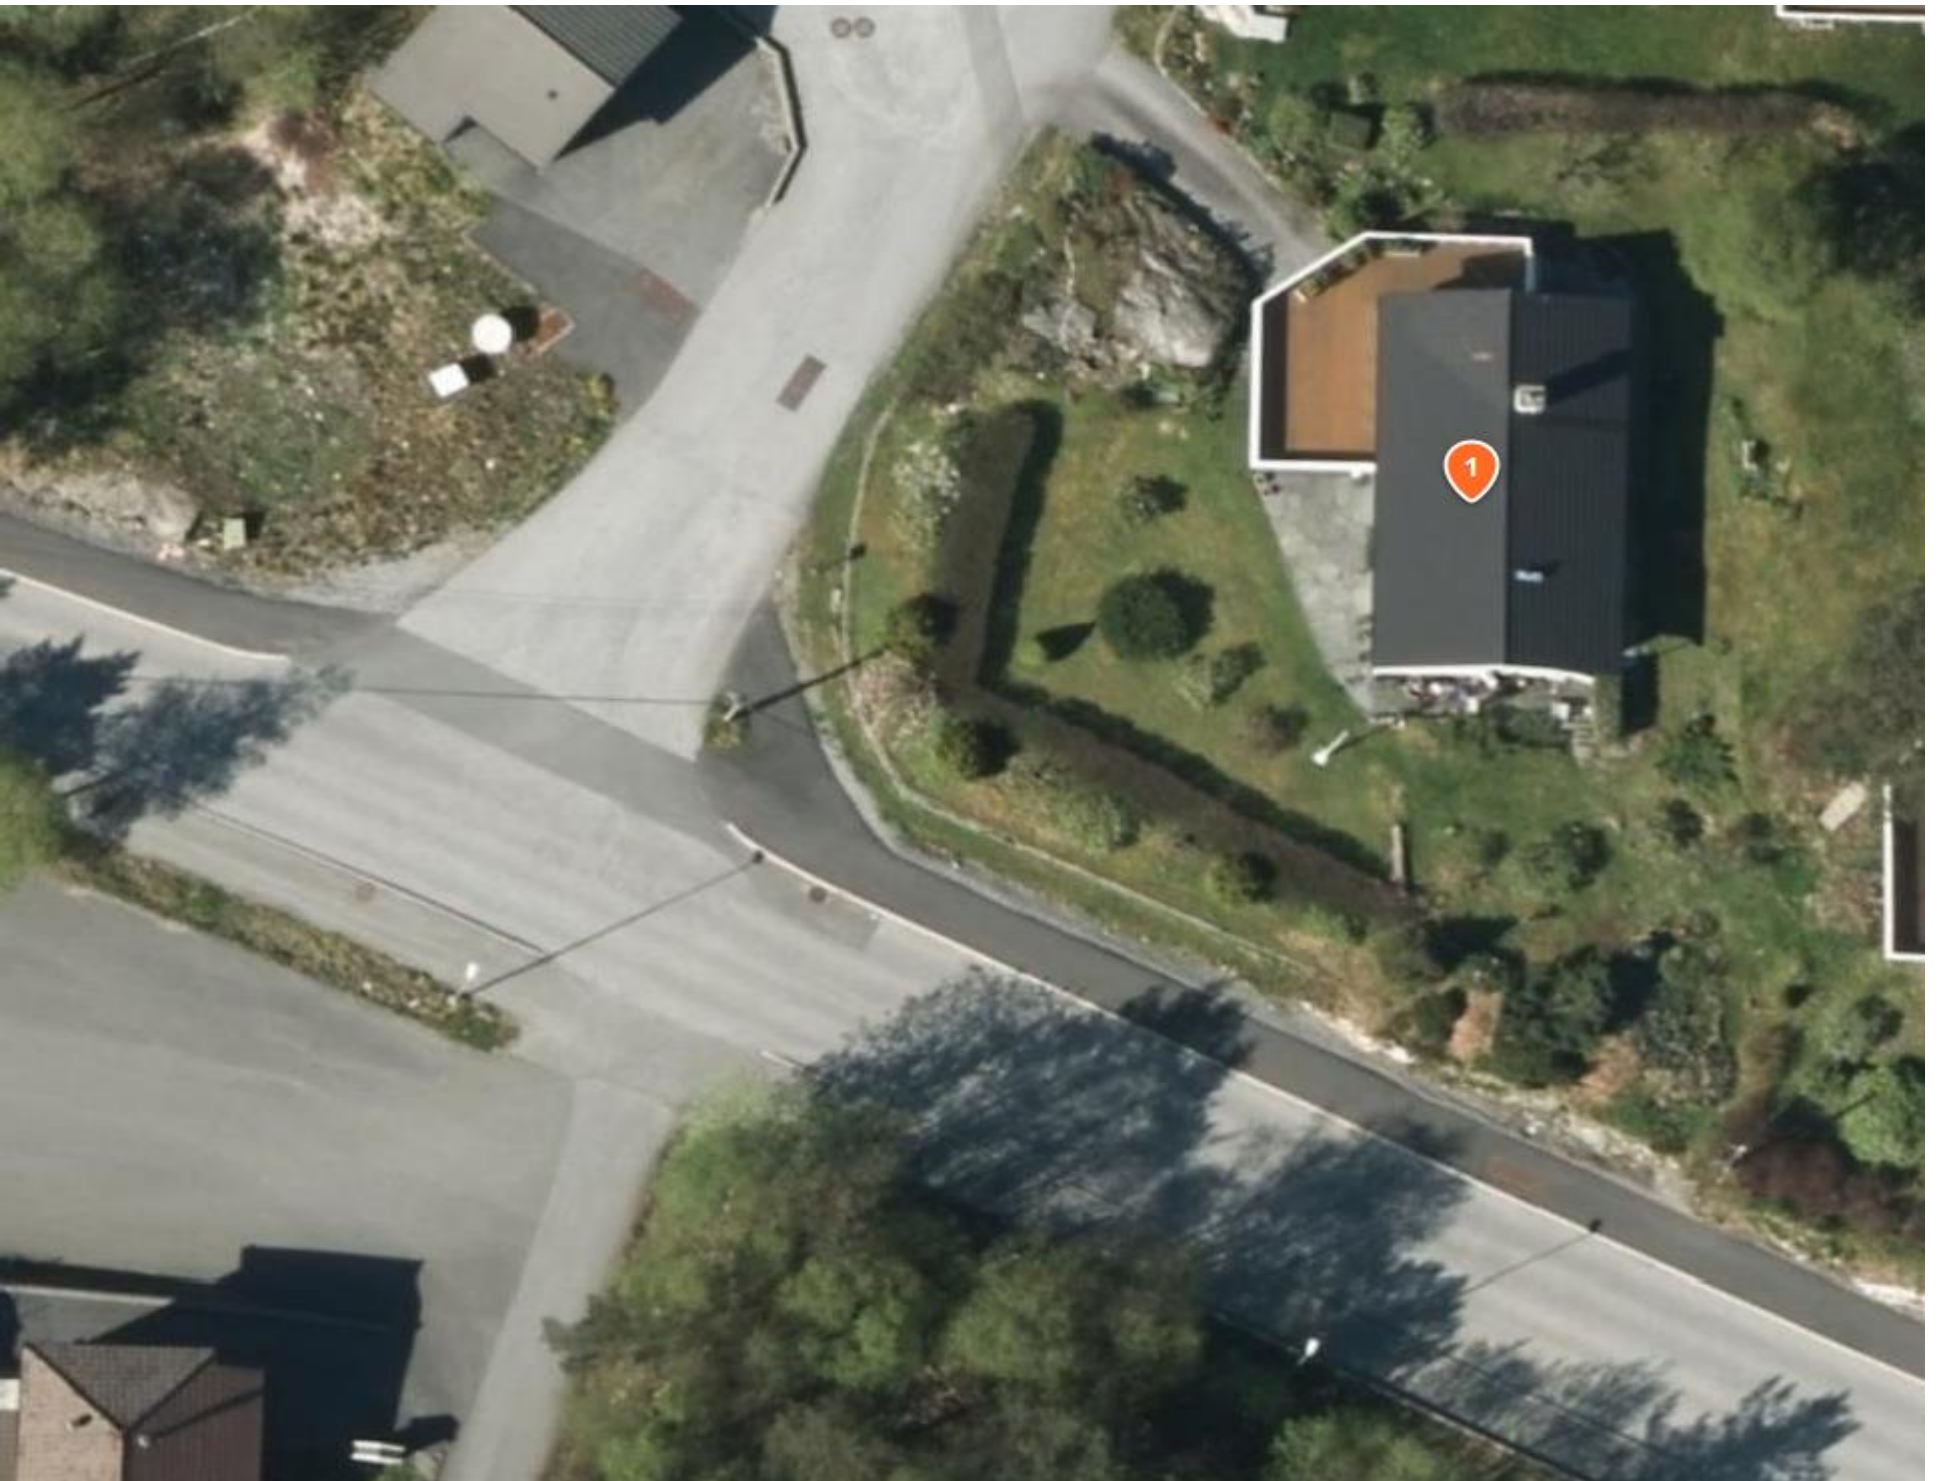

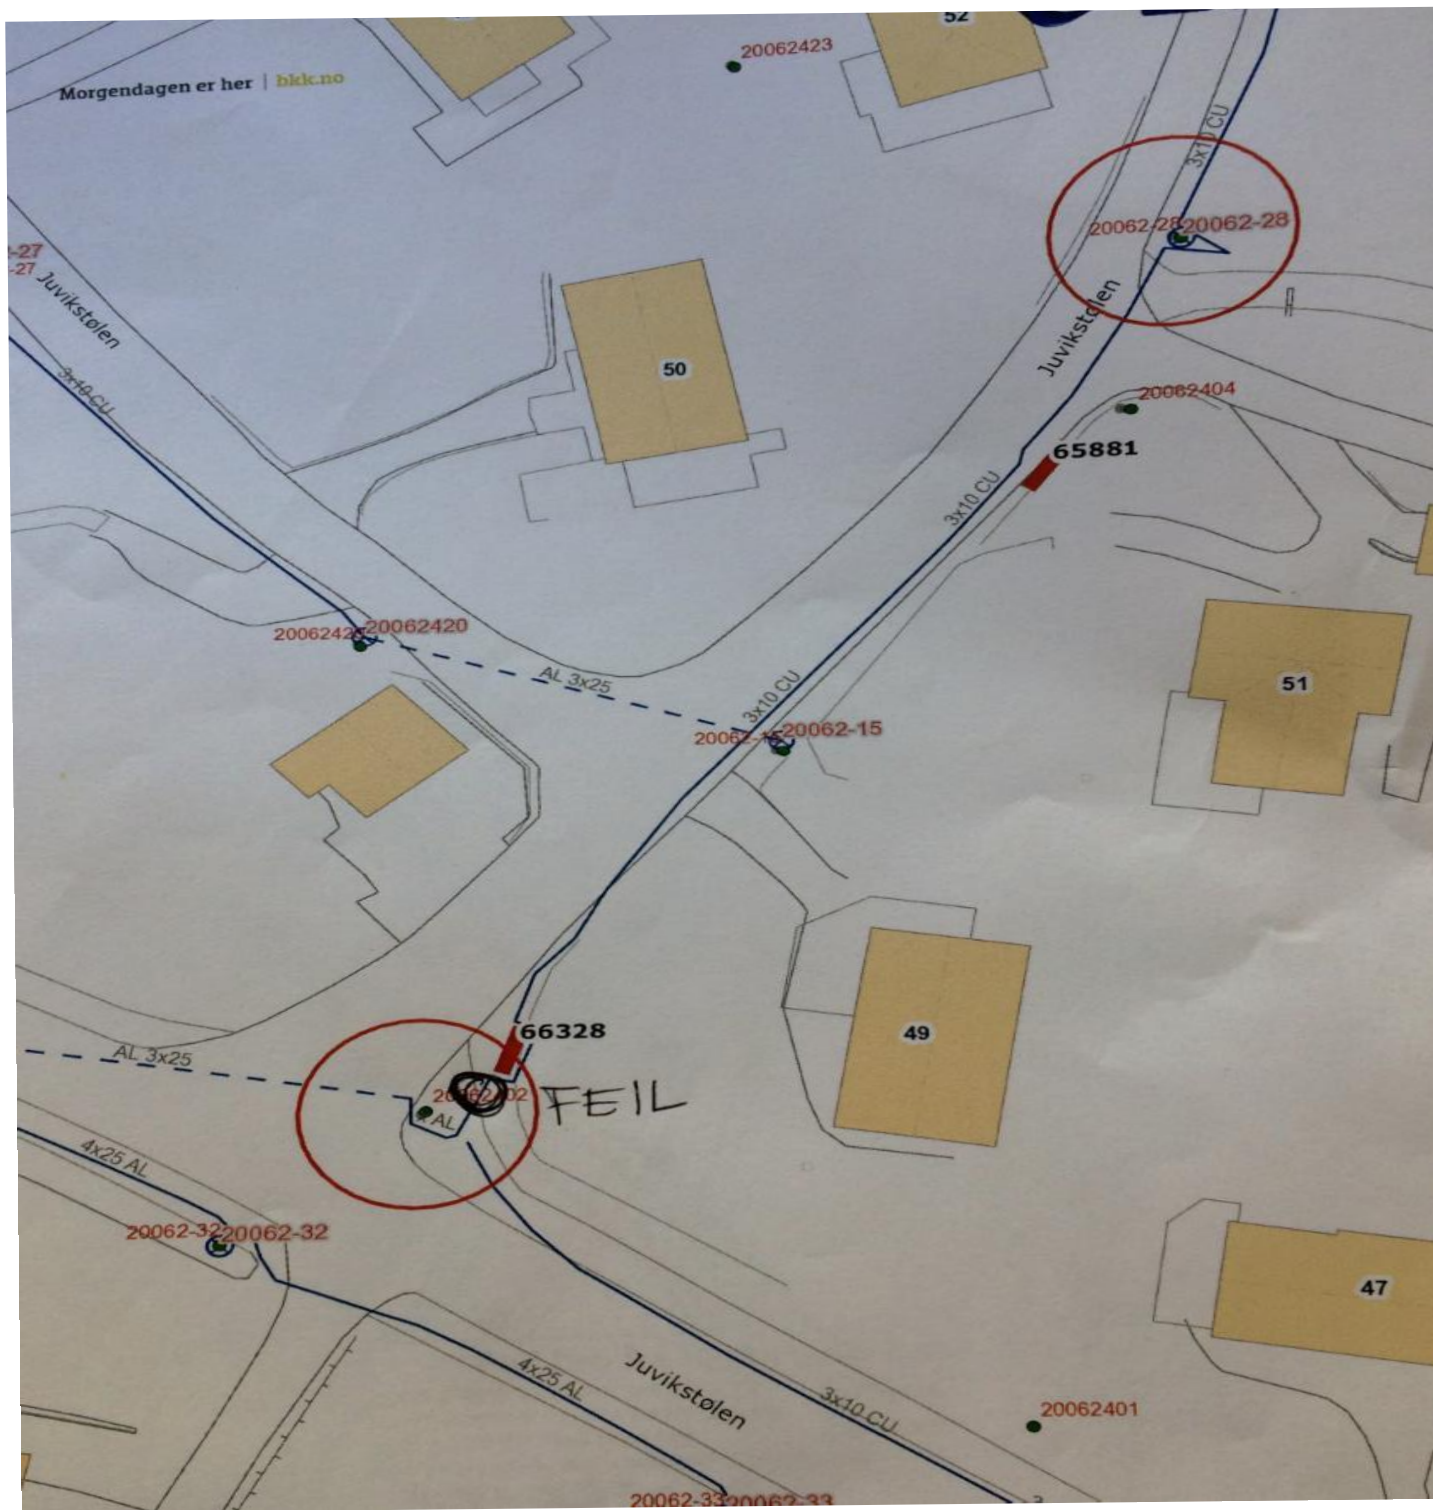



FEIL PÅ VEILYSKABEL I JUVIKSTØLEN, KNARVIK