


7

2 etg

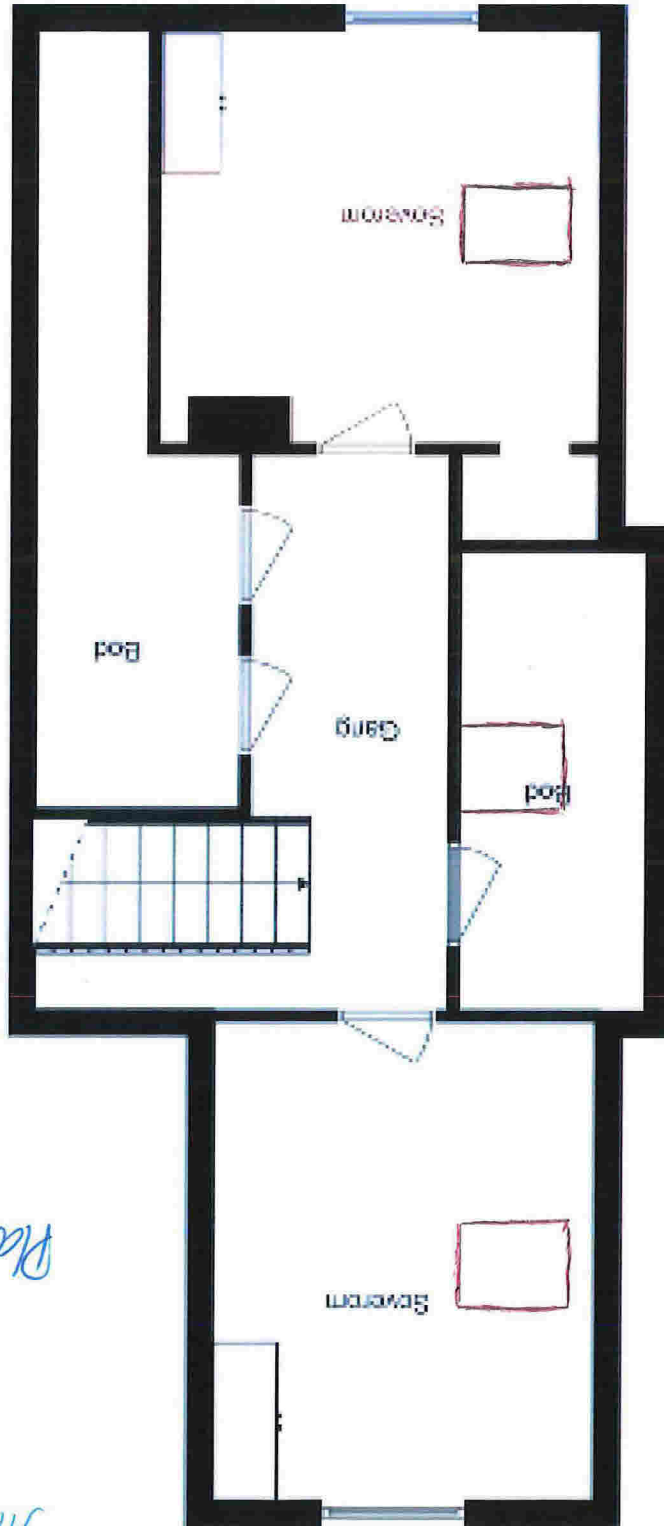

Planstisse loftstg.

Yngve Njåten

deigend


Hånn

Jiltay hauer

Bakeren 496

Gaustan 108

Verasvegen 36

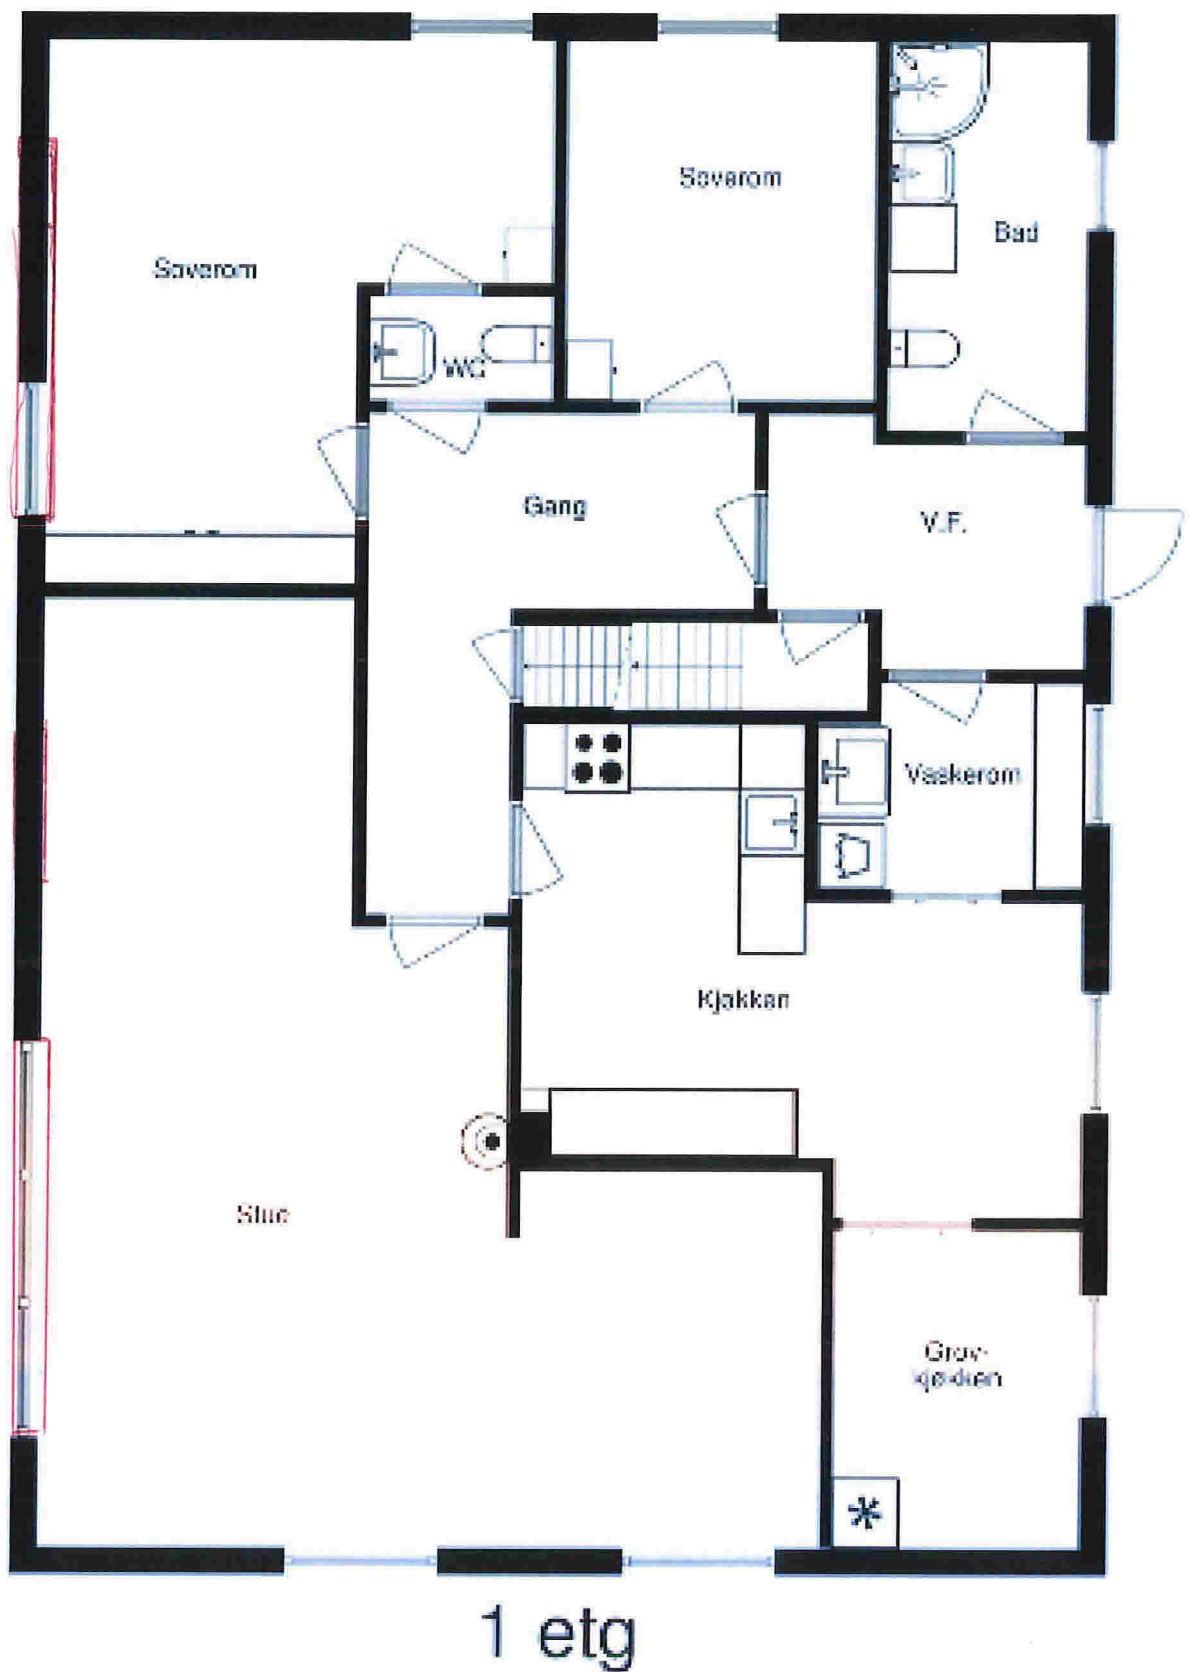

Planliste 1. etg.