




Nabovarsel

sendes til berørte naboer og gjenboere

plan- og bygningsloven av 27. juni 2008 nr. 71 § 21-3

Til (nabo/gjenboer)
Lindås kommune Kvernhusmyrane 20 5914 ISDALSTØ

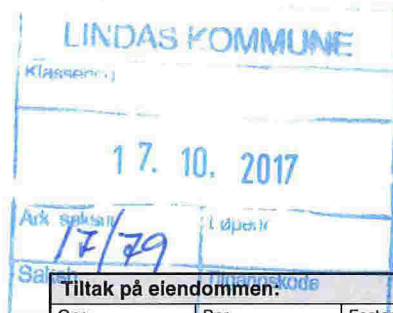

Tiltak på eiendommen:			
Gnr.	Bnr.	Festlenr.	Seksjonsnr.
123	102		
Eiendommens adresse Storhaugen 56			
Postnr.	Poststed		
5955	LINDÅS		
Kommune LINDÅS			
Eier/fester Bolig & Eiendom AS			

Som eier/fester av:			
Gnr.	Bnr.	Festlenr.	Seksjonsnr.
123	59		
Eiendommens adresse Neset 1			

Det varsles herved om				
<input checked="" type="checkbox"/> Nybygg	<input type="checkbox"/> Anlegg	<input type="checkbox"/> Endring av fasade	<input type="checkbox"/> Riving	
<input type="checkbox"/> Påbygg/tilbygg	<input type="checkbox"/> Skilt/reklame	<input type="checkbox"/> Innhegning mot veg	<input type="checkbox"/> Bruksendring	
<input type="checkbox"/> Midlertidig bygning, konstruksjon eller anlegg	<input type="checkbox"/> Antennesystem	<input type="checkbox"/> Oppretting/endring av matrikkelenhet (eiendomsdeling) eller bortfeste	<input checked="" type="checkbox"/> Annet	
Dispensasjon etter plan- og bygningsloven kapittel 19				
<input type="checkbox"/> Plan- og bygningsloven med forskrifter	<input type="checkbox"/> Kommunale vedtekter	<input type="checkbox"/> Arealplaner	<input type="checkbox"/> Vegloven	Vedlegg nr. B -

Arealdisponering		
Sett kryss for gjeldende plan		
<input type="checkbox"/> Arealdel av kommuneplan	<input checked="" type="checkbox"/> Reguleringsplan	<input type="checkbox"/> Bebyggelsesplan
Navn på plan Reguleringsplan for Rissundet Gbnr. 123/65,67,69 m.fl. (Planid: 1263-28091977).		


Beskriv nærmere hva nabovarslet gjelder	
Nabovarslet gjelder søknad om endring av gitt tillatelse. Endringen består i heving av bygget. Tiltaket består i oppføring av tomannsbolig og er tidligere nabovarslet.	
Vi gjør oppmerksom på at tegninger ikke er i riktig målestokk dersom dette ønskes ta kontakt med ansvarlig søker.	
Vedlegg nr. Q -	

Spørsmål vedrørende nabovarsel rettes til			
Foretak/tiltakshaver Arkoconsult As			
Kontaktperson, navn Yvonne Bruvik Hauge	E-post post@arkoconsult.no	Telefon 56390003	Mobil
Søknaden kan ses på hjemmeside: (ikke obligatorisk)		WWW.ARKOCONSULT.NO	

Merknader sendes til	
Eventuelle merknader skal være mottatt innen 2 uker etter at dette varsel er sendt. Ansvarlig søker/tiltakshaver skal sammen med søknad sende innkomne merknader og redegjøre for ev. endringer.	
Navn Yvonne Bruvik Hauge	Postadresse Postboks 103
Postnr. 5291	Poststed VALESTRANDSFOSSEN
E-post post@arkoconsult.no	

Beskrivelse av vedlegg	Gruppe	Nr. fra - til	Ikke relevant
Dispensasjonssøknad/vedtak	B	-	<input checked="" type="checkbox"/>
Situasjonsplan	D	1 - 1	<input type="checkbox"/>
Tegninger snitt, fasade	E	1 - 3	<input type="checkbox"/>
Andre vedlegg	Q	-	<input checked="" type="checkbox"/>

Underskrift		
Sted Valestrandsfossen	Dato 10.10.2017	Underskrift ansvarlig søker eller tiltakshaver <i>Yvonne Bruvik Hauge</i>
Gjentas med blokkbokslåser YVONNE BRUVIK HAUGE 69 665		

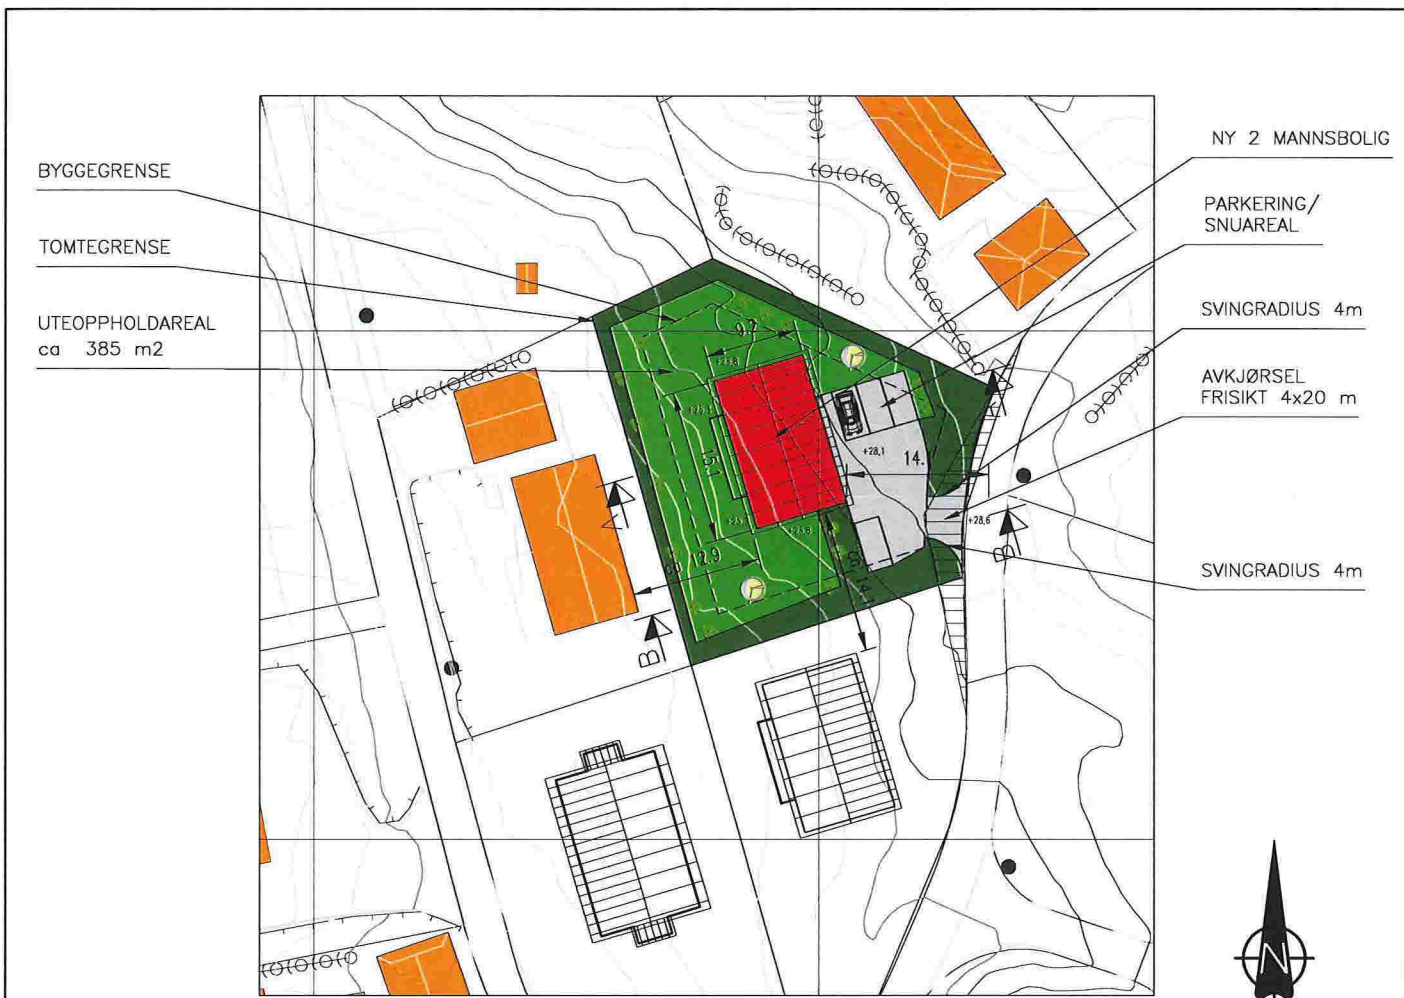

SITUASJONSPLAN

GNR.123 BNR.102 , RISASJØEN, LINDÅS KOMMUNE



OK GULV HOVEDPLAN: KOTE +27,5


FOR TERRENGSNITT A-A OG B-B SE TEGNING 20714102A11.

25.08.17/LAH	18.08.16/LAH	12.08.16/LAH	DATE/SIGN	NOTE! * PART OF DRAWING MAY NOT BE SHOWN IN SCALE * DO NOT TAKE MEASURES ON DRAWING * ONLY RELAY ON GIVE DIMENSIONS	ACCORDING TO INTERNATIONAL LAWS, THIS DRAWING IS THE PROPERTY OF ARKOCONSULT AS. THE DRAWING CAN NOT BE USED, MADE PUBLIC OR HANDED OVER TO A THIRD PART WITHOUT OUR WRITTEN CONSENT. ANY INFRINGEMENT WILL LEAD TO LEGAL PROCEEDINGS.
C HØYDE BYGG ENDRET	B AVKJØRSEL JUSTERT	A SVINGRADIUS 4m AVKJØRSEL	REV. DESCRIPTION	BOLIG & EIENDOM AS RISASJØEN, 123/102	REVISION/DATE: C/25.08.17
				SITUASJONSPLAN	PROJECT NO.: 2014102
					DRAWING NO.: 20714102A10
				SCALE: 1:500	FORMAT: A3
				DRAWN: LAH	DATE: 28.10.15
				CHECKED:	DATE:




ARKOCONSULT AS, Postboks 103, 5291 Væstf.f.
Tel.: 56390003 – Fax: 56191130 – Mob.: 93241511
Mail: post@arkoconsult.no – Org.nr.: 997089782 MVA

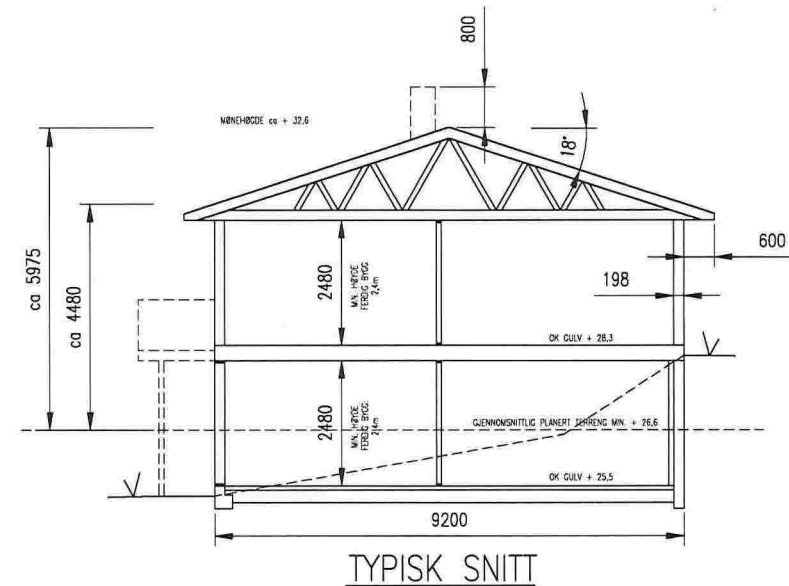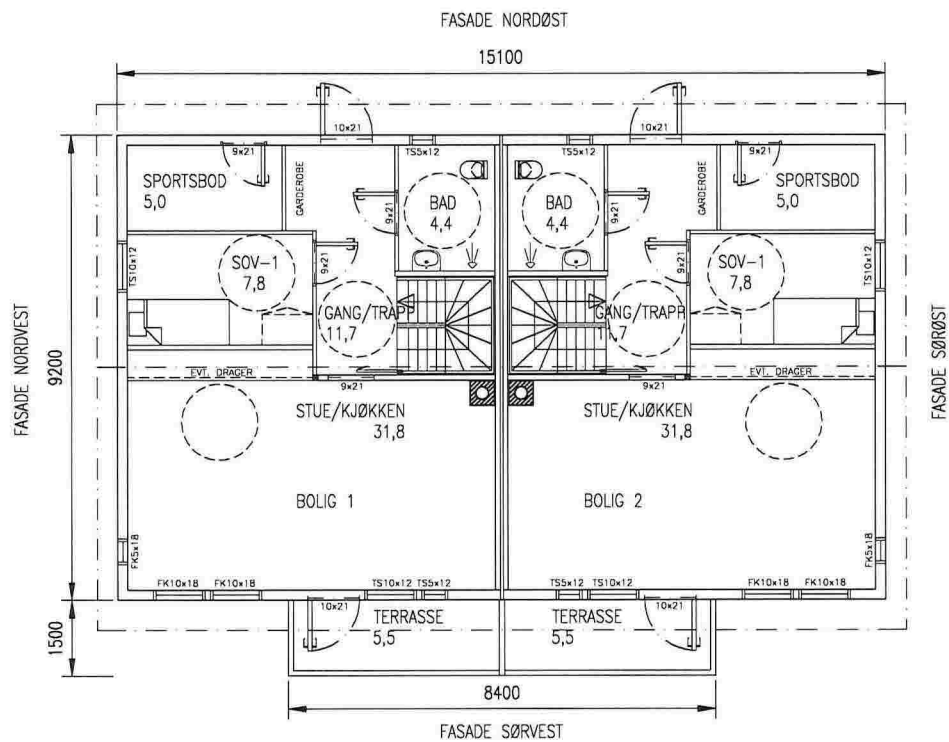


A	HØYDE BYGG ENDRET	25.08.17/LAH	NOTE!	ACCORDING TO INTERNATIONAL LAWS, THIS DRAWING IS THE PROPERTY OF ARKOCONSULT AS. THE DRAWING CAN NOT BE USED, MADE PUBLIC OR HANDED OVER TO A THIRD PART WITHOUT OUR WRITTEN CONSENT. ANY INFRINGEMENT WILL LEAD TO LEGAL PROCEEDINGS.	
		DATE/SIGN	* PART OF DRAWING MAY NOT BE SHOWN IN SCALE * DO NOT TAKE MEASURES ON DRAWING * ONLY RELAY ON GIVE DIMENSIONS	REVISION/DATE: A/25.08.17	
			BOLIG & EIENDOM AS RISASJØEN, 123/102	PROJECT NO.: 2014102	
			2 MANN'S BOLIG HOVEDPLAN OG SNITT	DRAWING NO.: 20714102A02	
				SCALE: 1:100	FORMAT: A3
			ARKOCONSULT AS, Postboks 103, 5291 Valest.f. Tel.: 56390003 - Fax.: 56191130 - Mob.: 93241511 Mail: post@arkoconsult.no - Org.nr.: 997089782 MVA	DRAWN: LAH	DATE: 28.10.15
				CHECKED: PKT	DATE: 12.02.16




FASADE SØR VEST

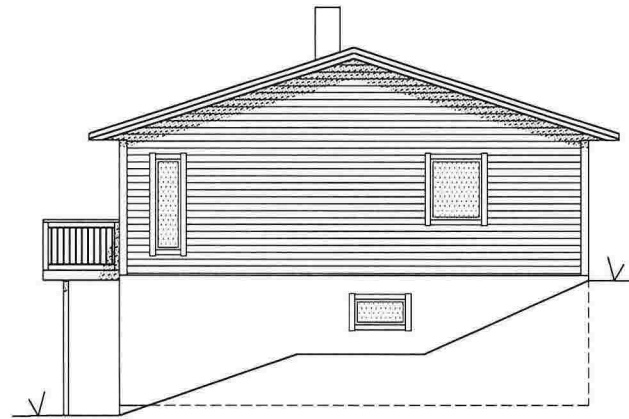


FASADE SØR ØST

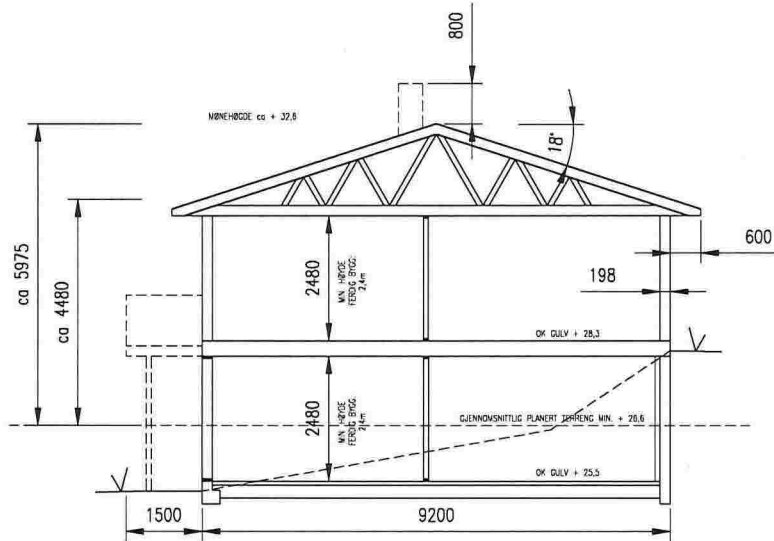


TYPISK SNITT

A	HØJDE BYGG ENDRET REV. DESCRIPTION	25.08.17/LAH DATE/SIGN	NOTE! * PART OF DRAWING MAY NOT BE SHOWN IN SCALE * DO NOT TAKE MEASURES ON DRAWING * ONLY RELAY ON GIVE DIMENSIONS	ACCORDING TO INTERNATIONAL LAWS, THIS DRAWING IS THE PROPERTY OF ARKOCONSULT AS. THE DRAWING CAN NOT BE USED, MADE PUBLIC OR HANDED OVER TO A THIRD PART WITHOUT OUR WRITTEN CONSENT. ANY INFRINGEMENT WILL LEAD TO LEGAL PROCEEDINGS.
			BOLIG & EIENDOM AS RISASJØEN, 123/102	REVISION/DATE: A/25.08.17 PROJECT NO.: 2014102
			2 MANNES BOLIG FASADER OG SNITT	DRAWING NO.: 20714102A03
				SCALE: 1:100 FORMAT: A3
			ARKOCONSULT AS, Postboks 103, 5291 Valest.f. Tel.: 56390003 - Fax.: 56191130 - Mob.: 93241511 Mail: post@arkoconsult.no - Org.nr.: 997089782 MVA	DRAWN: LAH DATE: 09.02.16
				CHECKED: PKT DATE: 12.02.16

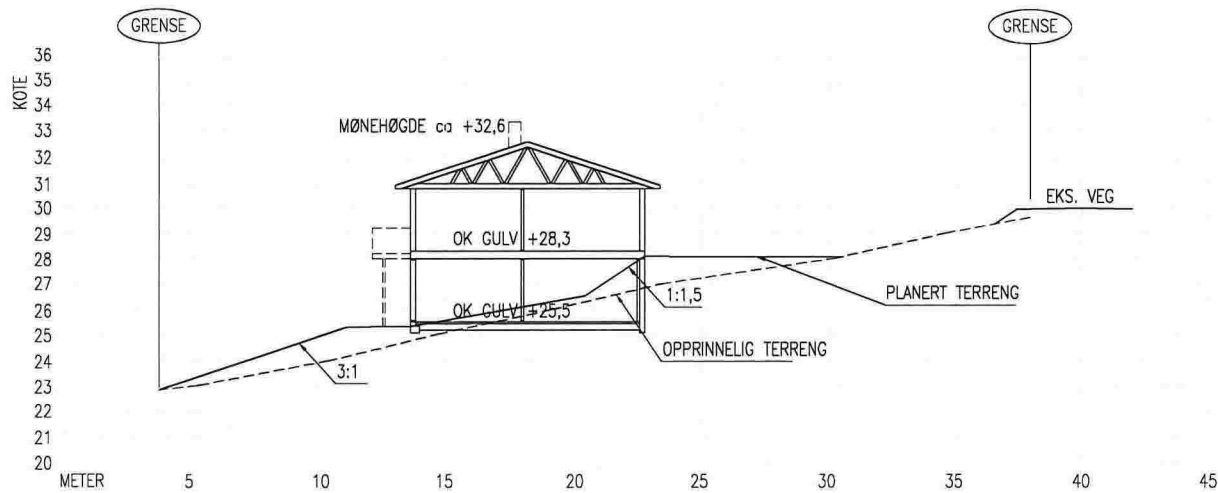

TERRENGPROFIL A-A

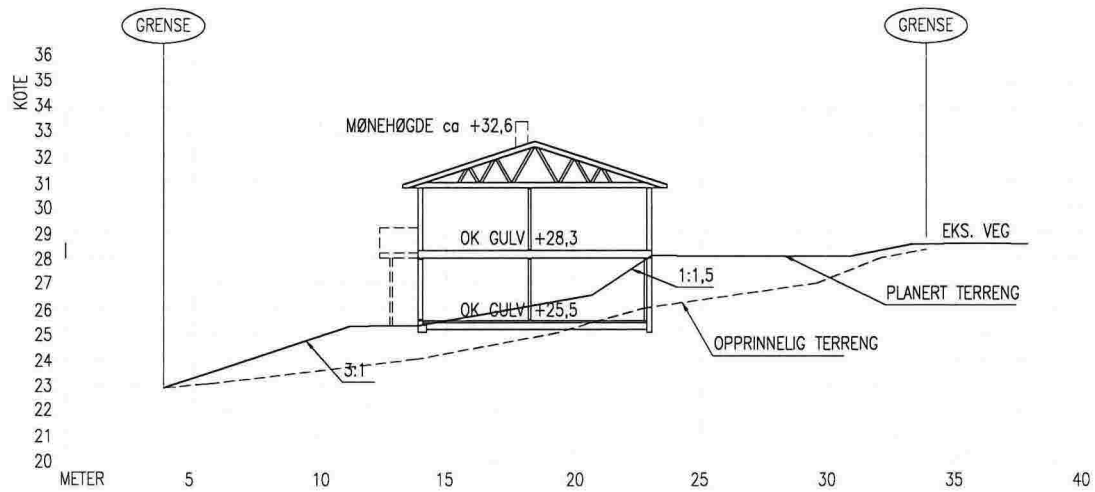

TERRENGPROFIL B-B

A	HØYDE BYGG ENDRET	25.08.17/LAH	DATE/SIGN	NOTE! * PART OF DRAWING MAY NOT BE SHOWN IN SCALE * DO NOT TAKE MEASURES ON DRAWING * ONLY RELAY ON GIVE DIMENSIONS	ACCORDING TO INTERNATIONAL LAWS, THIS DRAWING IS THE PROPERTY OF ARKOCONSULT AS. THE DRAWING CAN NOT BE USED, MADE PUBLIC OR HANDED OVER TO A THIRD PART WITHOUT OUR WRITTEN CONSENT. ANY INFRINGEMENT WILL LEAD TO LEGAL PROCEEDINGS.
		BOLIG & EIENDOM AS RISASJØEN, 123/102		REVISION/DATE: A/25.08.17	PROJECT NO.: 2014102
TERRENGPROFIL A-A OG B-B		DRAWING NO.: 20714102A11		SCALE: 1:200 FORMAT: A3	
ARKOCONSULT AS, Postboks 103, 5291 Valest.f. Tel.: 56390003 - Fax.: 56191130 - Mob.: 93241511 Mail: post@arkoconsult.no - Org.nr.: 997089782 MVA		DRAWN: LAH		DATE: 28.10.15	
		CHECKED:		DATE:	