



1 2 3 4

Fyllingsnesvegen 43






Hot syde



Hof Vest



Mat vest

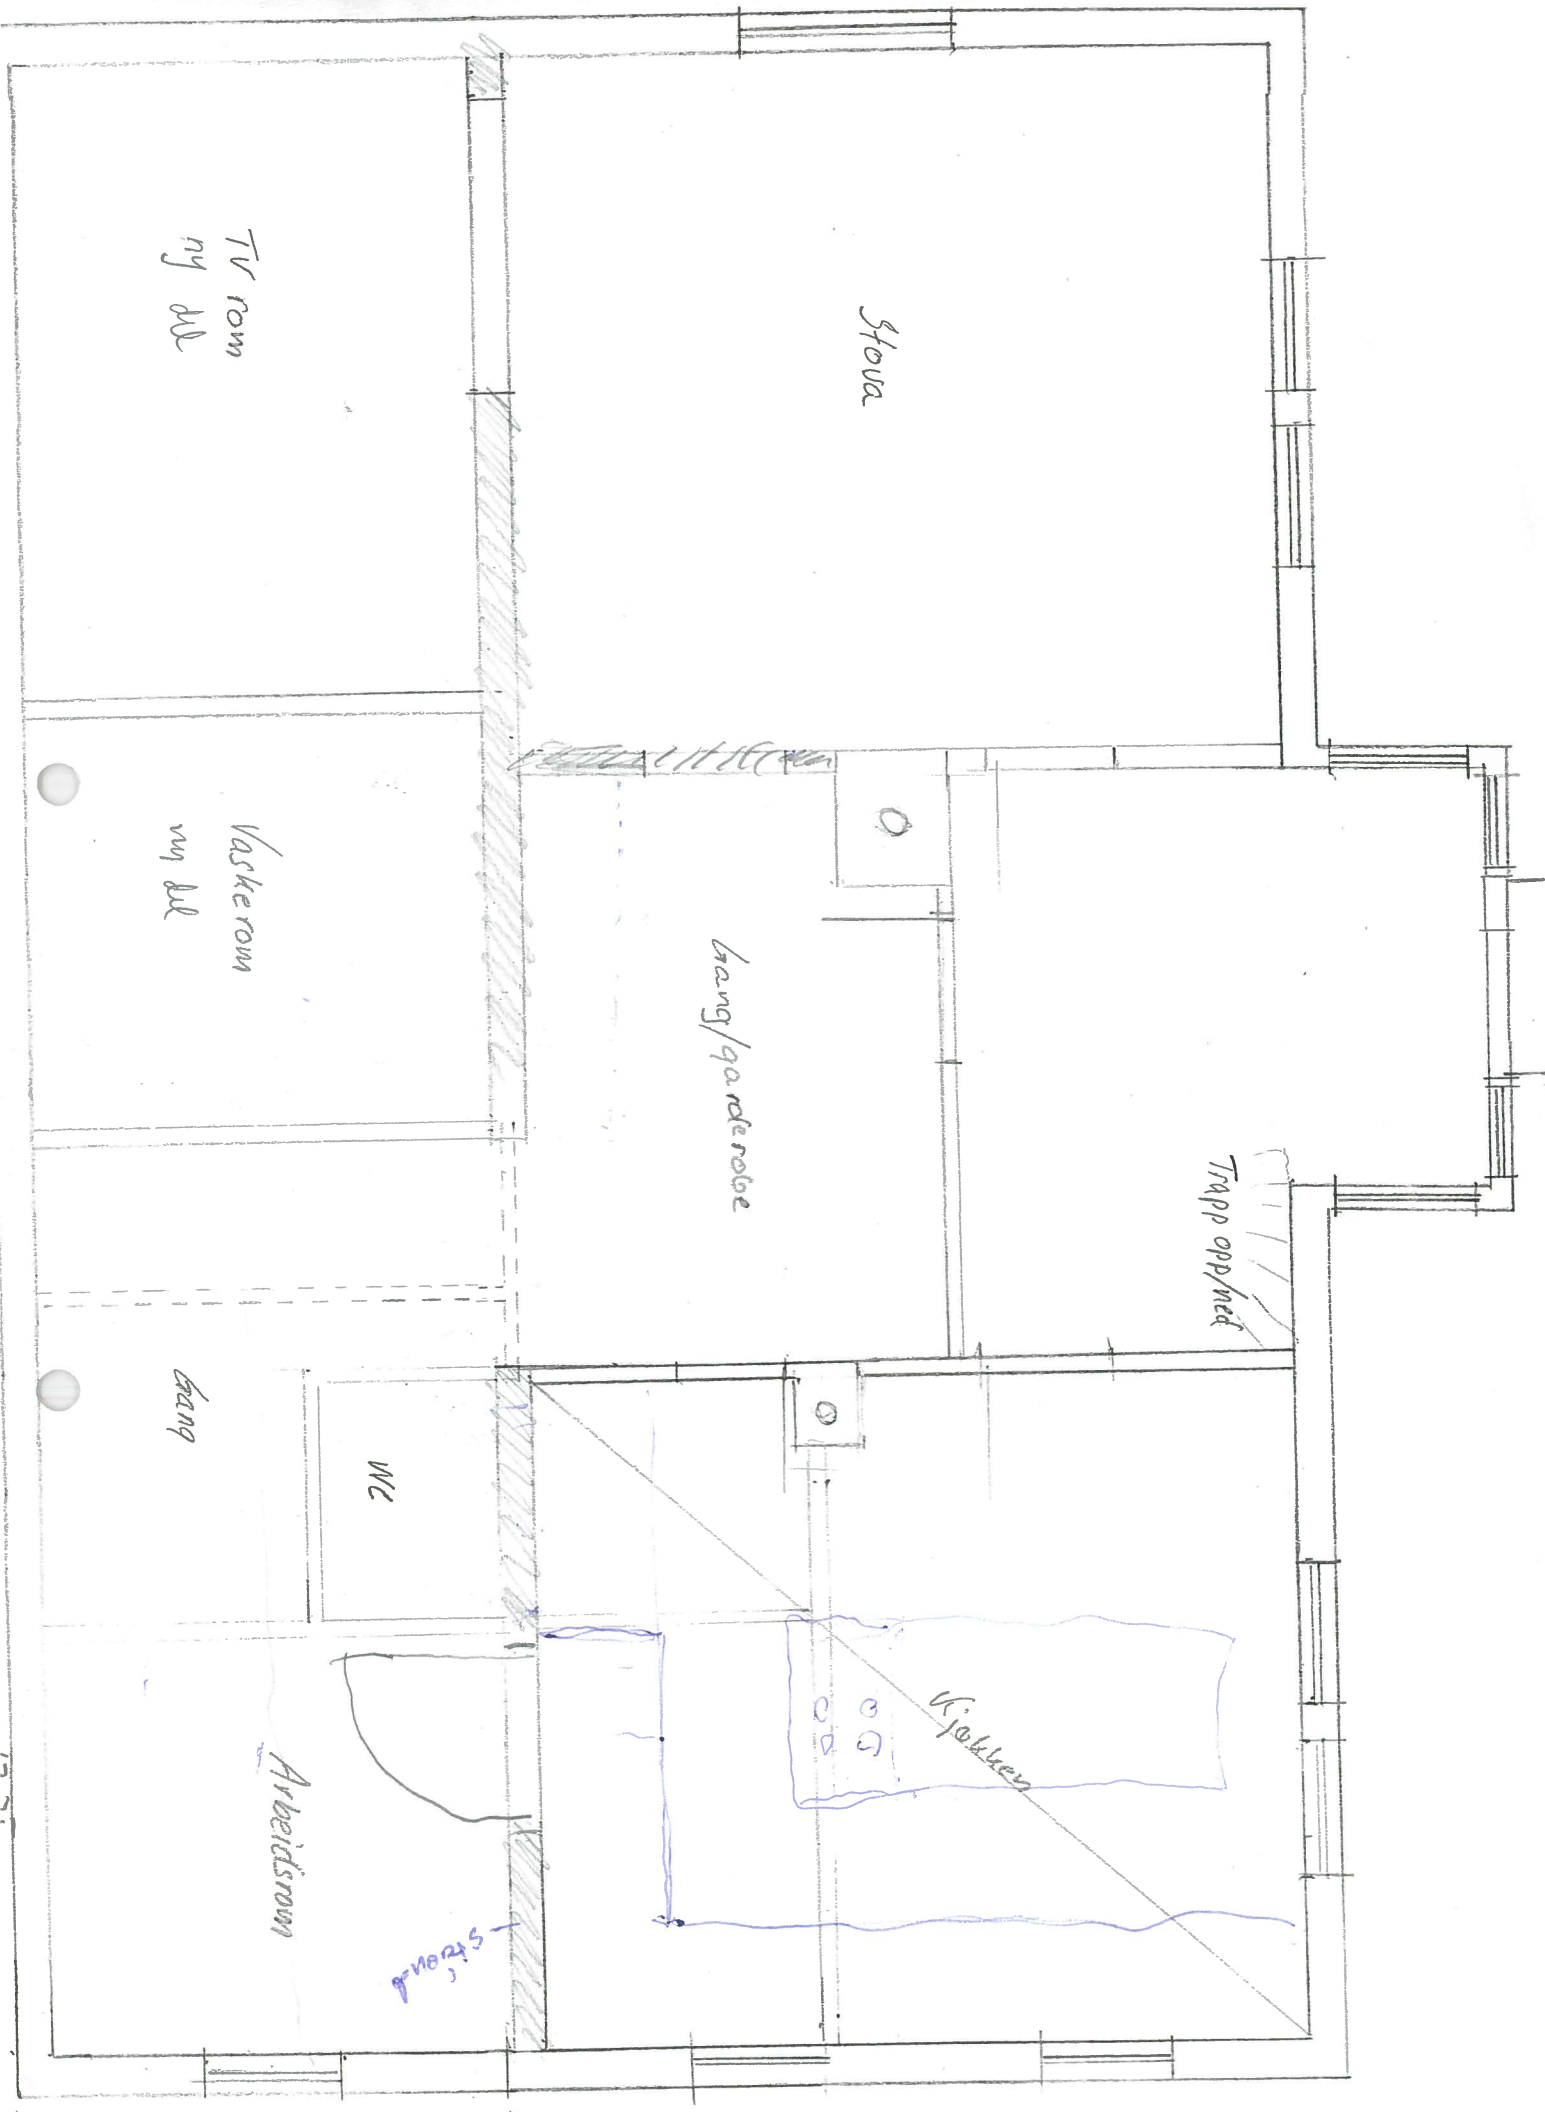

TV rom


Waskerom

Gang/garderobe

Trapp opp/med

Gang

WC

Kjøkken

Arbeidsrom

Stoend

3,7

