


744180

316714

316991

X 67441

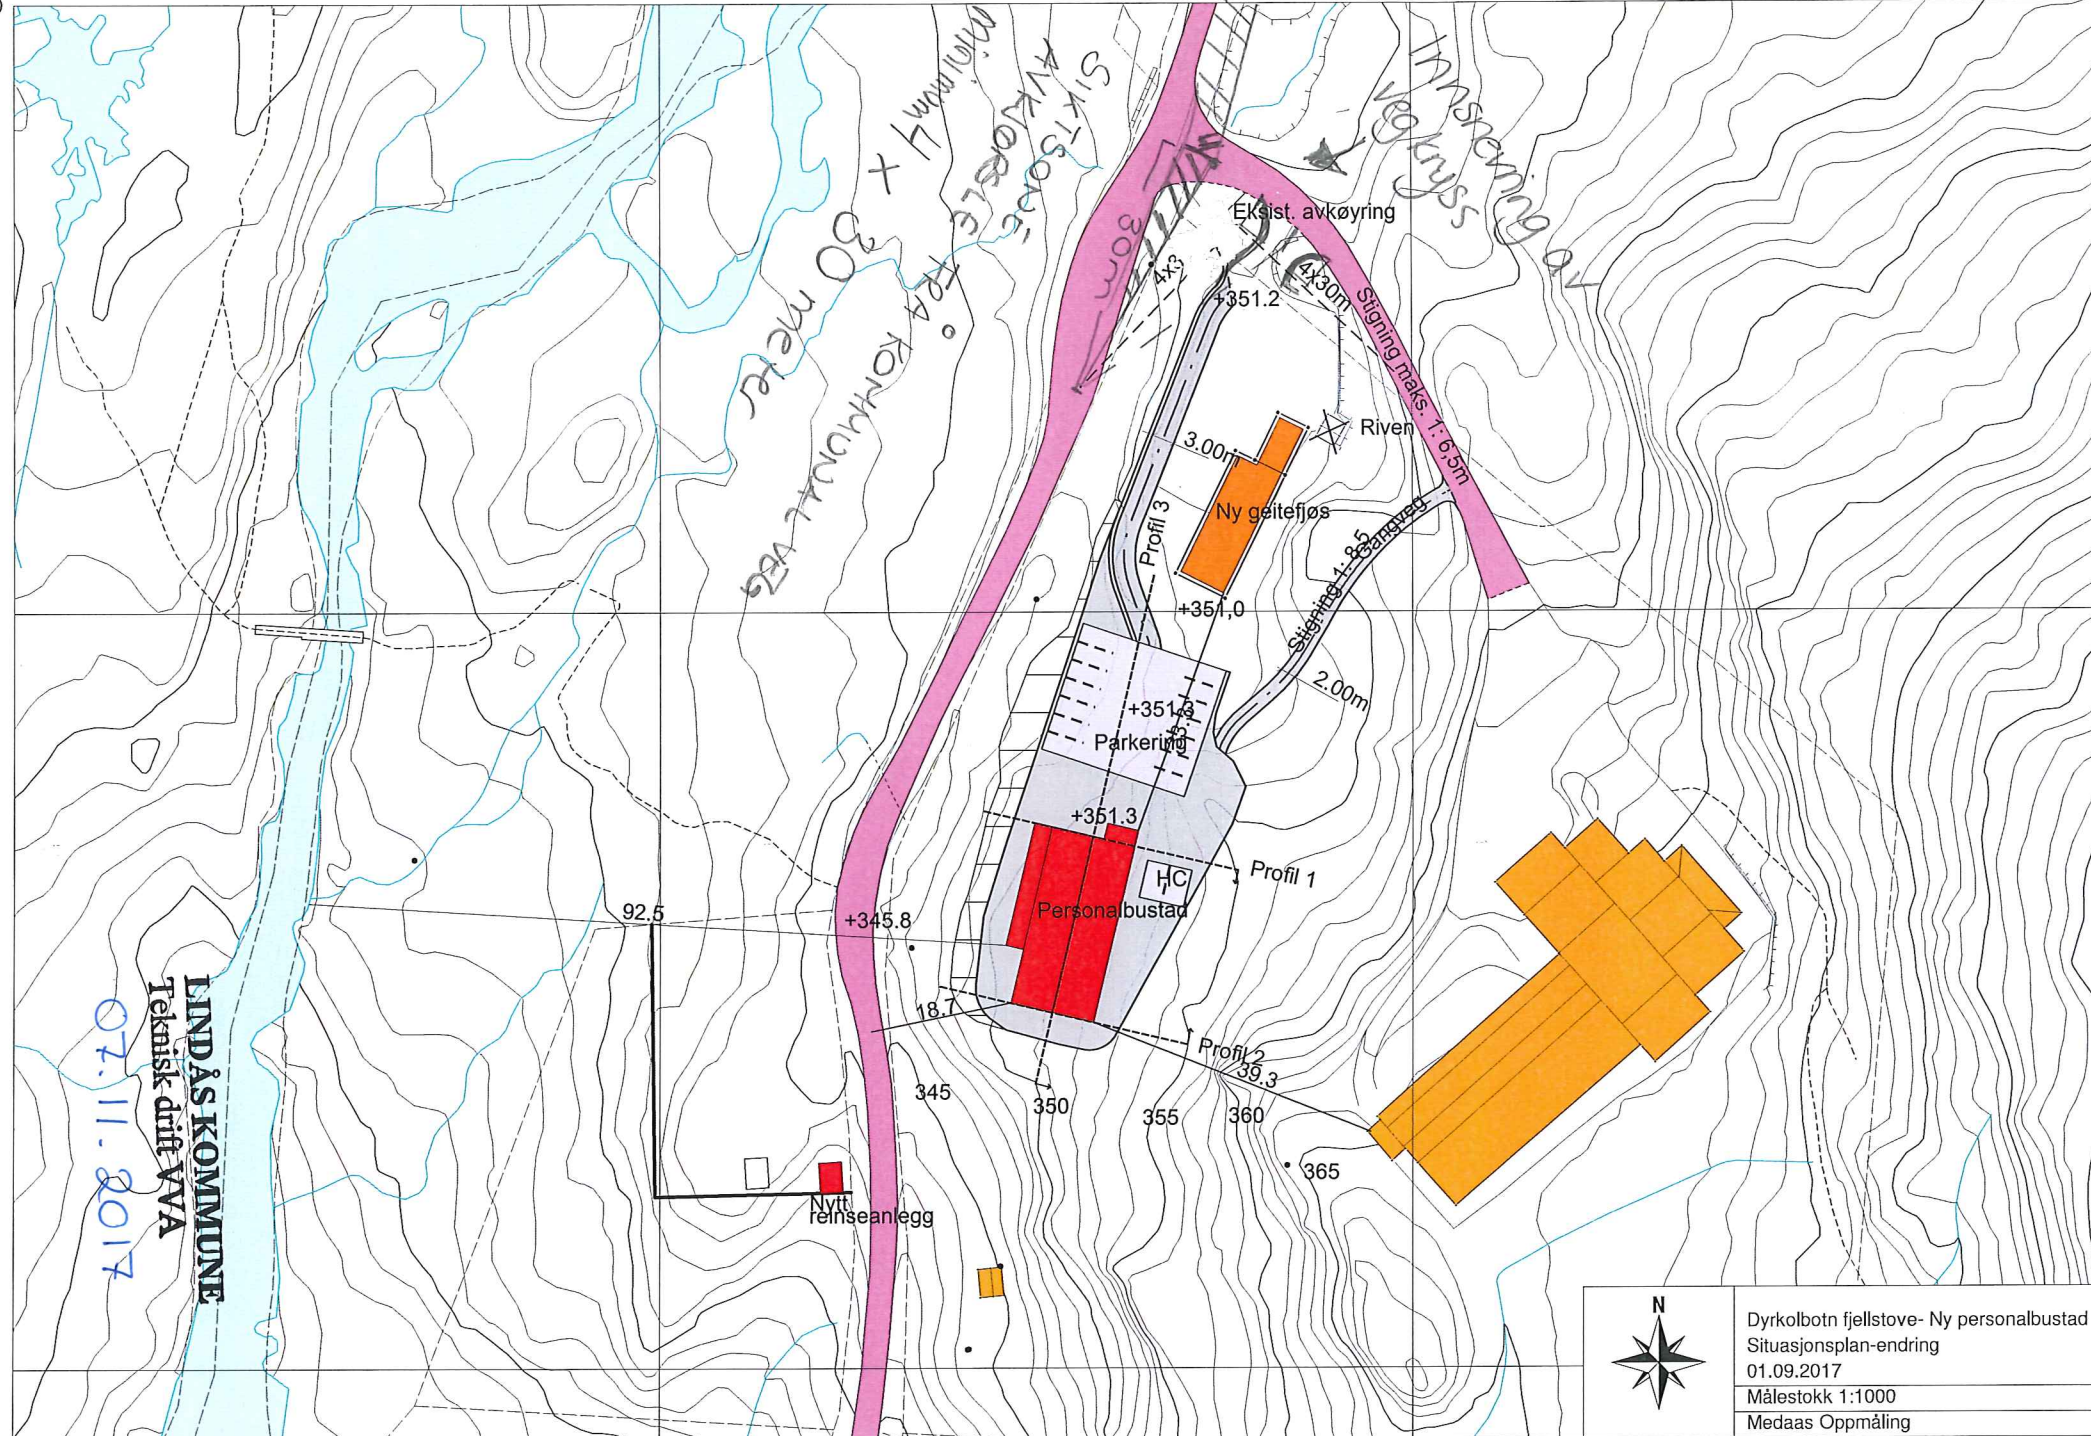

LINDÁS KOMMUNE
 Teknisk drift VVA
 07.11.2017



Dyrkolbotn fjellstove- Ny personalbustad
 Situasjonsplan-endring
 01.09.2017
 Målestokk 1:1000
 Medaas Oppmåling

743991

Y 31671

X 67439

Y 31699