

N6721537, Ø301149 +



VL32

VL32

196/47

220A
220B

7A
7B

196/161

SP110
VL32

218

196/65

14

196/155

Vl 2x/min
4.110

196/160

12

196/154

196/141

10B

10A

196/153

11

196/159


13A

196/158

VL32

SP110

Situasjonskart -

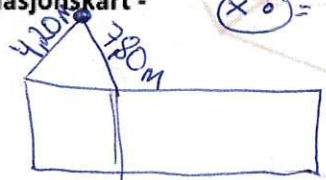

⊗ = utv stoppekran.
utv. stakke punkt

Nhdigi.no

Dato: 23-11-2017

Målestokk: 1:500



+ N6721393, Ø301049

Data fra Kartverket, Norge Digitalt og Nordhordland digitalt