


1.

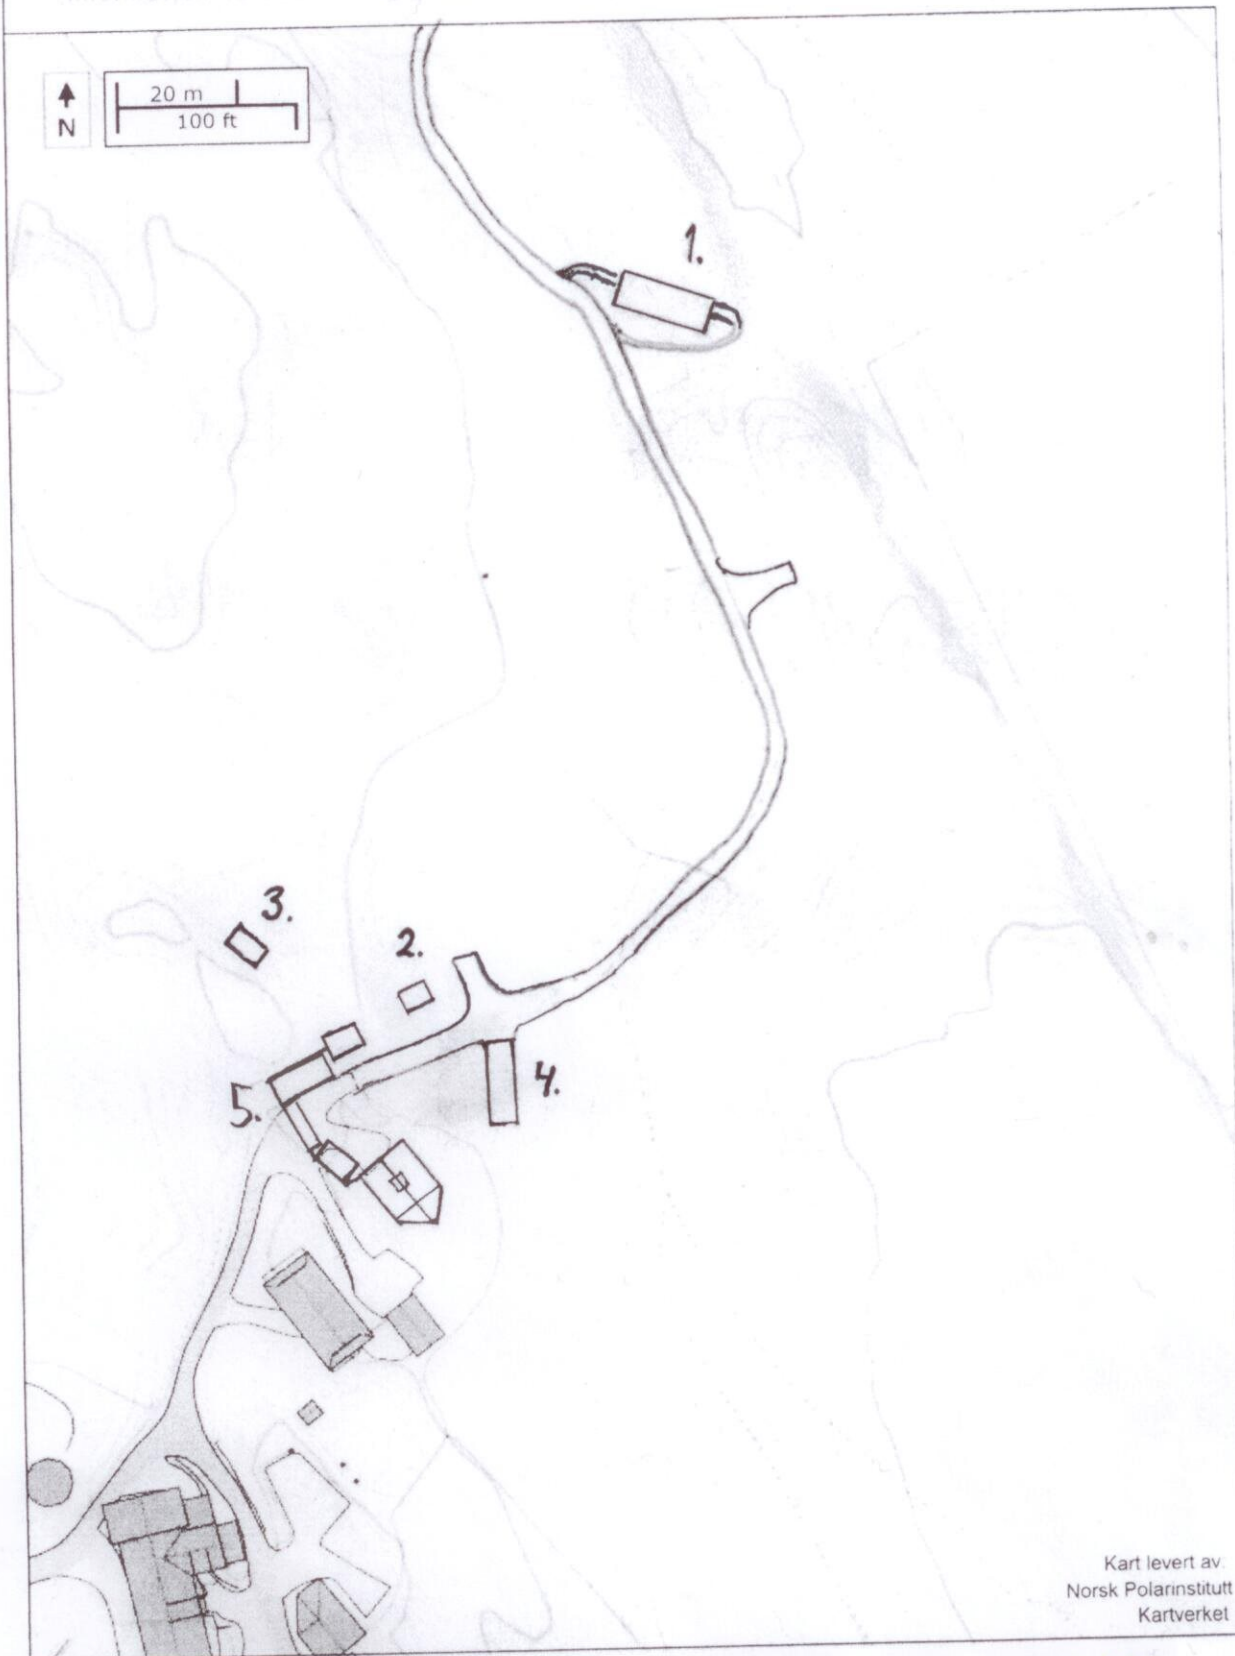

1. VIKINGSKIP GRAYHAUG
2. LAGER
3. GRINDBYGG
4. FJØS
5. SERVICE BYGG

SPURKELAND VIKINGGARD
V/OLE KRISTIAN KJENES
Gr.nr. 176 Br.nr. 1