


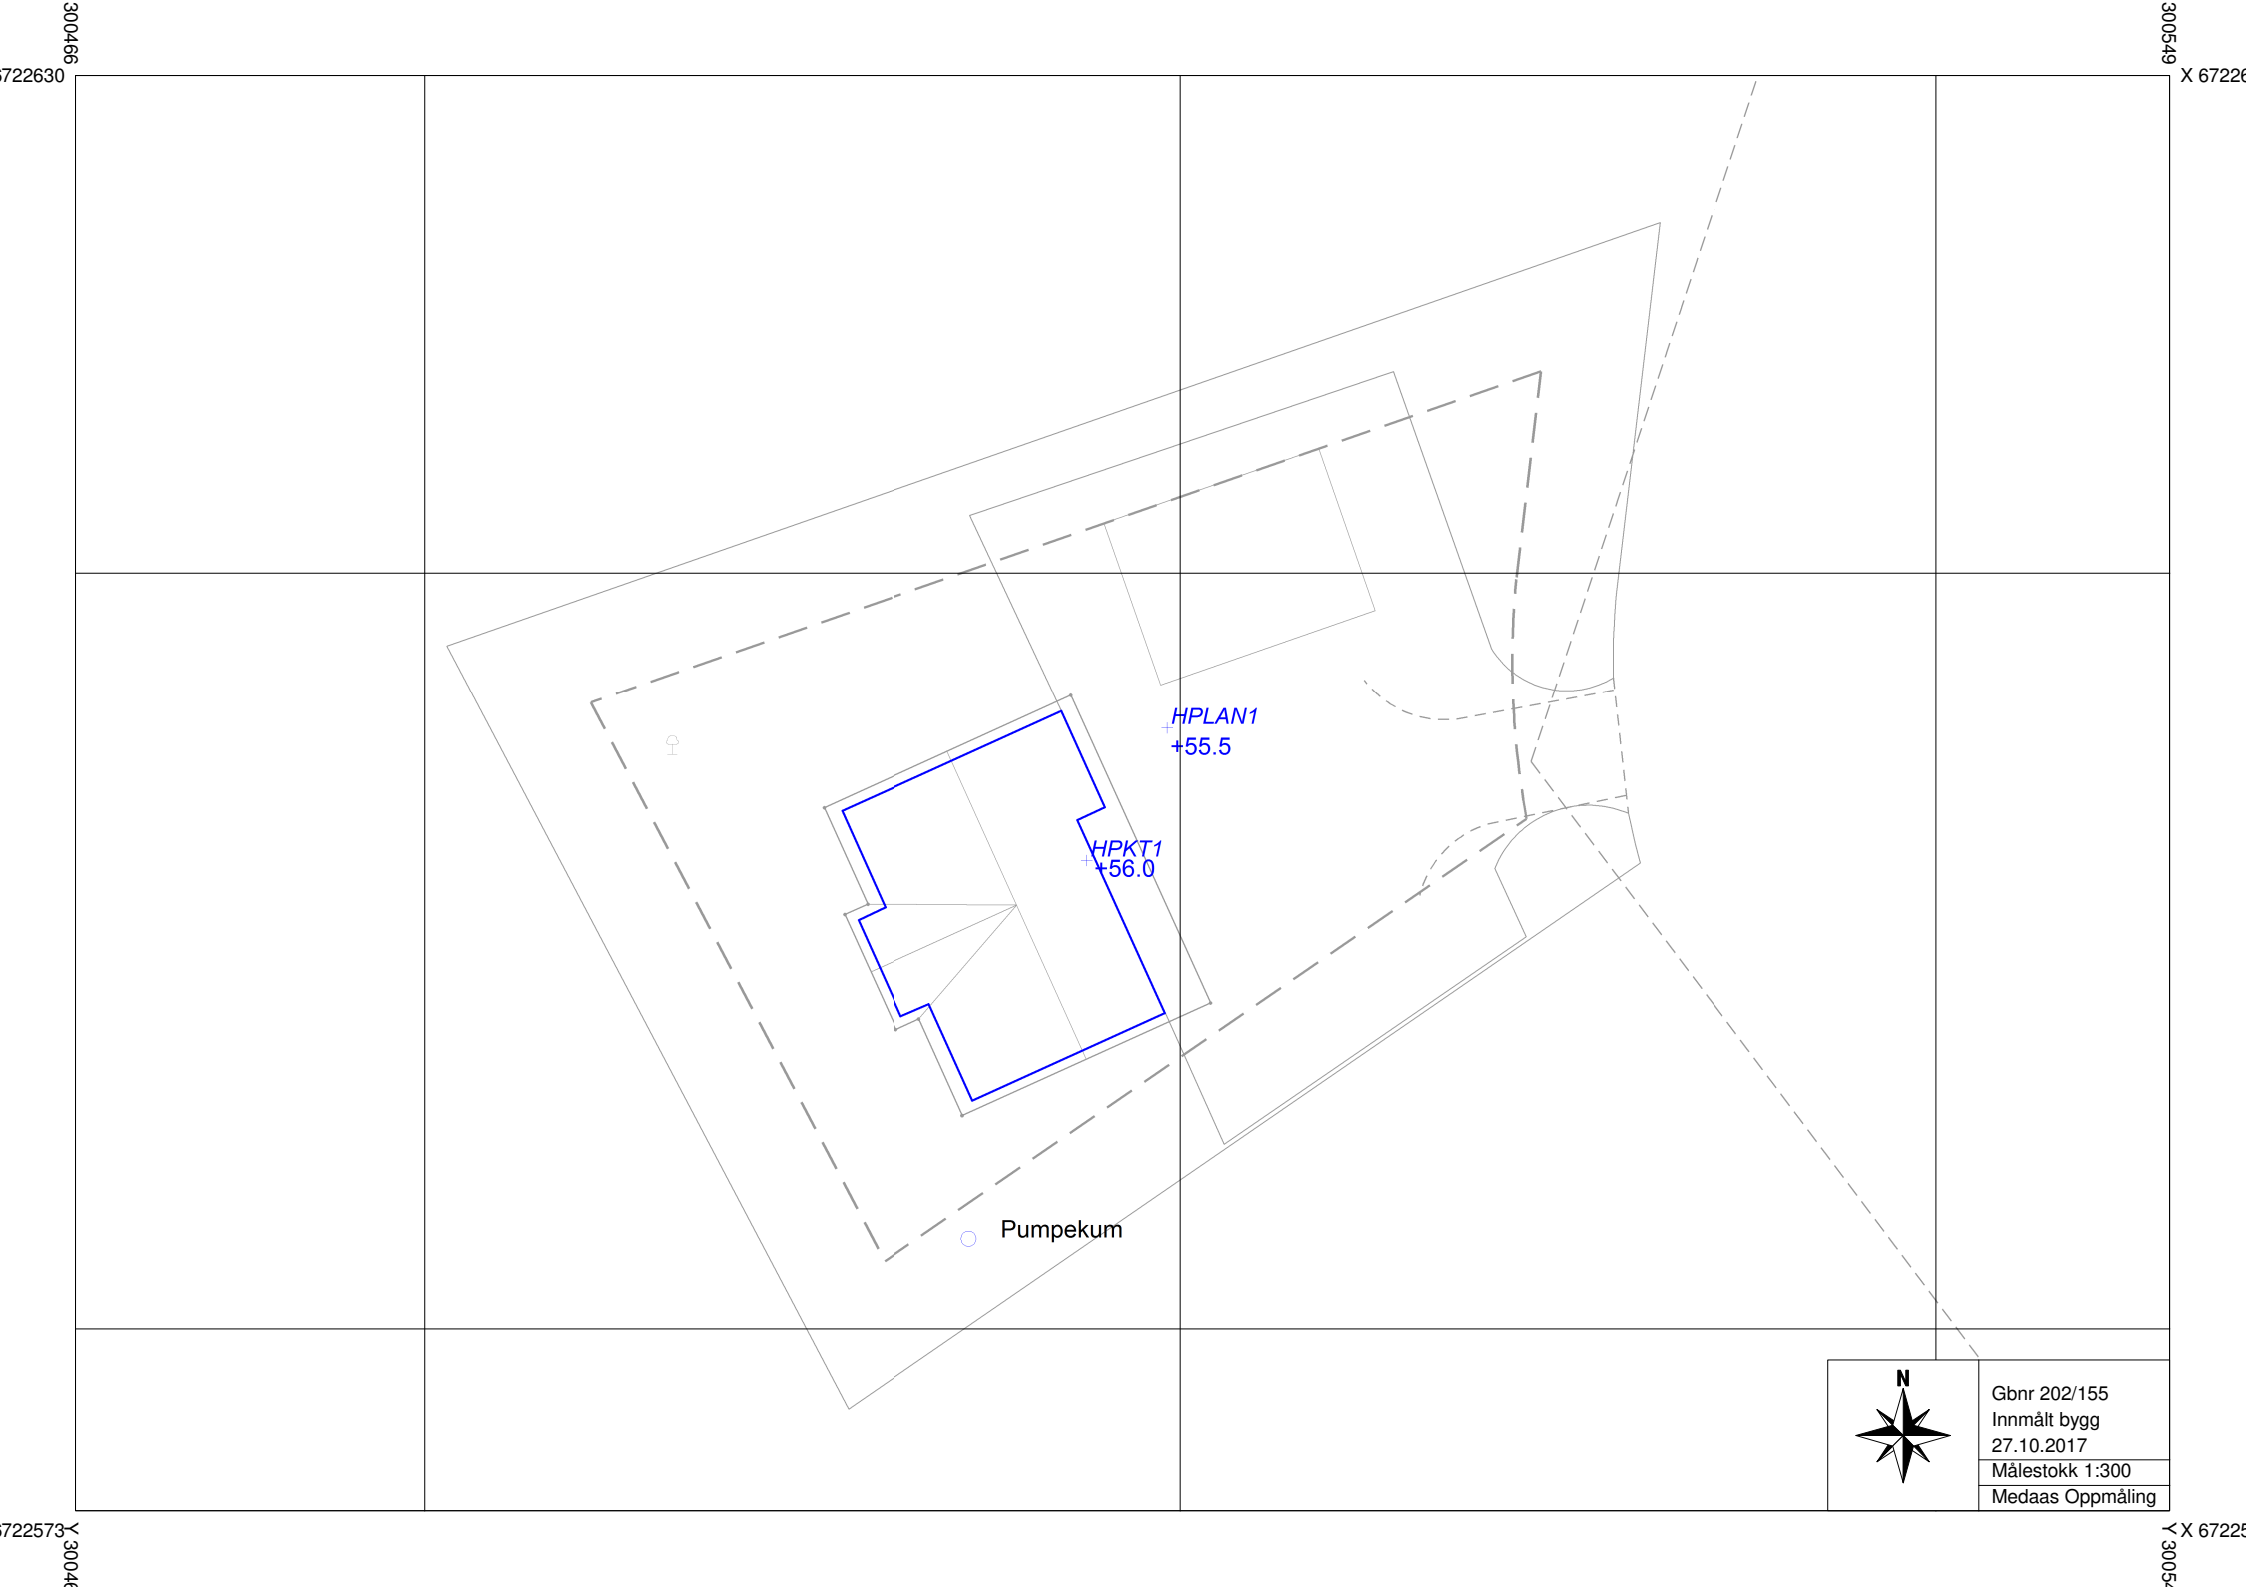

Gbnr 202/155
Innmålt bygg
27.10.2017
Målestokk 1:300
Medaas Oppmåling