


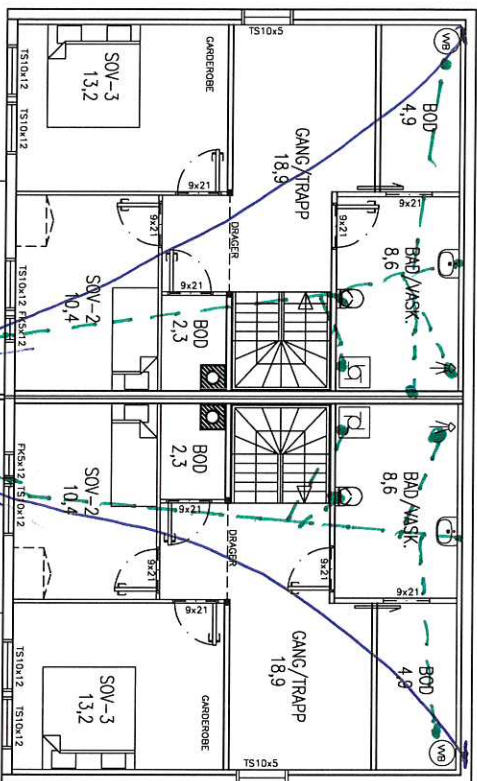

KJELLERPLAN

● = utf. stoppunkt 110 mm
 ✗ = utf. stoppunkt 32 mm

Stendal VVS AS
 Blomhøken 1 - 5911 ALVERSUND
 E-post: sten-vvs@online.no
 Org.nr. 980 626 180

BYA:
 BRA PR LEILIGHET KJELLERPLAN (INN.):
 BRA PR LEILIGHET HOVEDPLAN:
 BRA PR LEILIGHET (INK. TAKOVERBYGG):
 TOTALT BRA:

147,2 m2
 61,6 m2
 63,2 m2
 126,3 m2
 152,6 m2

NOTE:
 * PART OF DRAWING MAY NOT BE SHOWN IN SCALE
 * DO NOT TAKE MEASURES ON DRAWING
 * ONLY RELAY ON GIVE DIMENSIONS

ACCORDING TO INTERNATIONAL LAWS, THIS DRAWING IS THE PROPERTY OF ARKOCONSULT AS. THE DRAWING CAN NOT BE USED, MADE PUBLIC OR HANDED OVER TO A THIRD PARTY WITHOUT OUR WRITTEN CONSENT. ANY INFRINGEMENT WILL LEAD TO LEGAL PROCEEDINGS.

BOLIG & EIENDOM AS
 RISASJØEN, 123/136

REVISION/DATE:
 PROJECT NO.: 2014100

2 MANN'S BOLIG
 KJELLERPLAN

DRAWING NO.:
 20714100A01

arkoconsult
 ARKOCONSULT AS, Postboks 103, 5291 Volestf.
 Tel.: 56390003 - Fax.: 56191130 - Mob.: 93241511
 Mail: post@arkoconsult.no - Org.nr.: 997089782 MVA

SCALE: 1:100
 DRAWN: LAH
 CHECKED: PKT
 DATE: 28.10.15
 DATE: 12.02.16