




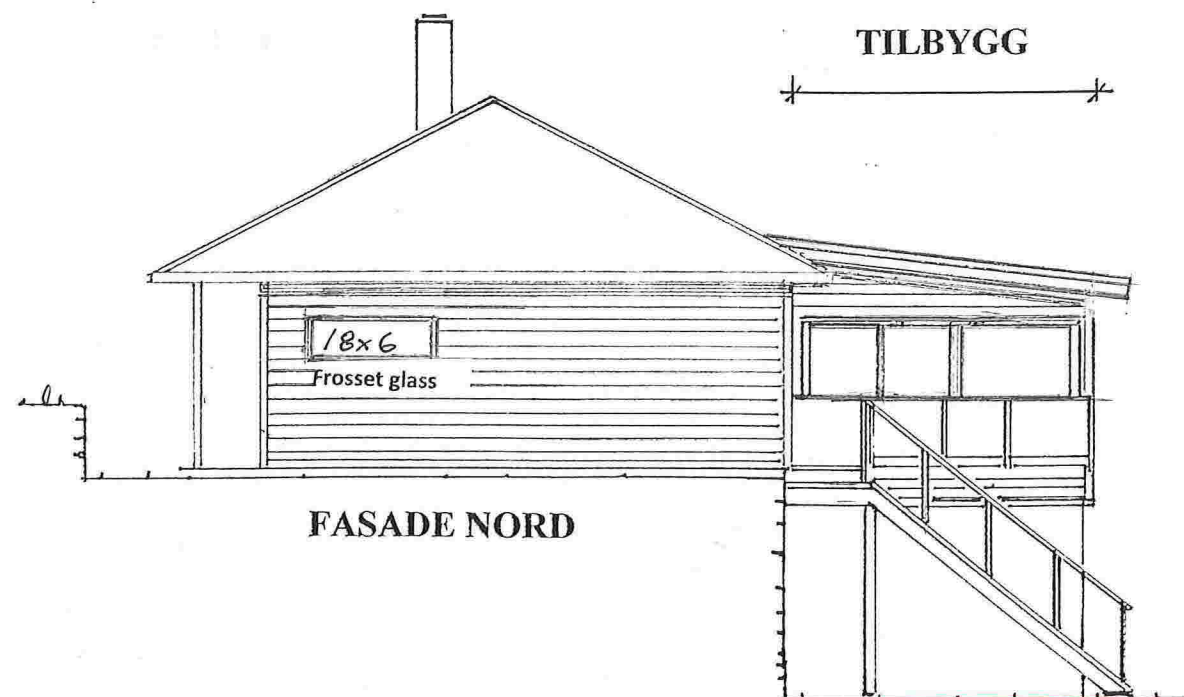


FASADE NORD

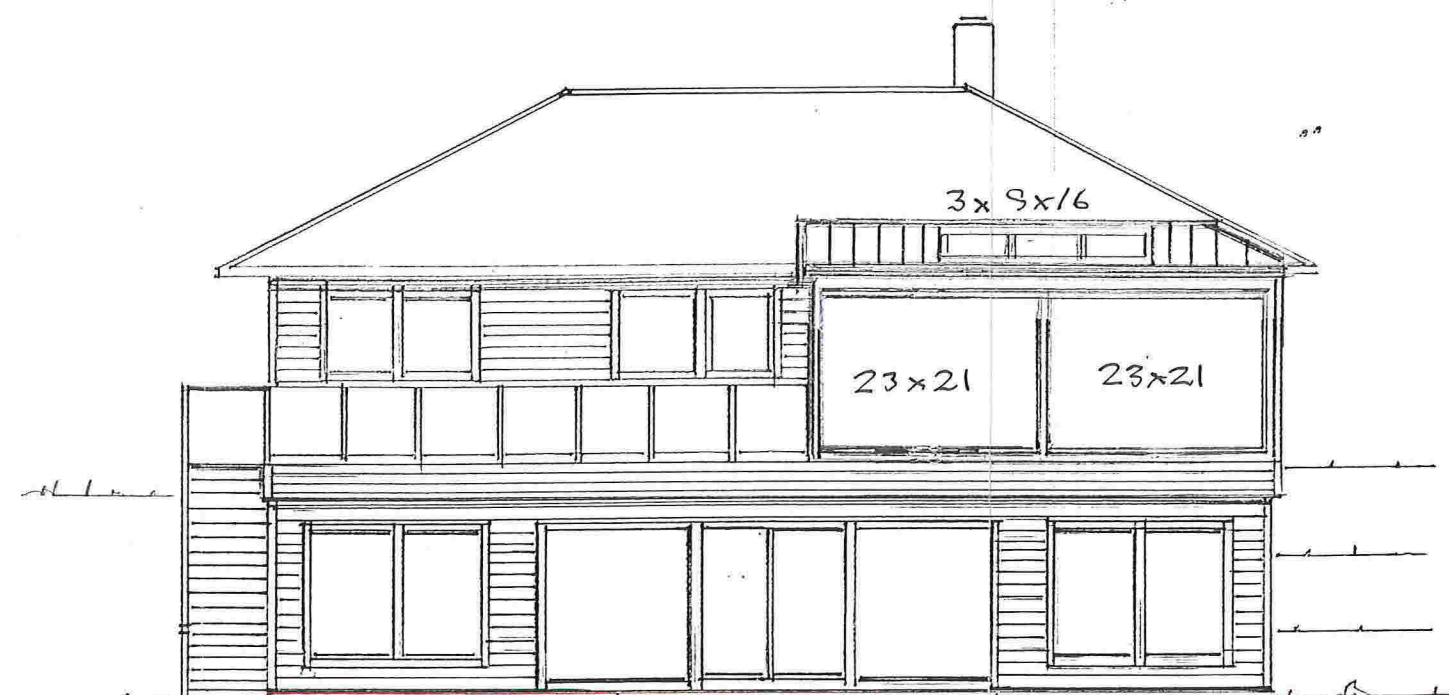

FASADE VEST

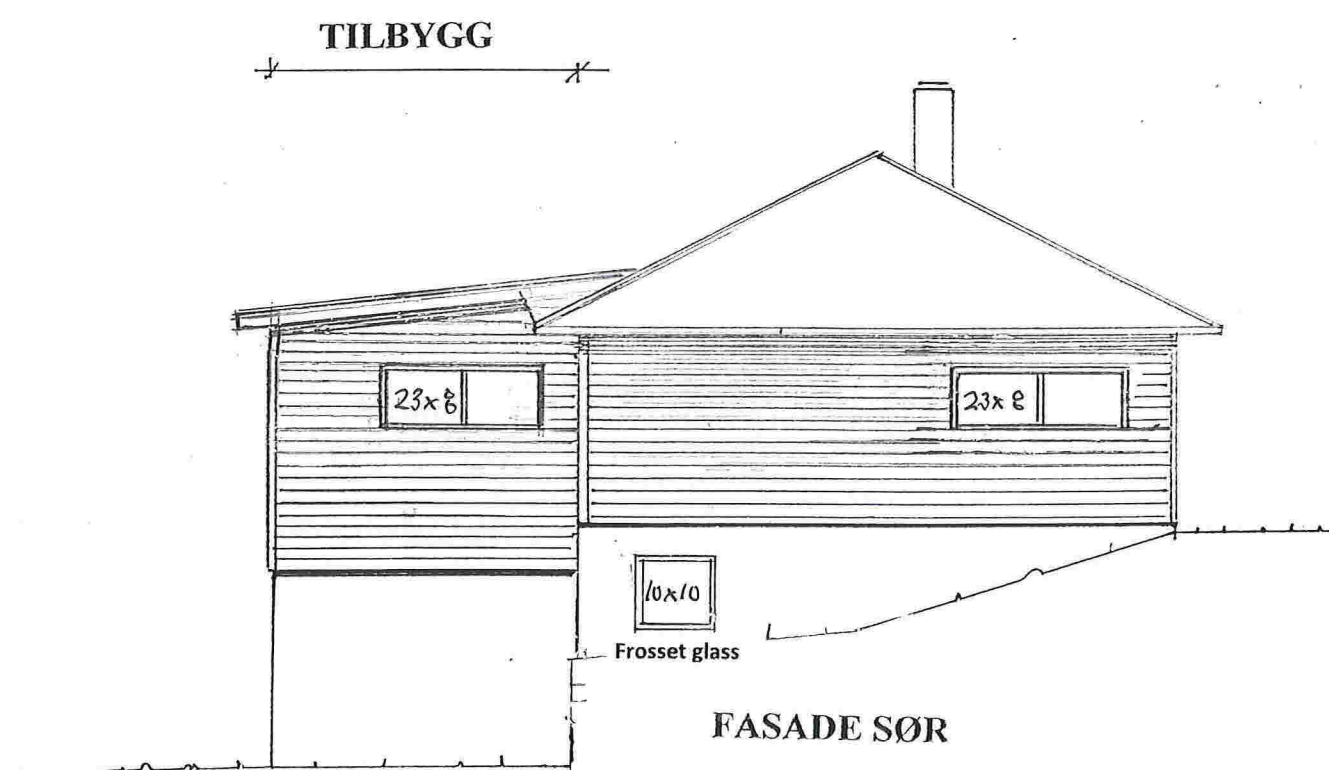

FASADE SØR

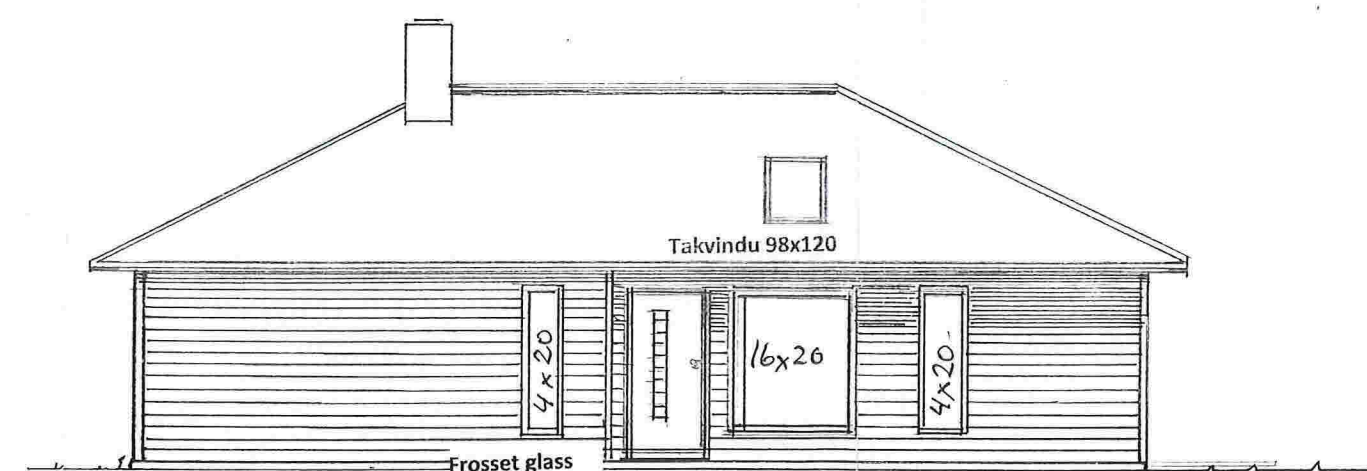

FASADE MOT ØST

FASADE TEGNINGER

Fasade: nord, sør og vest M=1:100

Gnr. 185 Bnr. 212 Lindås kommune

Litlevika 30. 5914 Isdalstø

Tiltakshaver: Tommy Szajnfeld

DATO: 30.01.2017

REV. 23.5.17

REV. 10.4.18. Vindwer. off