

PunktID	N-koord.	Ø-koord.
H1	6734937,89	295641,75
H2	6734938,35	295643,17
H3	6734943,19	295641,60
H4	6734945,65	295649,21
H5	6734929,21	295654,53
H6	6734926,29	295645,50


Høyde planert: kote +189,6

.HODE
..TEGNSETT ISO8859-1
..SOSI-VERSJON 4.2
..SOSI-NIVÅ 4 !!!!!!!!!!!!!!!
..TRANSPAR
...KOORDSYS 22
...ORIGO-NØ 6734897 295628
...ENHET 0.010
..OMRÅDE
...MIN-NØ 6734897 295628 !!!!!!!!!!!!!!!
...MAX-NØ 6734959 295677 !!!!!!!!!!!!!!!
..PRODUSENT "Vest Oppmåling AS"
Euref 89 sone 32
Utstyr: Leica GNSS CS 09 med referanse fra Leica Smartnett.
Måledato: 24.06.2014
Innmålt fasadeliv
.KURVE 1:
..OBJTYPE Ukjent
..NØH
4088 1375 0 ...KP 1
..NØH
4135 1517 0
4619 1360 0
4864 2121 0
3221 2653 0
2929 1750 18991
4088 1375 0 ...KP 1
.FLATE 2:
..OBJTYPE Bygningsdel
..REF :1
..NØ
3875 1963
.PUNKT 3:
..PNR H1
..NØ
4088 1375 ...KP 1
.PUNKT 4:
..PNR H2
..NØ
4135 1517
.PUNKT 5:
..PNR H3
..NØ
4619 1360
.PUNKT 6:
..PNR H4
..NØ
4864 2121
.PUNKT 7:
..PNR H5
..NØ
3221 2653
.PUNKT 8:
..PNR H6
..NØH
2929 1750 18991
.SLUTT



Lindås, gnr 96 bnr 14,
Data frå utstikking

25.06.2014

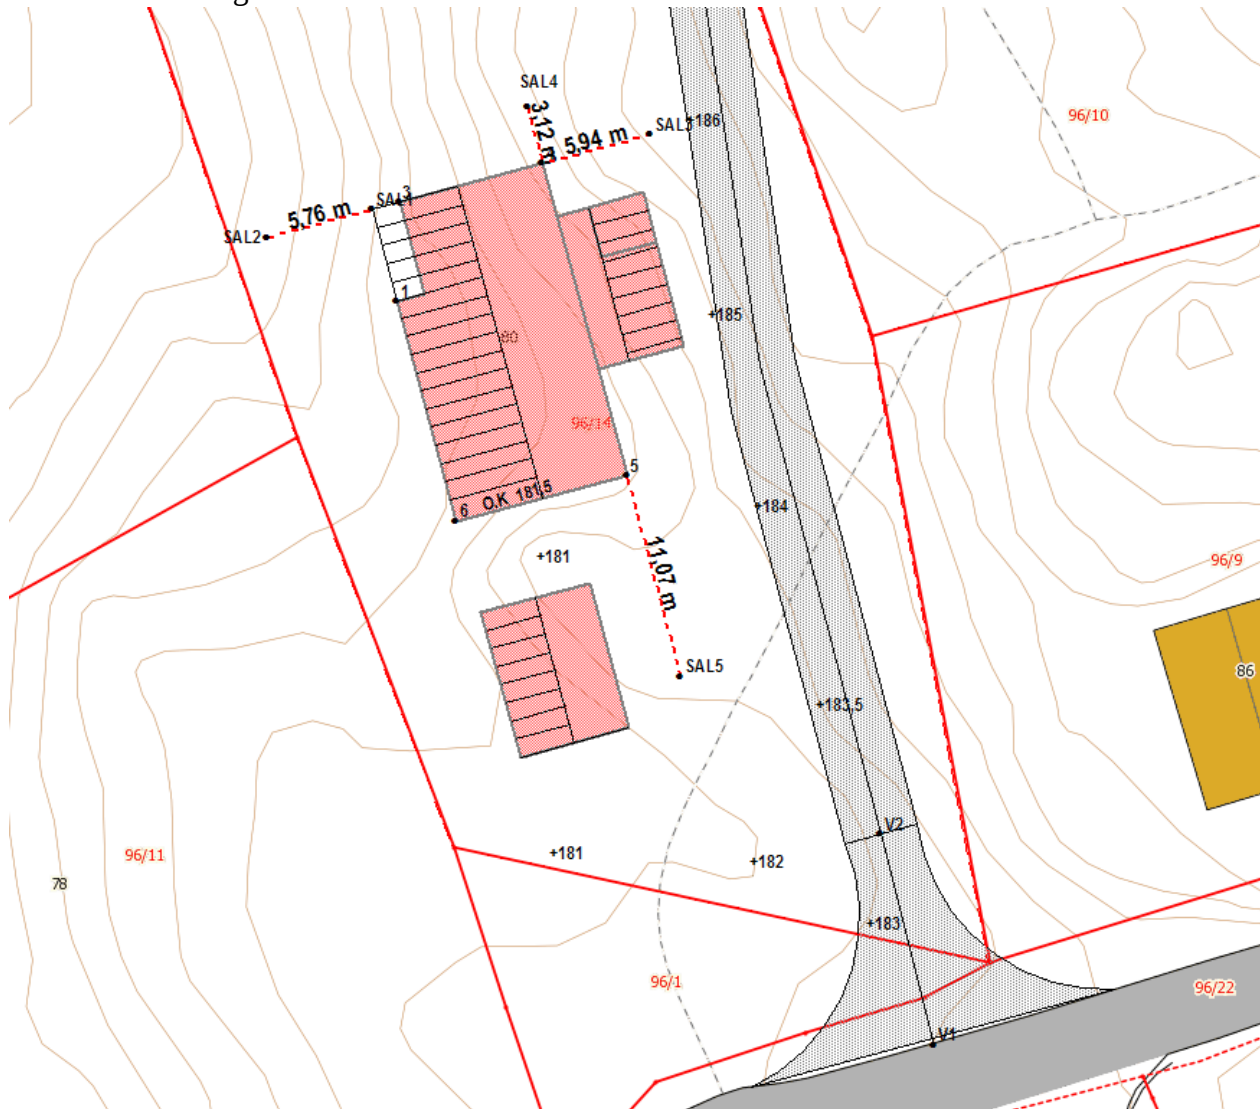

PunktID	N-koord.	Ø-koord.	Høyde	Status
1	6734898,98	295620,58	180,58	Spray
3	6734904,30	295620,70	180,56	Spray
4	6734906,35	295628,32	181,27	Spray
5	6734889,75	295632,79	181,10	Spray
6	6734887,31	295623,73	181,35	Spray
SAL1	6734903,91	295619,25	180,59	Spray
SAL2	6734902,42	295613,69	179,63	Spray
SAL3	6734907,89	295634,05	183,46	Spray
SAL4	6734909,37	295627,51	182,39	Spray
SAL5	6734879,06	295635,67	181,62	Spray
V1	6734859,46	295649,12	183,05	Spray
V2	6734870,67	295646,29	182,92	Spray