




Lindås, gnr 96 bnr 14,
Data frå utstikking

25.06.2014

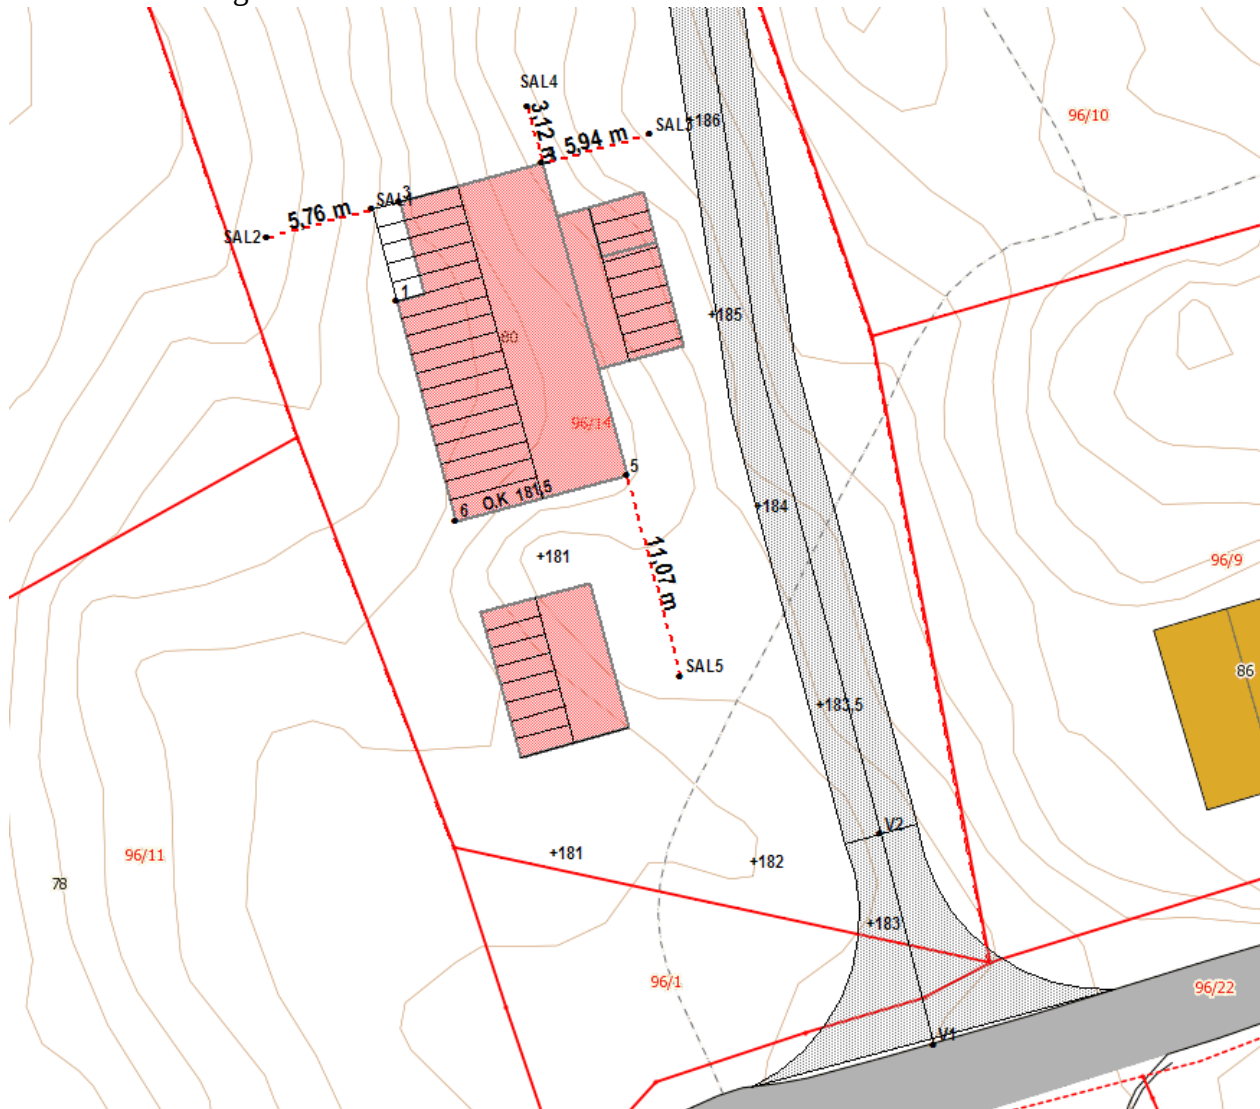

PunktID	N-koord.	Ø-koord.	Høyde	Status
1	6734898,98	295620,58	180,58	Spray
3	6734904,30	295620,70	180,56	Spray
4	6734906,35	295628,32	181,27	Spray
5	6734889,75	295632,79	181,10	Spray
6	6734887,31	295623,73	181,35	Spray
SAL1	6734903,91	295619,25	180,59	Spray
SAL2	6734902,42	295613,69	179,63	Spray
SAL3	6734907,89	295634,05	183,46	Spray
SAL4	6734909,37	295627,51	182,39	Spray
SAL5	6734879,06	295635,67	181,62	Spray
V1	6734859,46	295649,12	183,05	Spray
V2	6734870,67	295646,29	182,92	Spray