



PLAN 1 eta

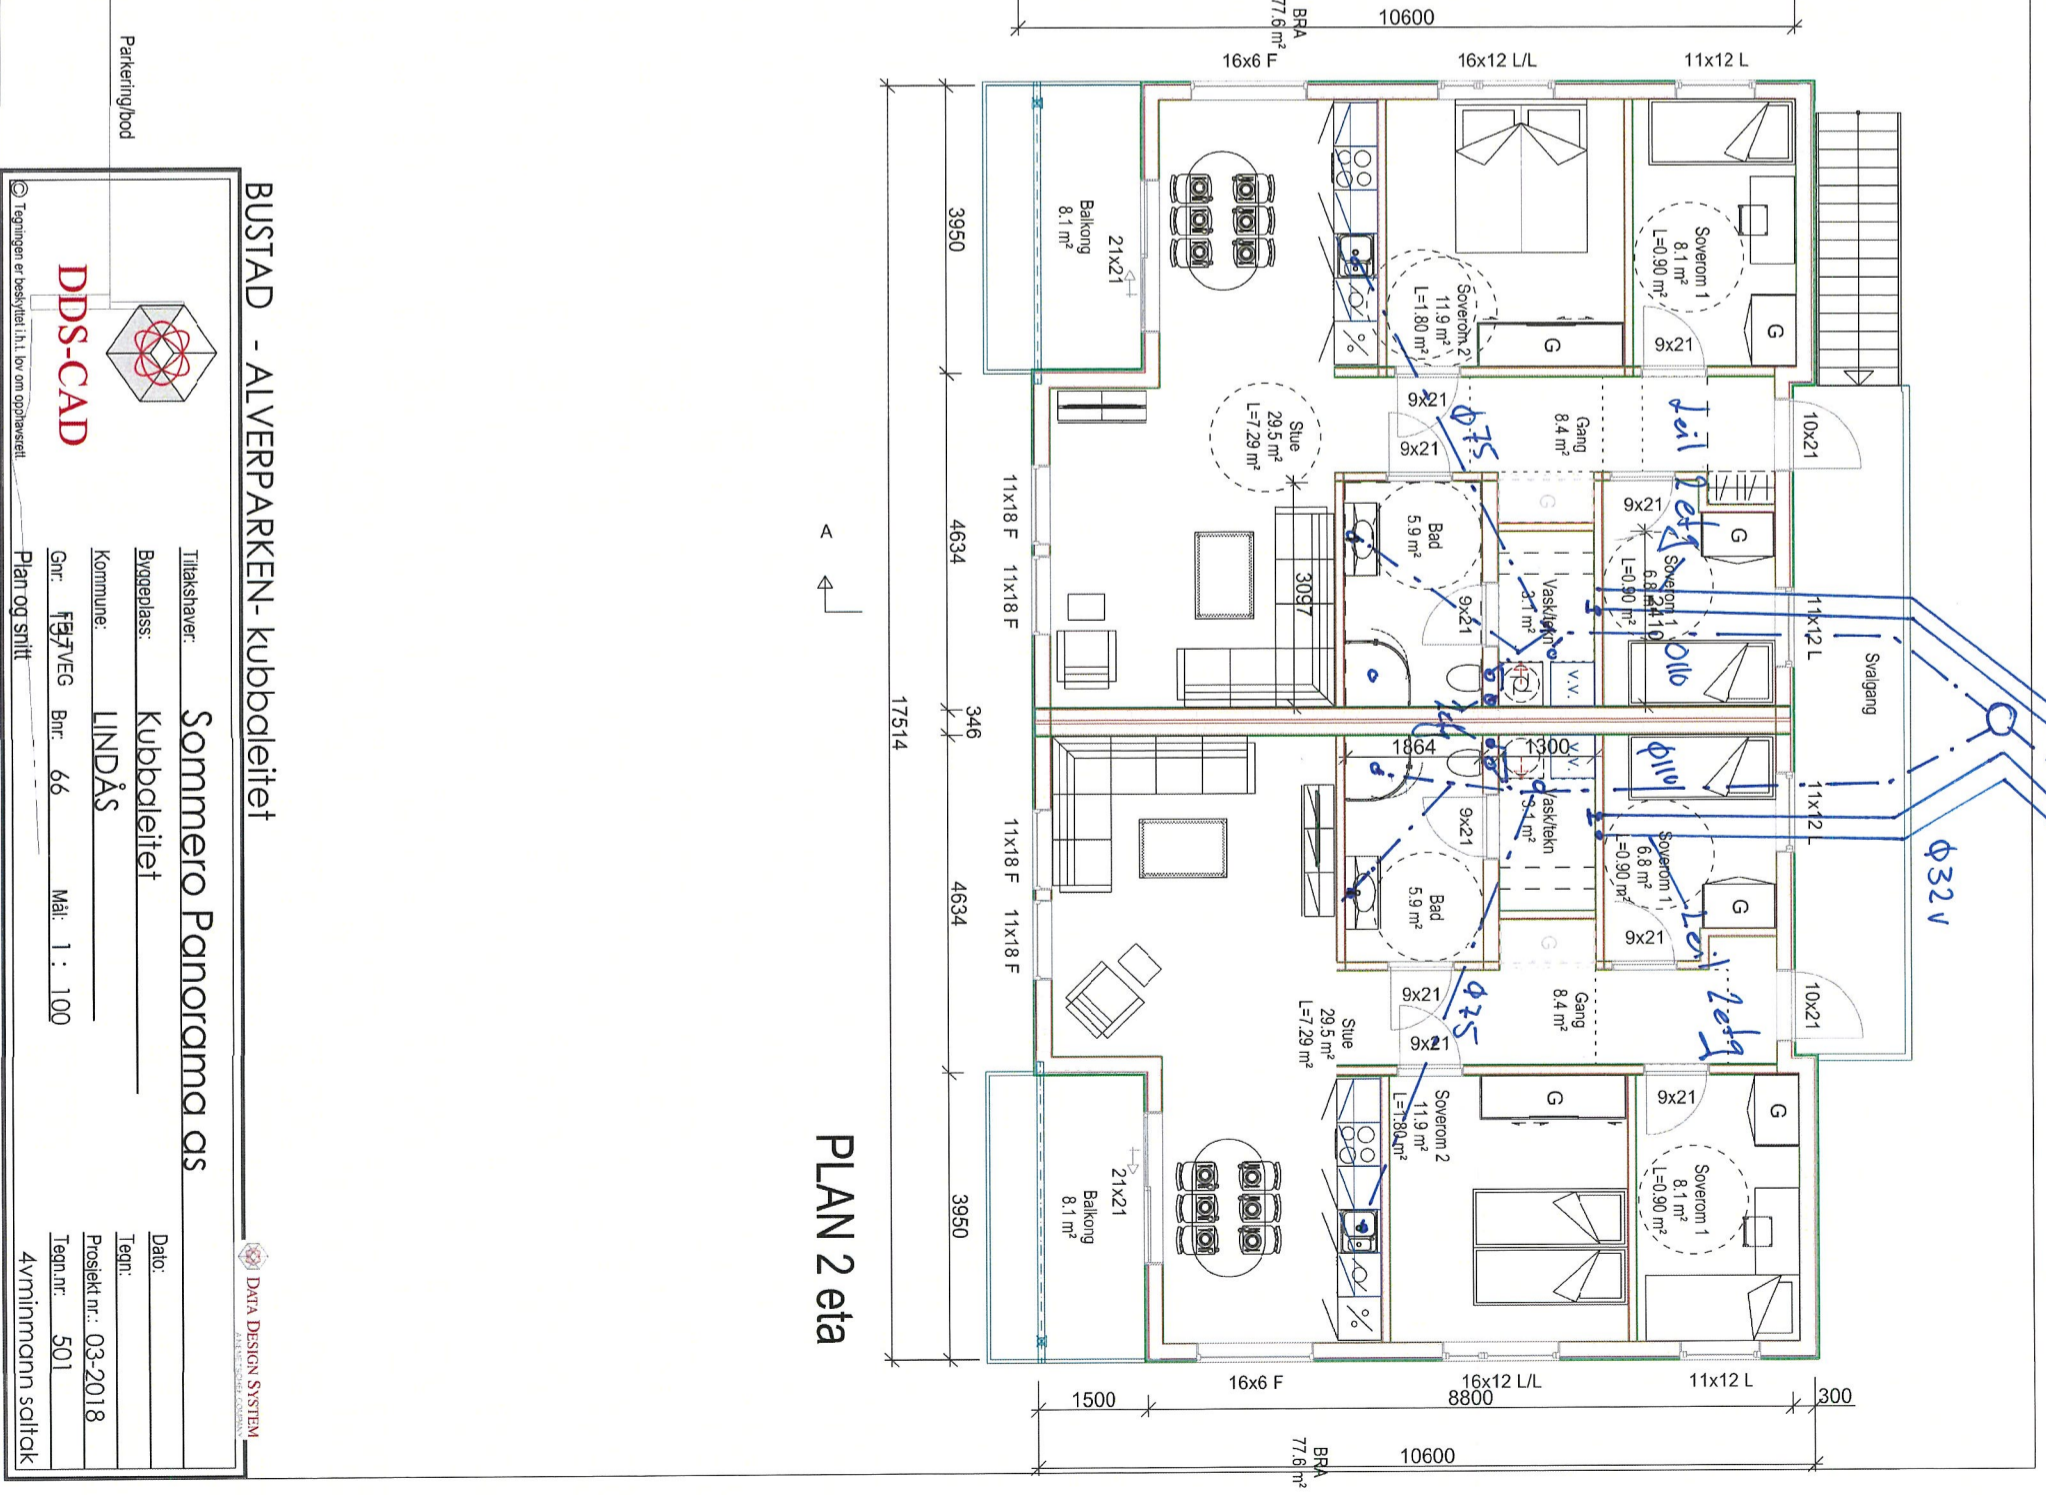

PLAN 2 eta

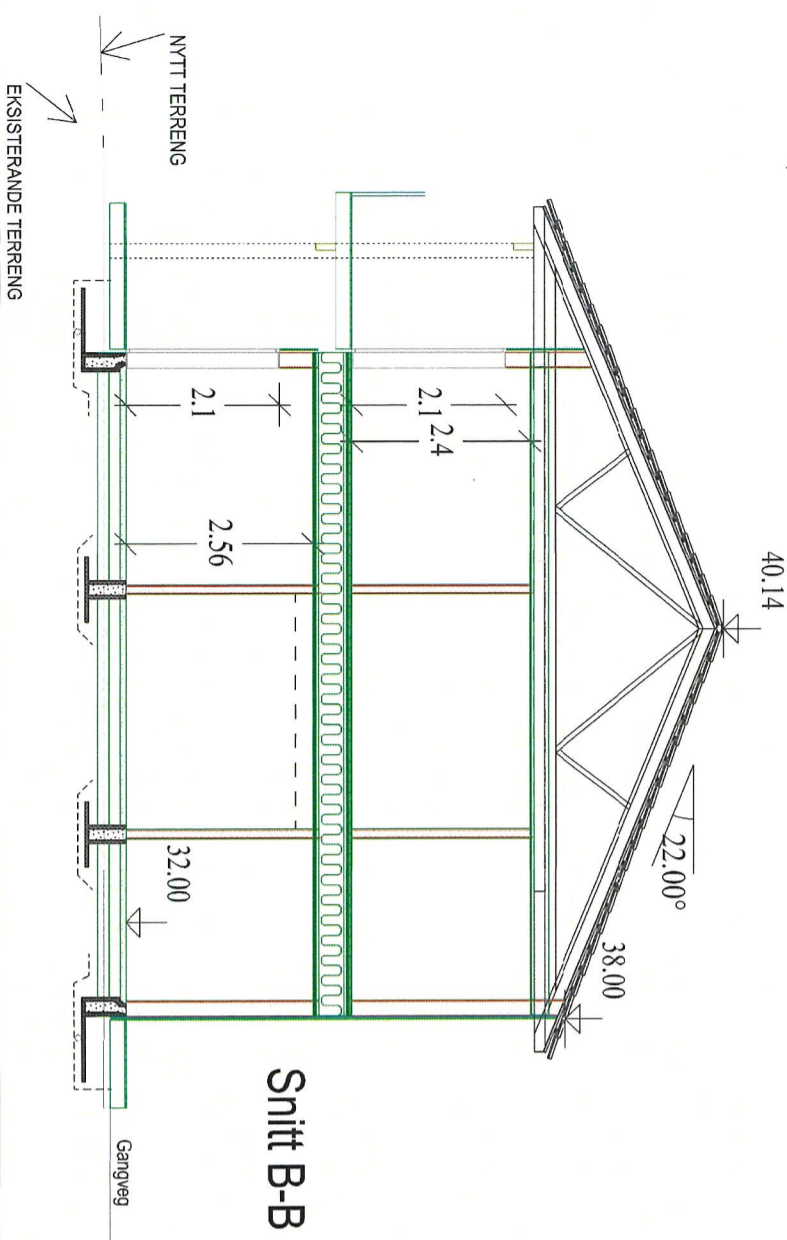

Snitt B-B







Plan og snitt

DDS-CAD


Tekn. nr.: **501**

4vimmann saltak

DATA DESIGN SYSTEM