

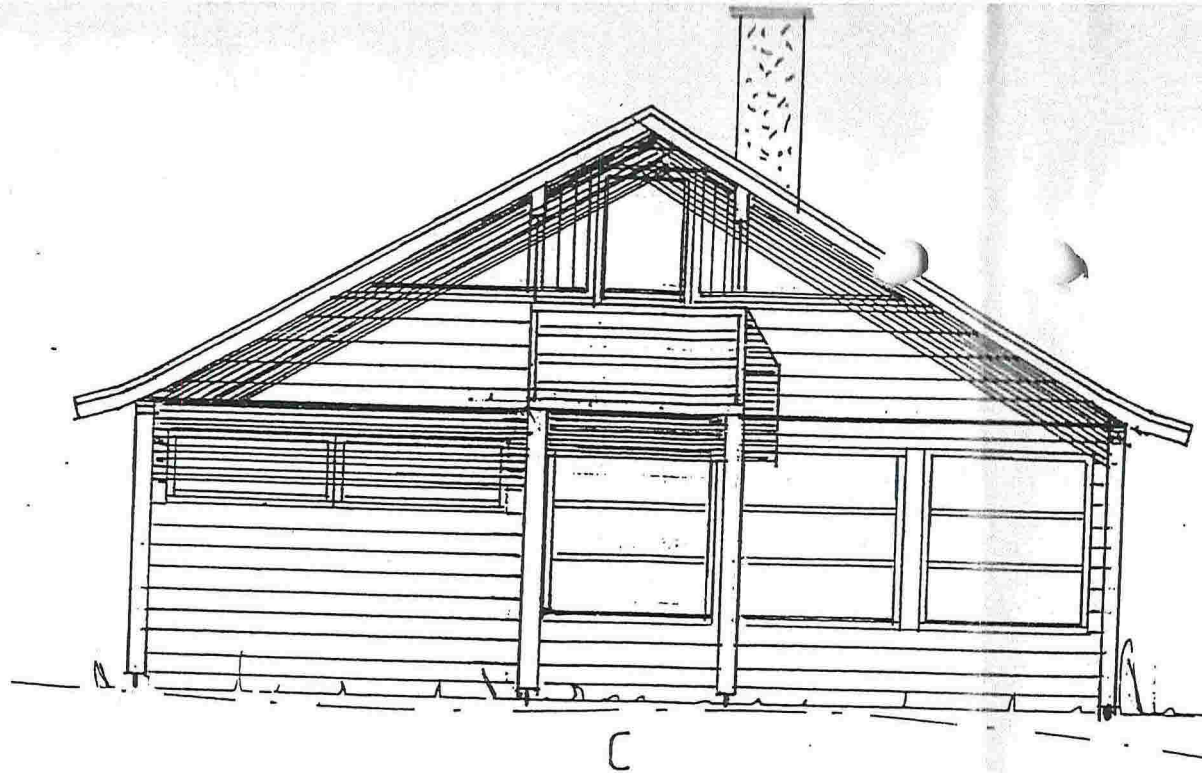


C
Fasade mot sør-vest

TILL BYSS

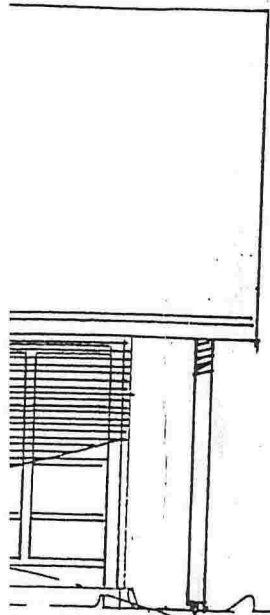

Fasade mot sør-vest

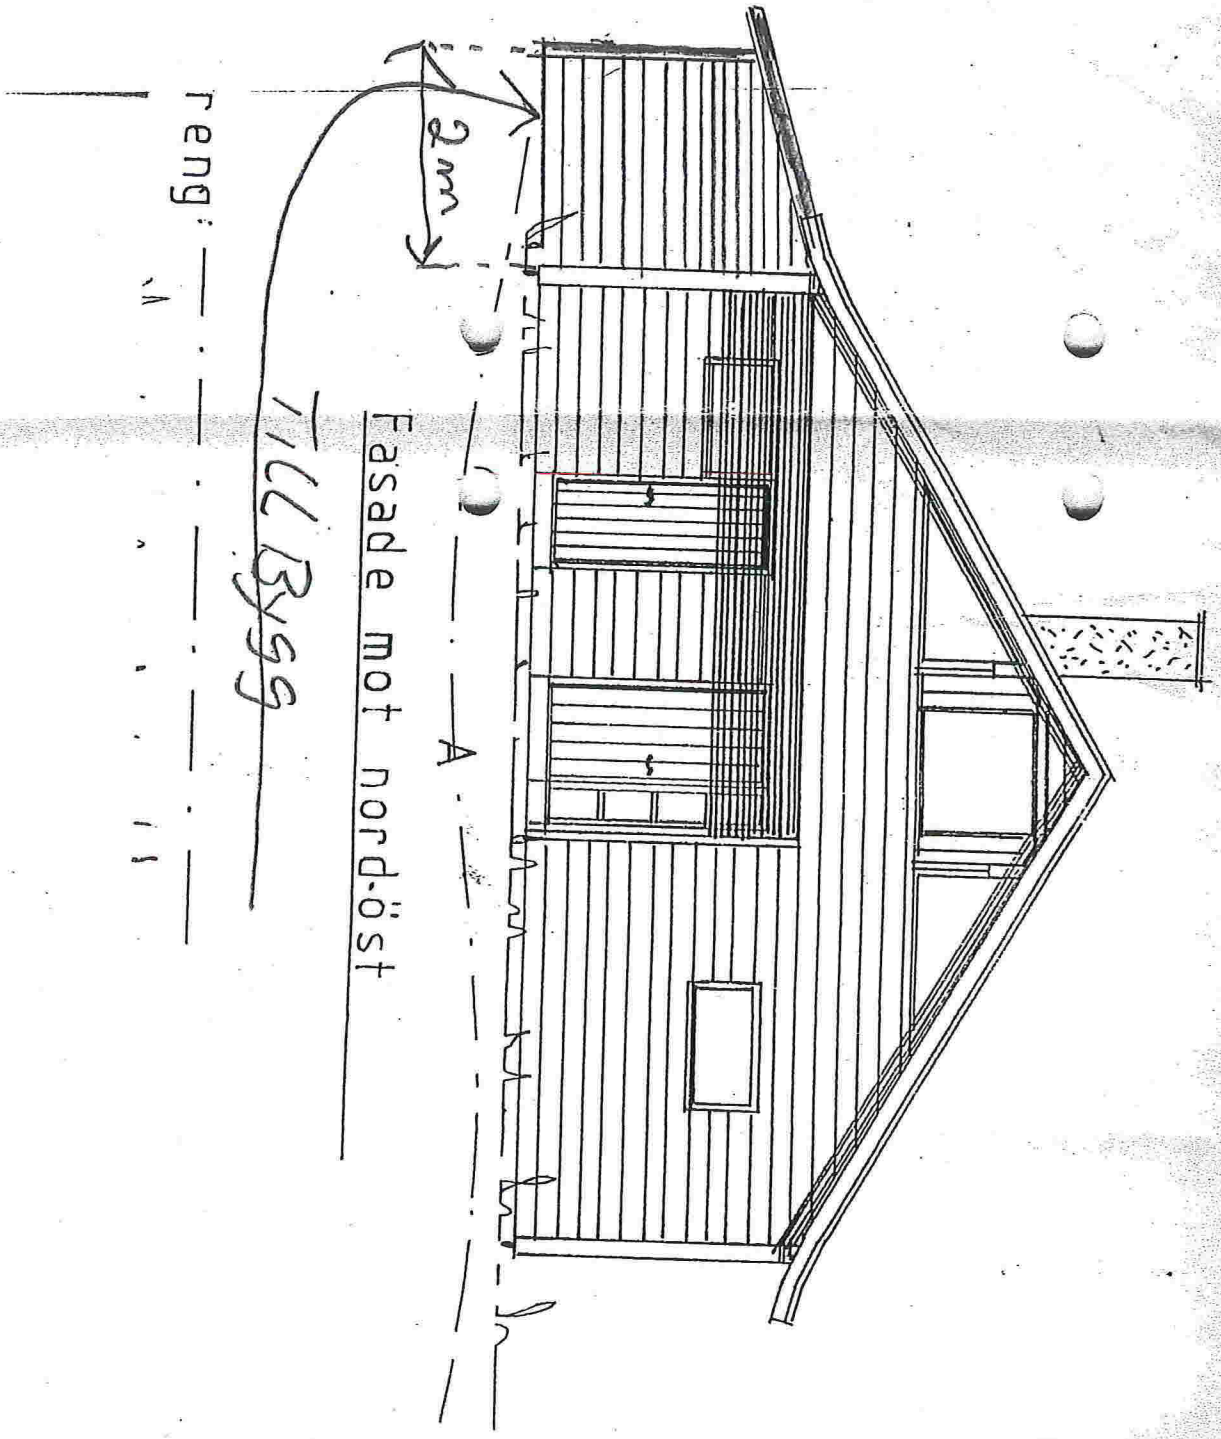


Rev. 16.12.86.

	ÖYSTEIN KVALHEIM		
	RISASJÖEN		
	Gnr: 123 E		
	Kommune: LINDÅS		
Mål: 1:100	Bra: 118,8m ²	Ba: 119m ²	Dato: 01.1
Sign: B.ORMARK	VILLANGER & SÖNNER A.S.		

reng: —




Fasade mot nord-öst

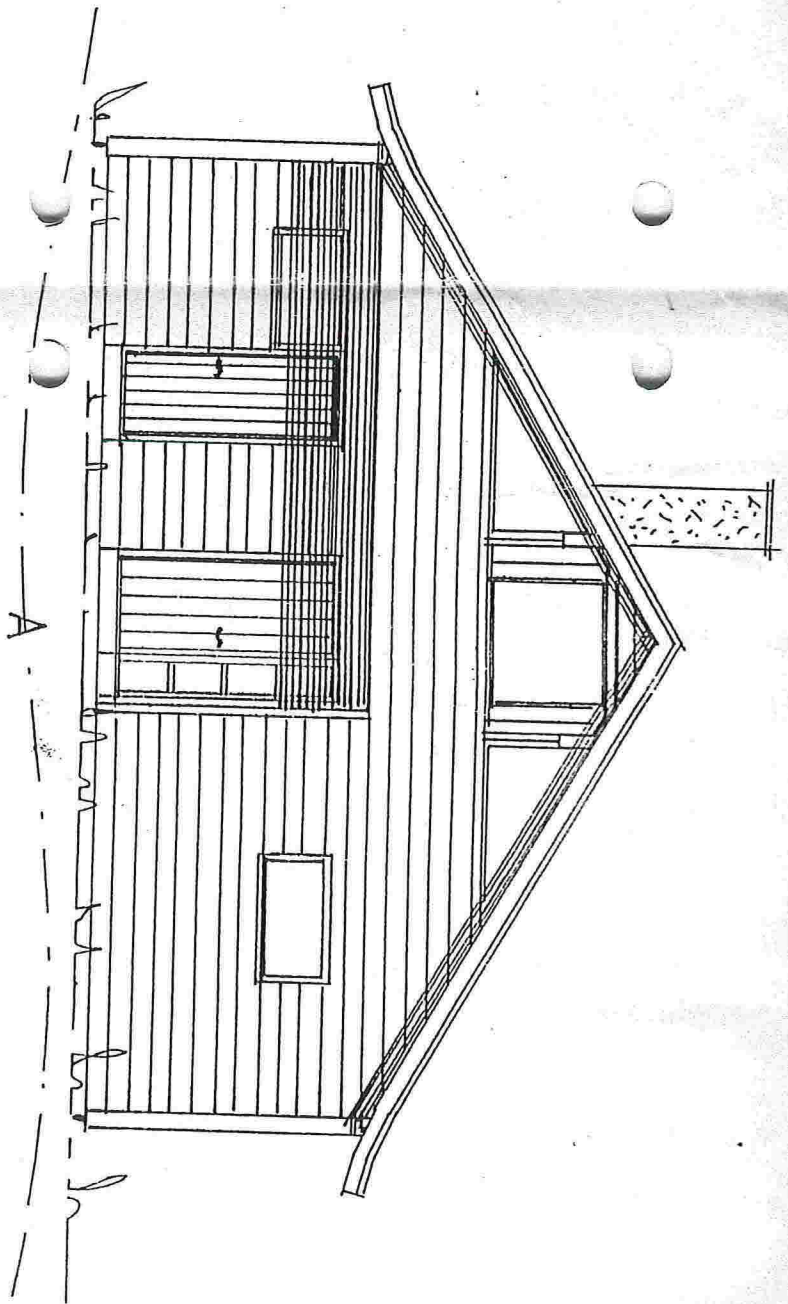

Rev. 16.12.86.

	ÖYSTEIN KVALHEIM		
	RISASJÖEN		Gnr: 123 E
	Kommune: LINDÅS		
Mål: 1:100	Bra: 118,8m ²	Ba: 119m ²	Dato: 01.1
Sign: B.ORMARK	VILLANGER & SÖNNER A.S.		

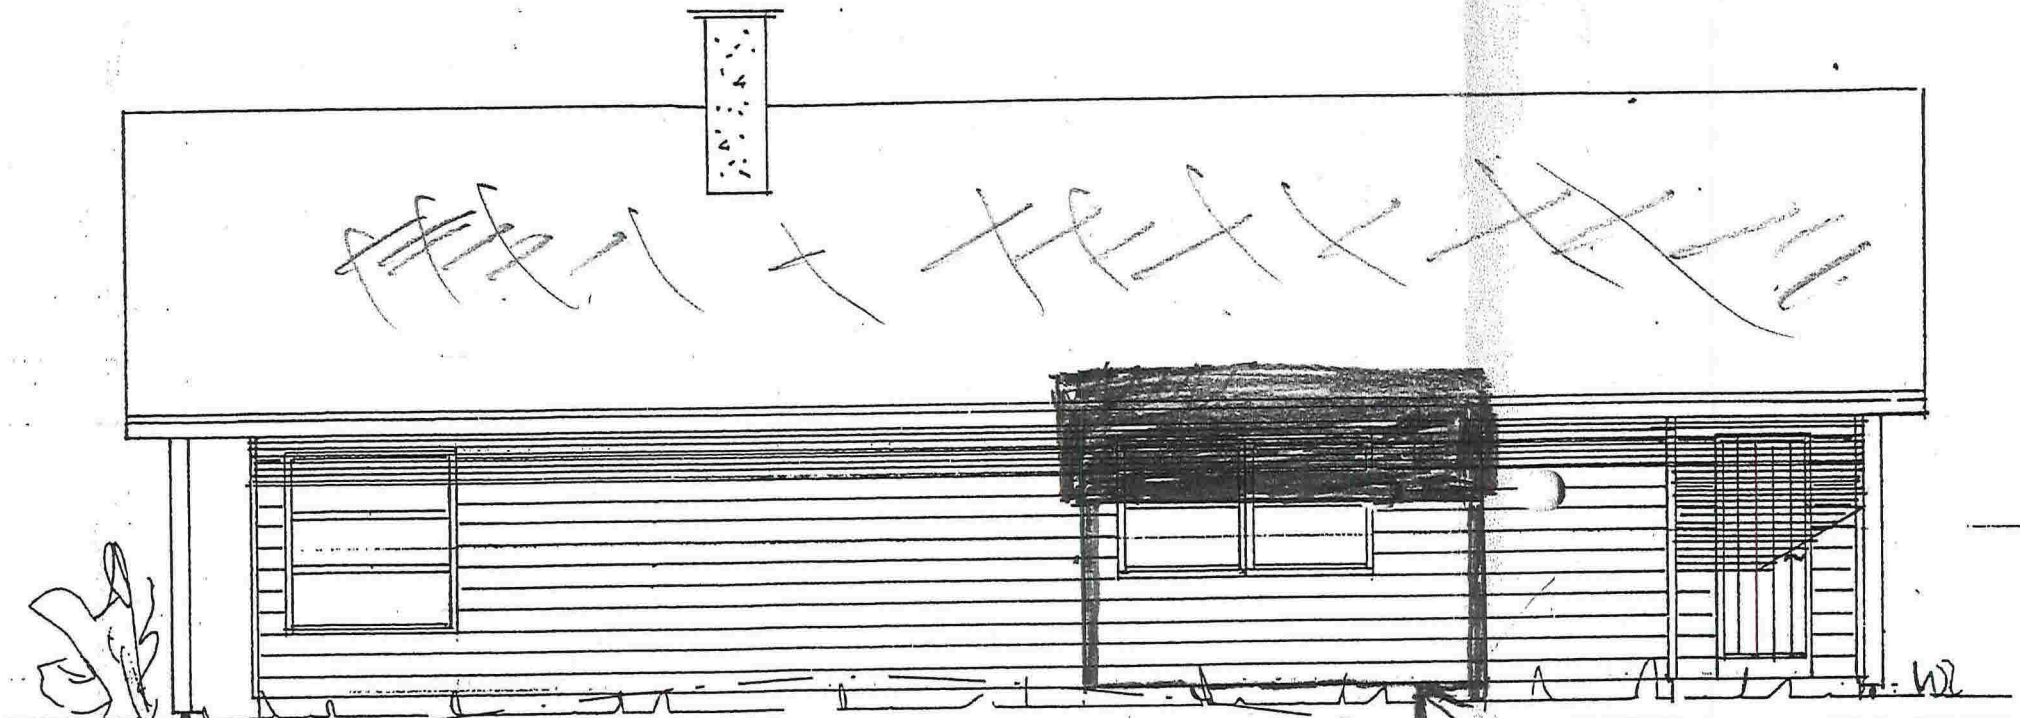


~~Handwritten scribbles and lines across the top of the drawing.~~

D ← 4 m. →

Fasade mot sør-öst

TILLBYGG

Eksisterer

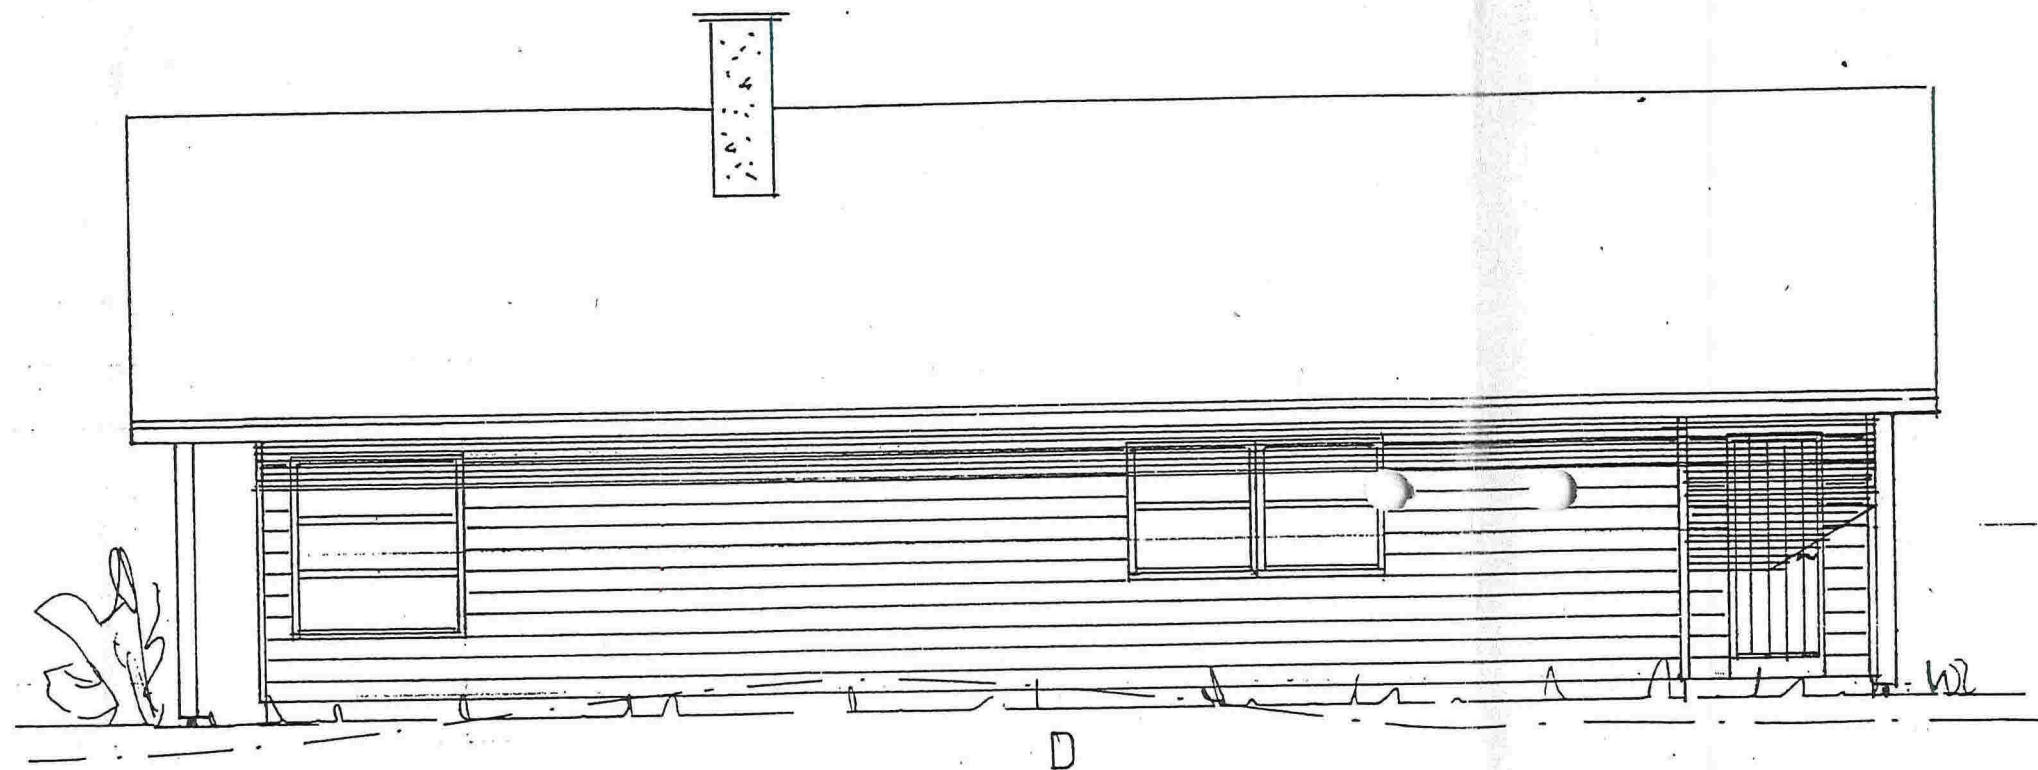

Fasade mot sør-öst

Eksisterer