


293305  
723412


293362  
X 6723

D2

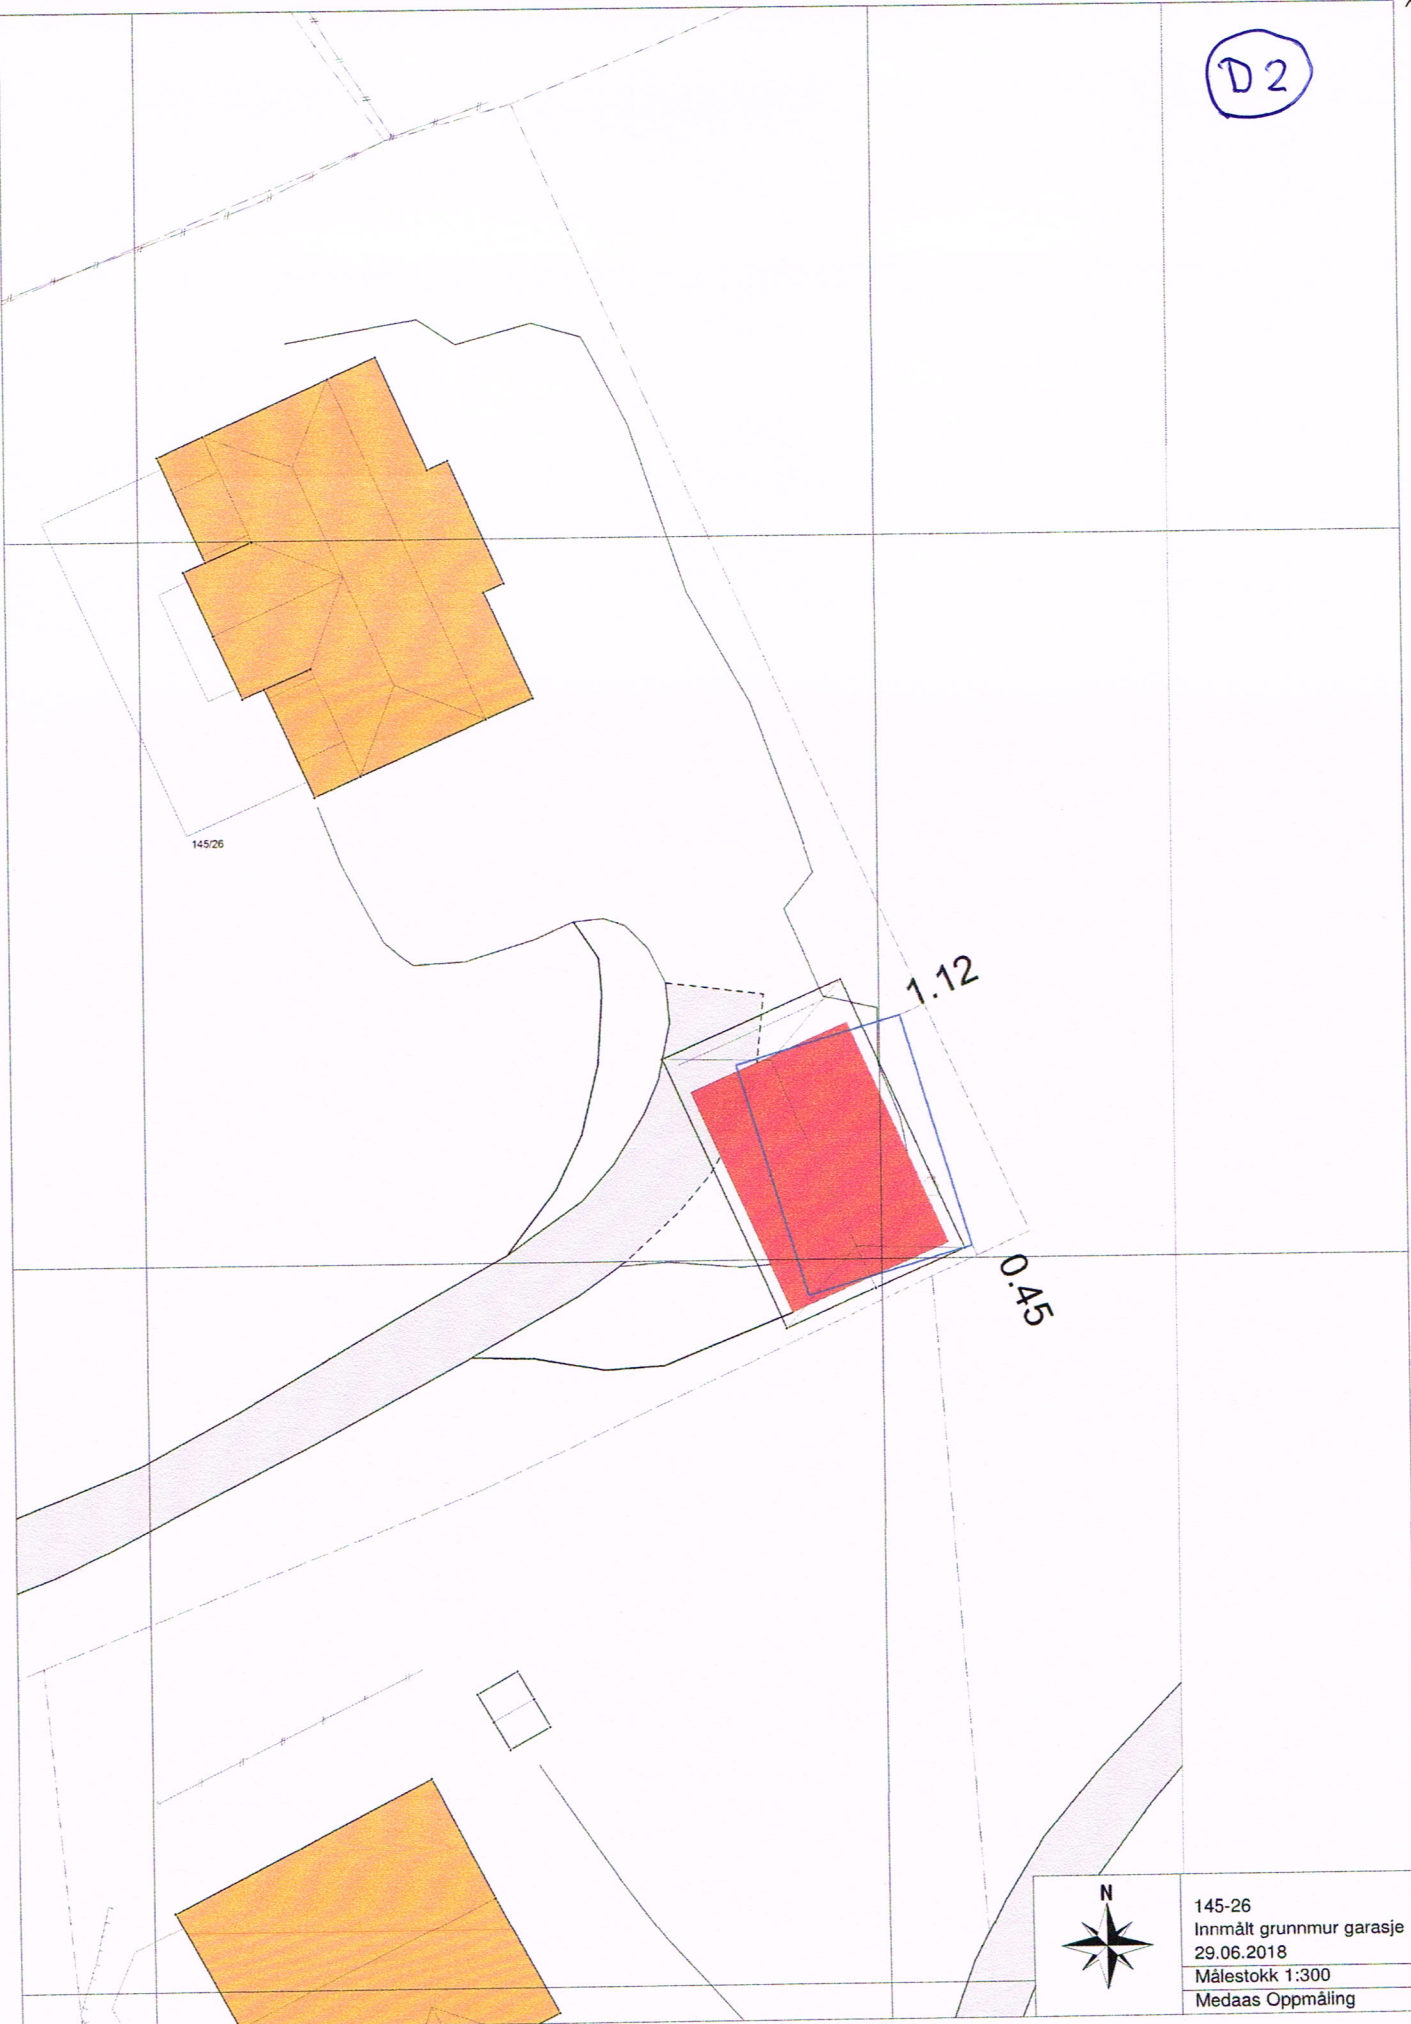

723328  
29331

Y 29331  
X 67

	145-26
	Innmålt grunnmur garasje
	29.06.2018
	Målestokk 1:300
Medaas Oppmåling	