
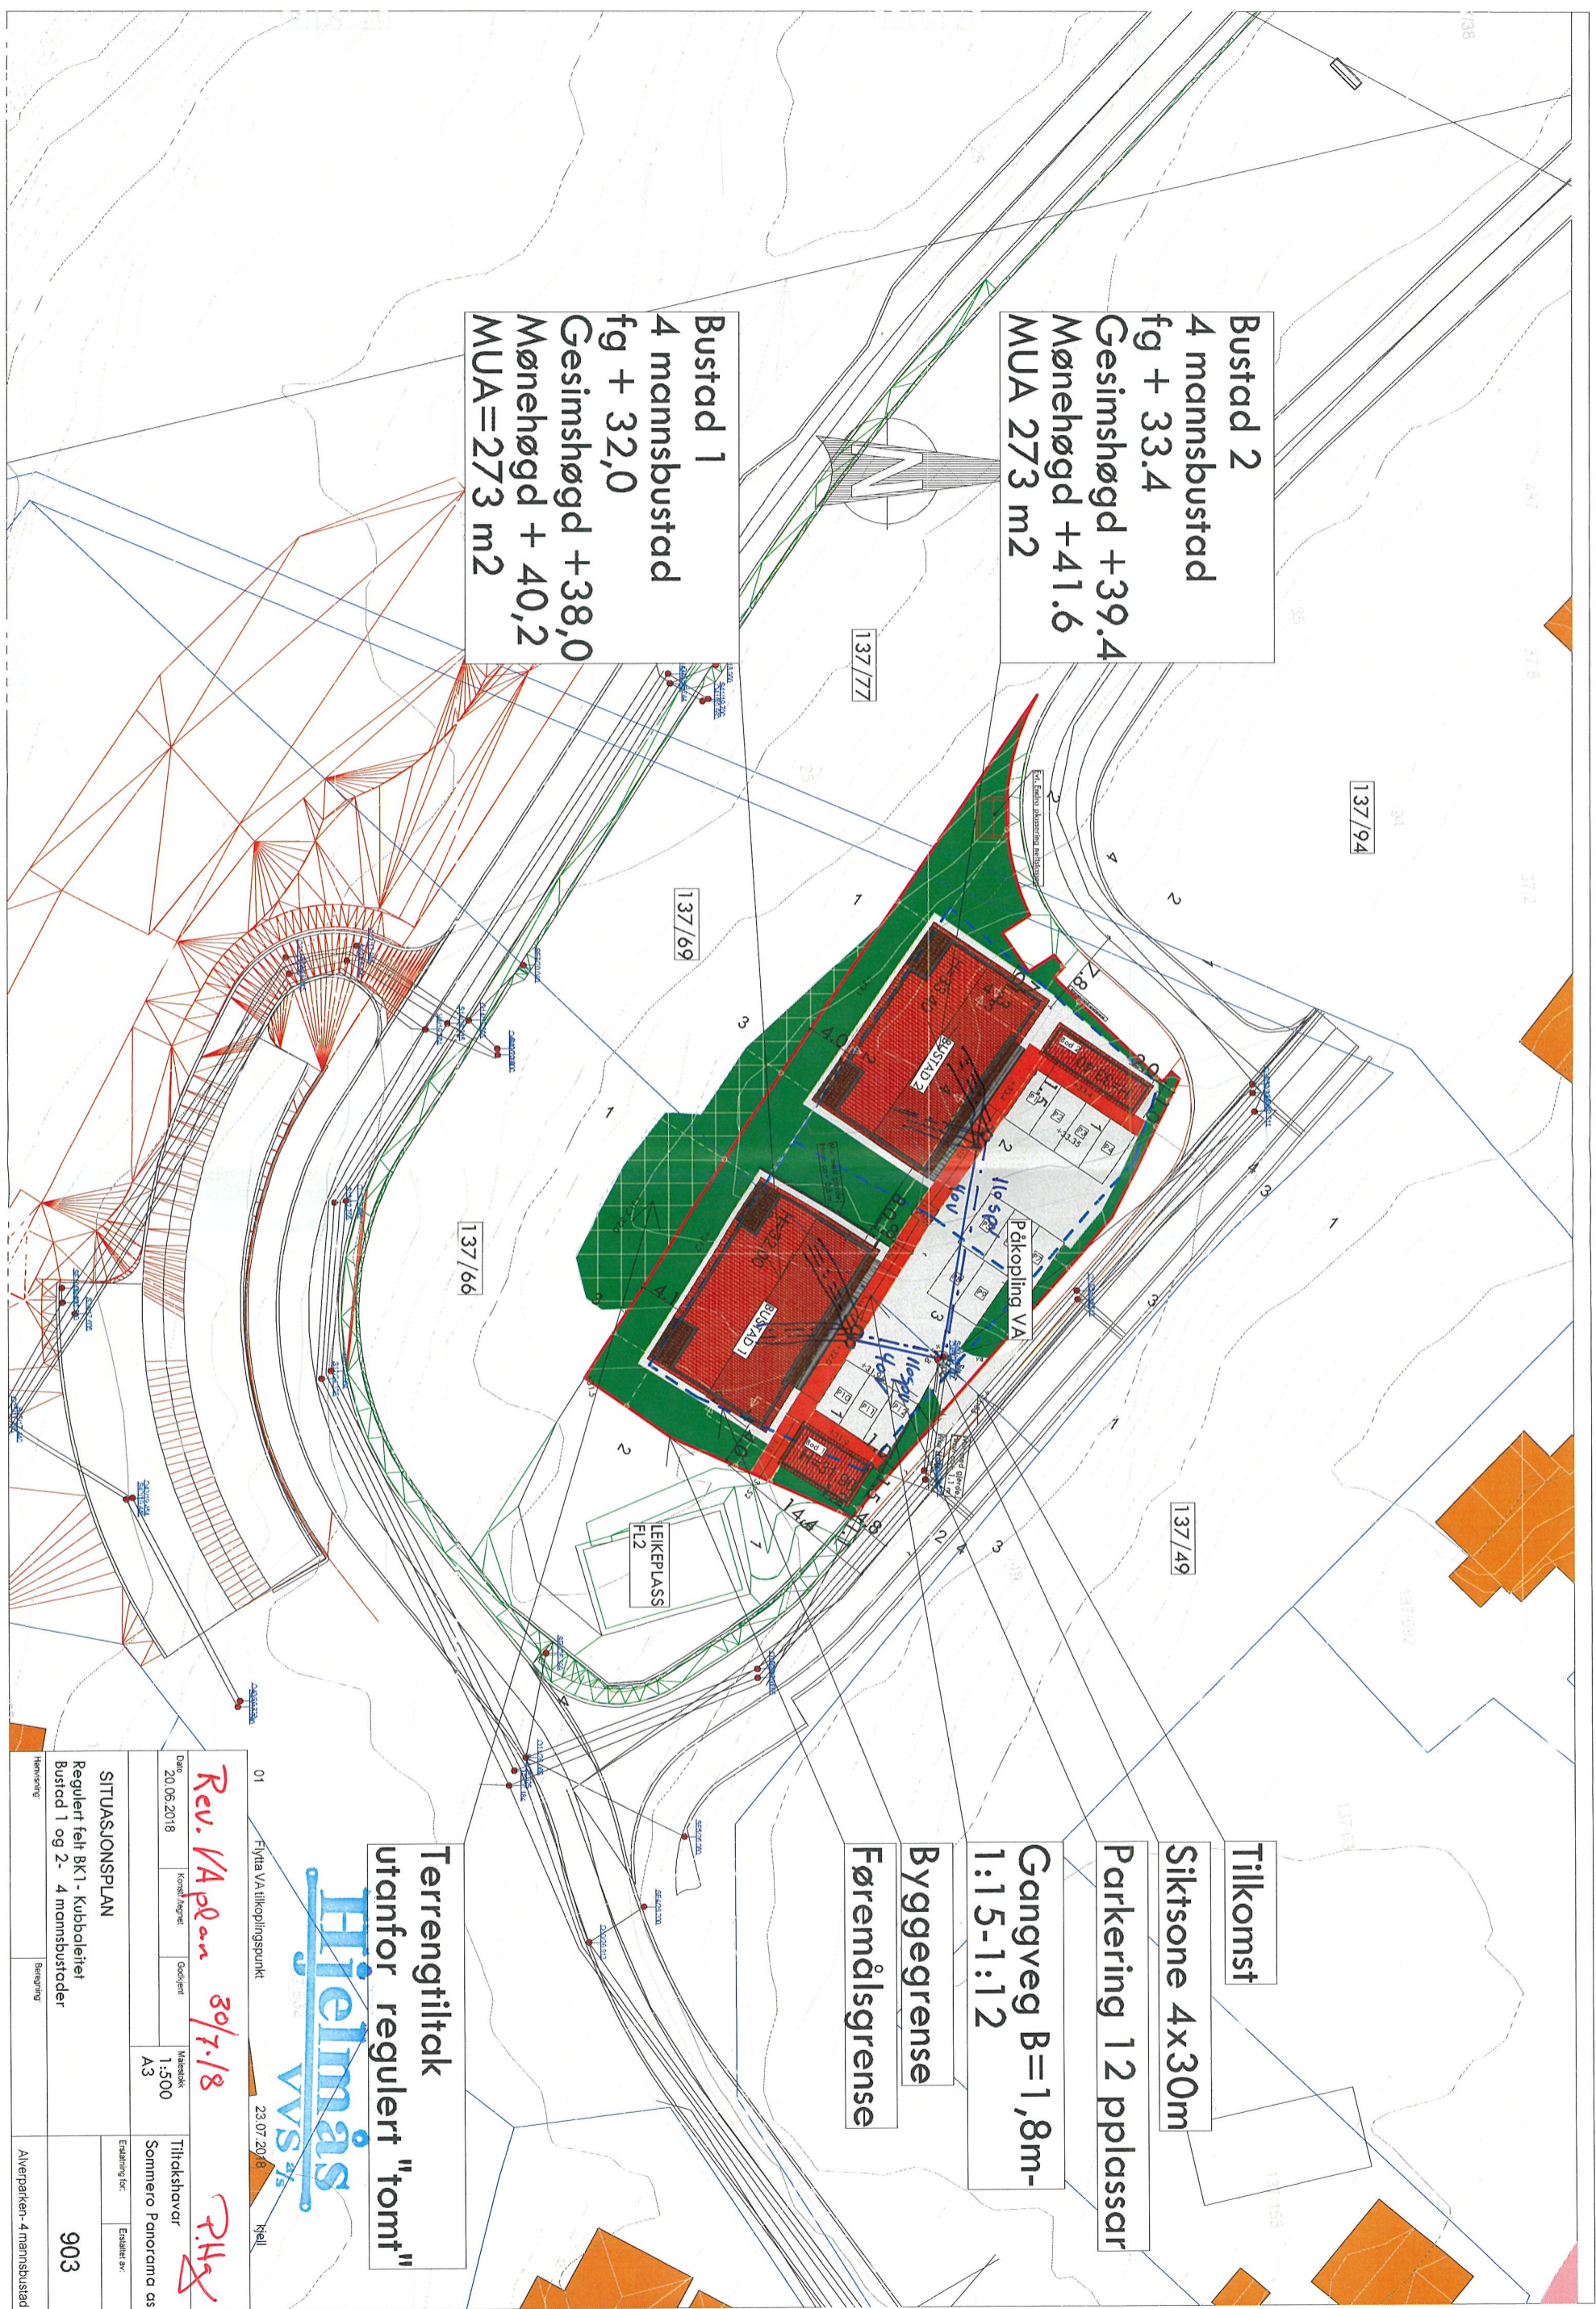


**Bustad 2**  
 4 mannsbustad  
 fg + 33.4  
 Mønehøgdd +41.6  
 MUA 273 m<sup>2</sup>

**Bustad 1**  
 4 mannsbustad  
 fg + 32,0  
 Gesimshøgdd +38,0  
 Mønehøgdd + 40,2  
 MUA=273 m<sup>2</sup>

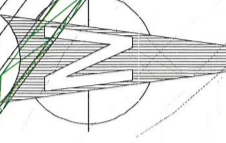

**Tilkomst**

Siktzone 4x30m

Parkering 12 plassar

Gangveg B=1,8m-  
 1:1.5-1:1.2

Byggegrense

Føremålsgrense


**Terrengeiltak**  
 utanfor regulert "tomt"




01 Fjvta VA tilkoplingspunkt 23.07.2018 Kjell

*Rev. Vaplan 30/7.18* *PHG*


SITUASJONSPLAN		Tilleshaver		Sommero Panorama as	
Date	Kont./Angr.	Godk.	Masstokk	Etalering or.	Estakke av.
20.06.2018			1:500	A3	
Regulert felt BK1 - Kubbolei			903		
Bustad 1 og 2 - 4 mannsbustader			Alveparken - 4 mannsbustad		
Hversting			Beregning		

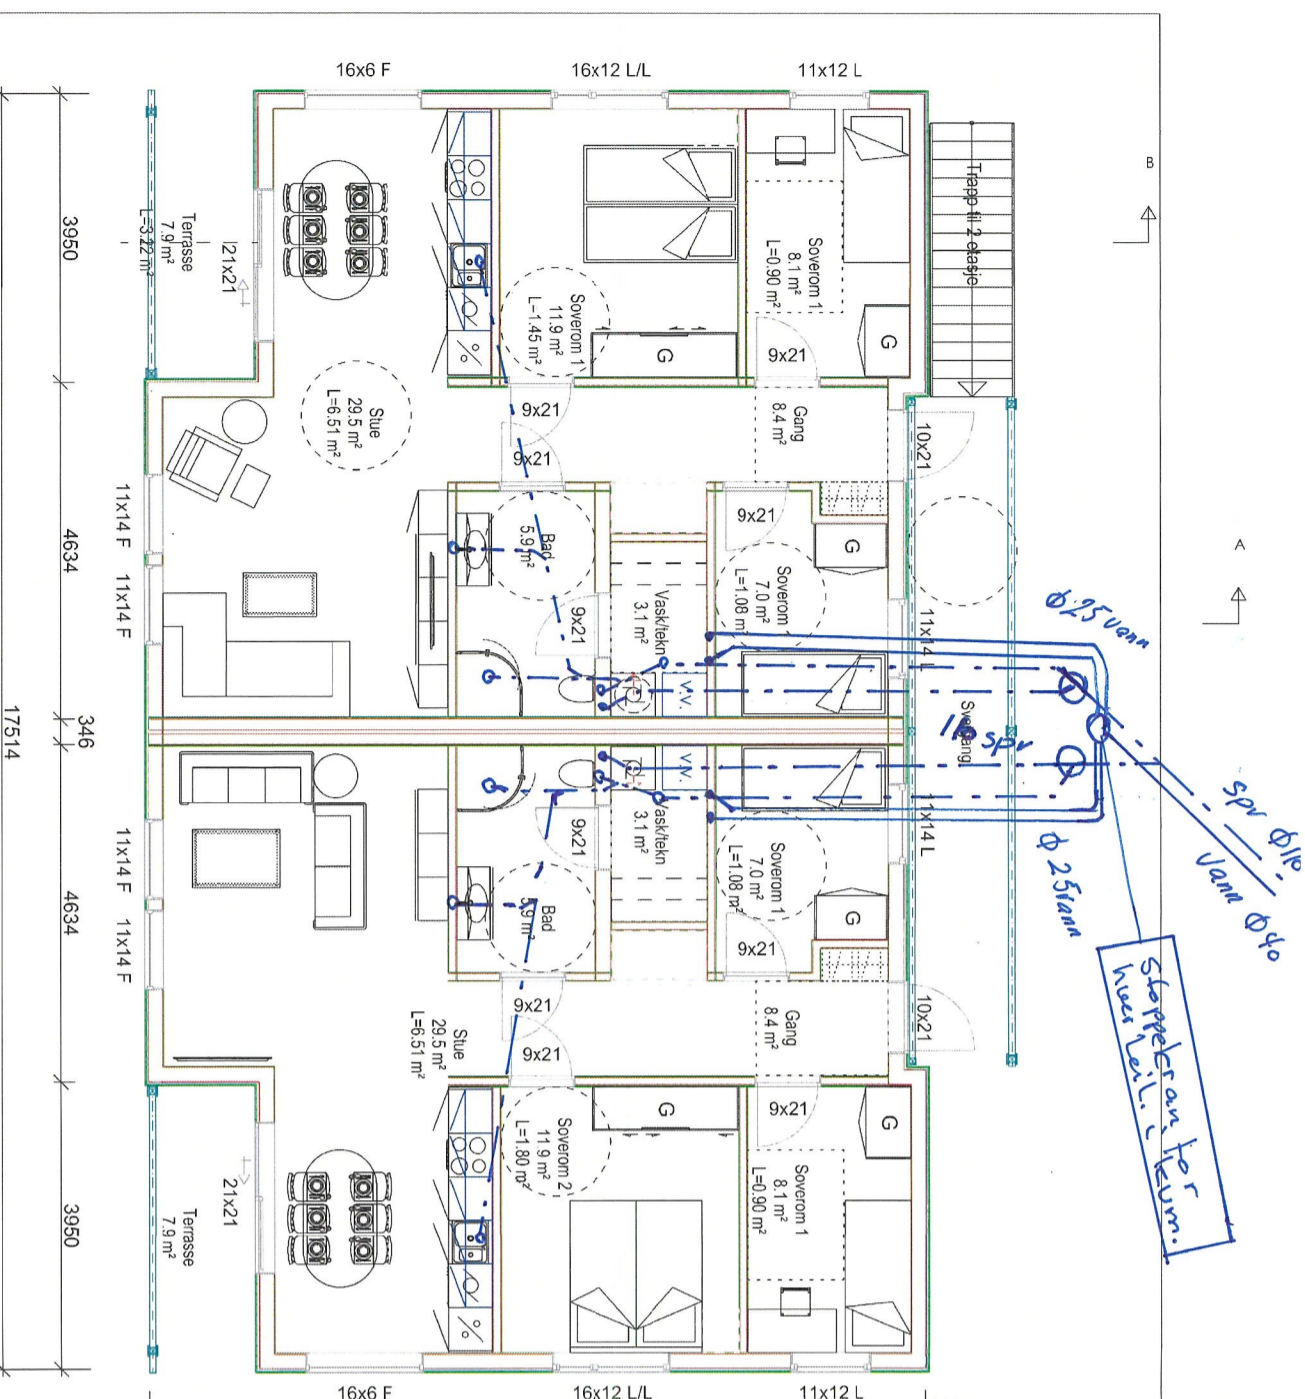

PLAN 1 eta

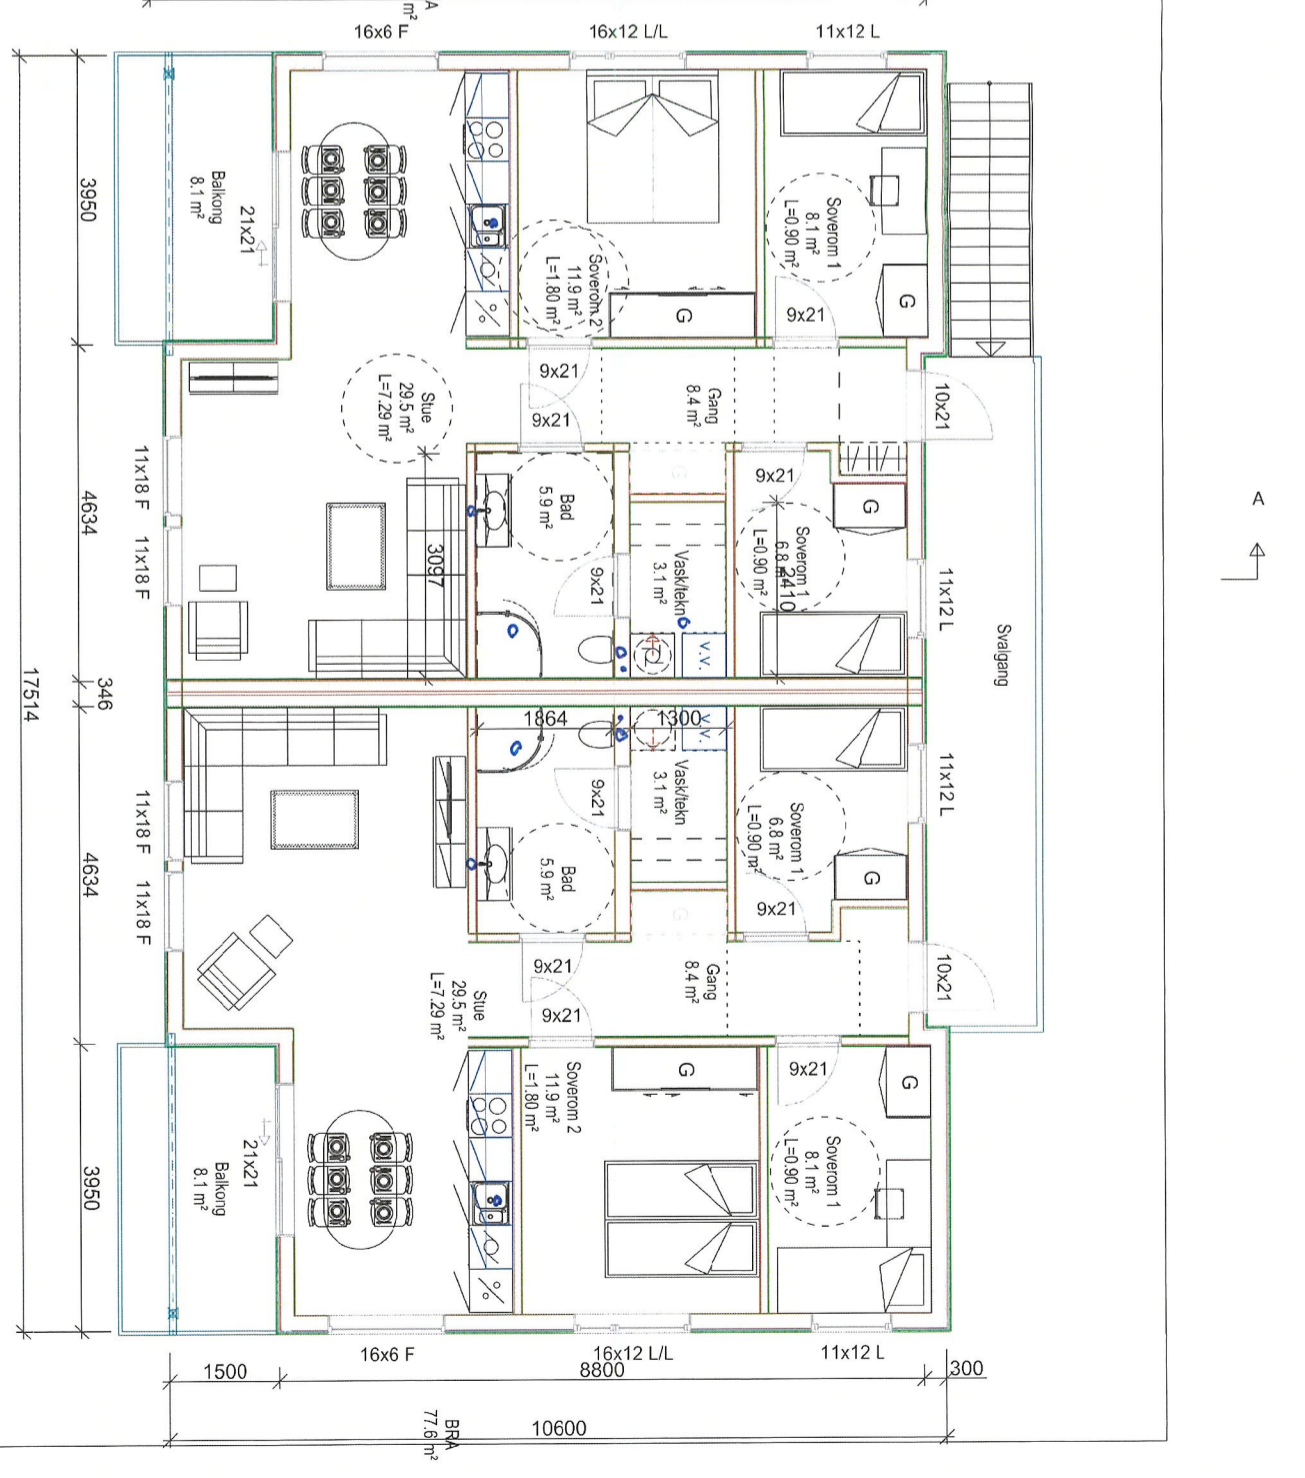

PLAN 2 eta

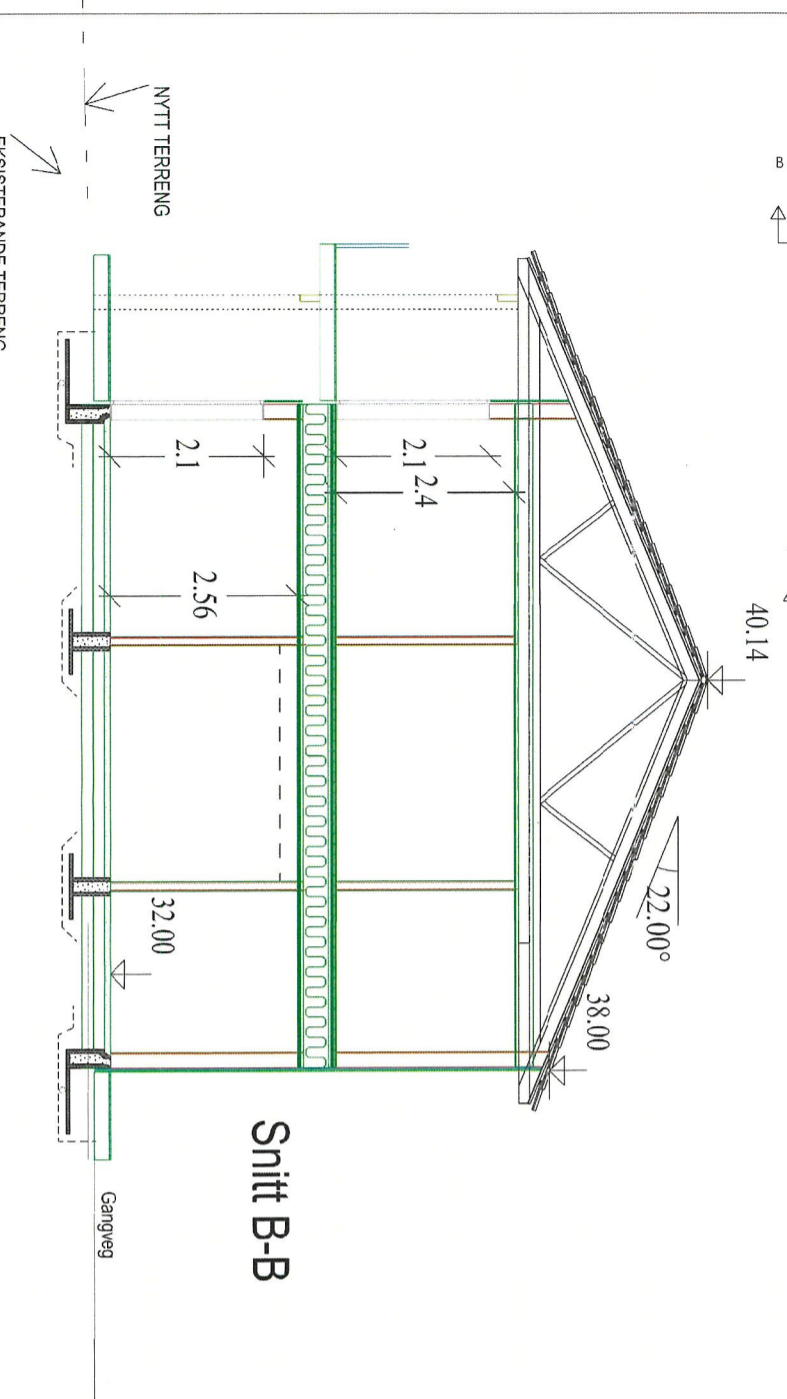

Snitt B-B

*Rev. V4 plan 30/7-18*

BUSTAD 1- ALVERPARKEN- kubbaleitet

**Hjeltnås**  
VVS AS

Sommero Panorama as


**DDS-CAD**  
 © Tegningen er beskyttet i.h.t. lov om opphavsrett.

Tiltektshaver:	Sommero Panorama as
Byggeplass:	Kubbaleitet
Kommune:	LINDÅS
Gnr.:	F37VEG
Bnr.:	66
Mål:	1 : 100
Plan og snitt	

Dato: \_\_\_\_\_  
 Teqn.: \_\_\_\_\_  
 Prosjekt nr.: 03-2018  
 Teqn.nr.: 501  
 4vminnmann seltfak