




PLAN 1 pr. 25.01.18

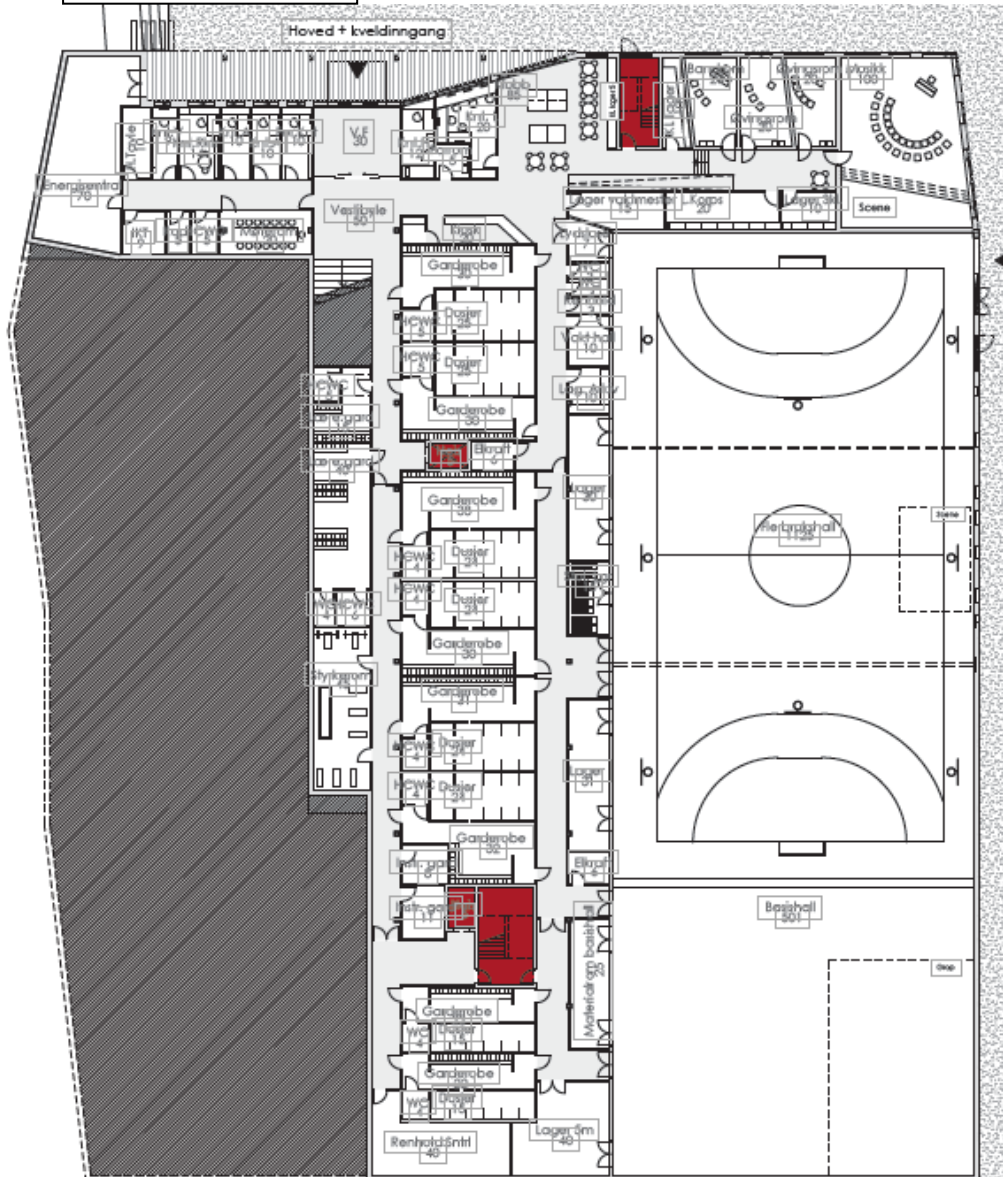


PLAN 1 pr. 17.06.18

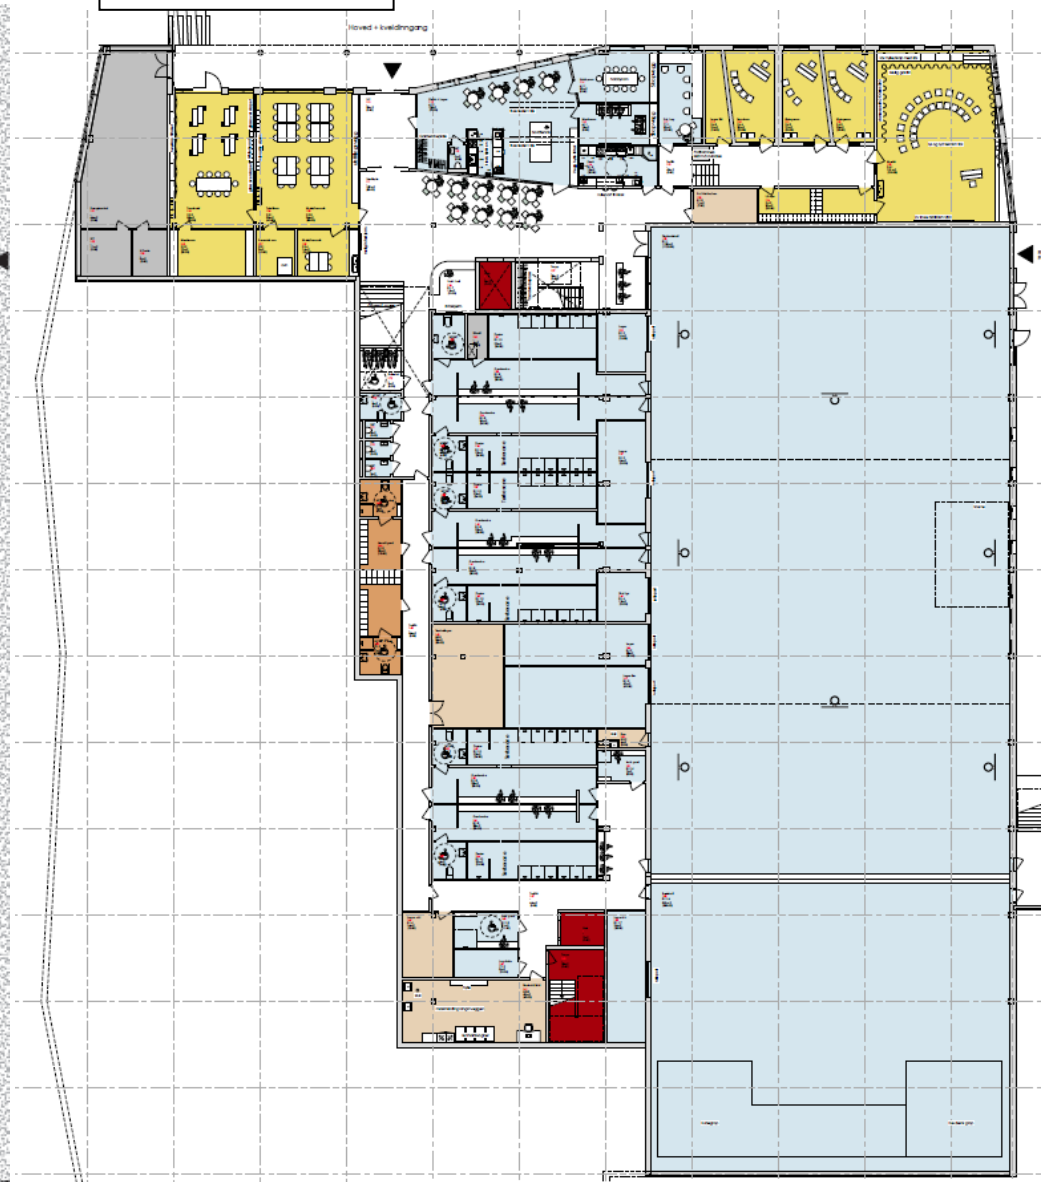


PLAN 2 pr. 25.01.18

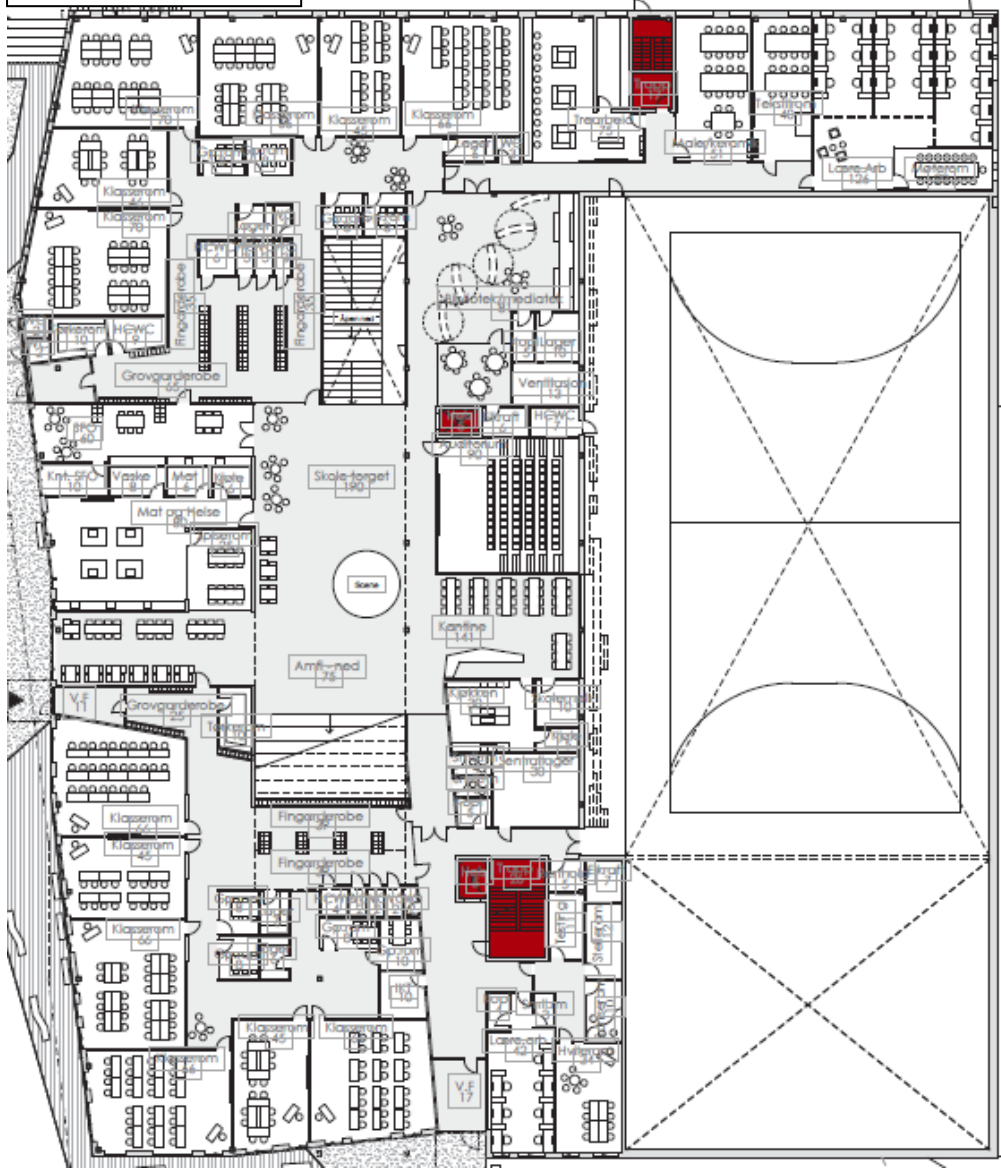

PLAN 2 pr. 17.06.18

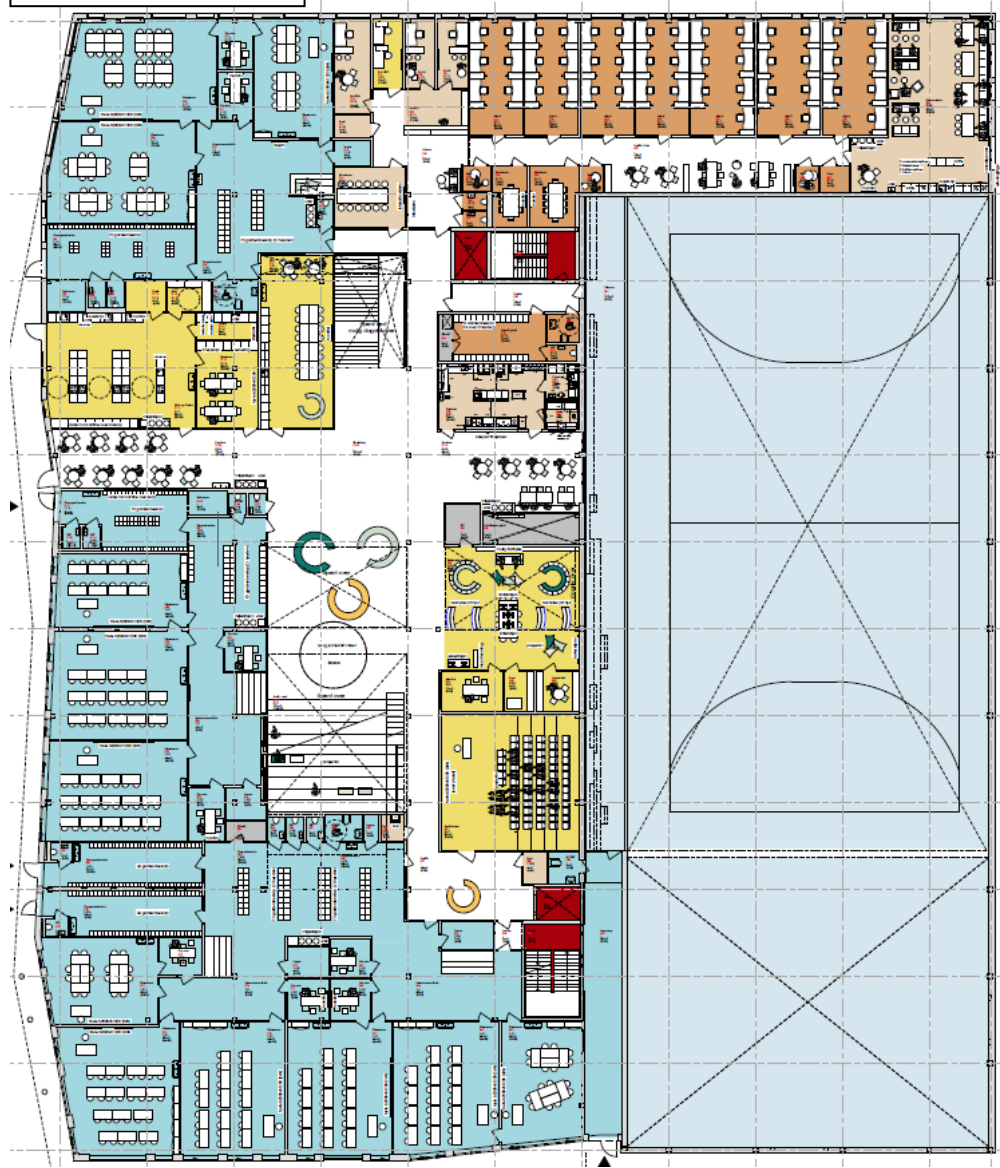

PLAN 3 pr. 25.01.18

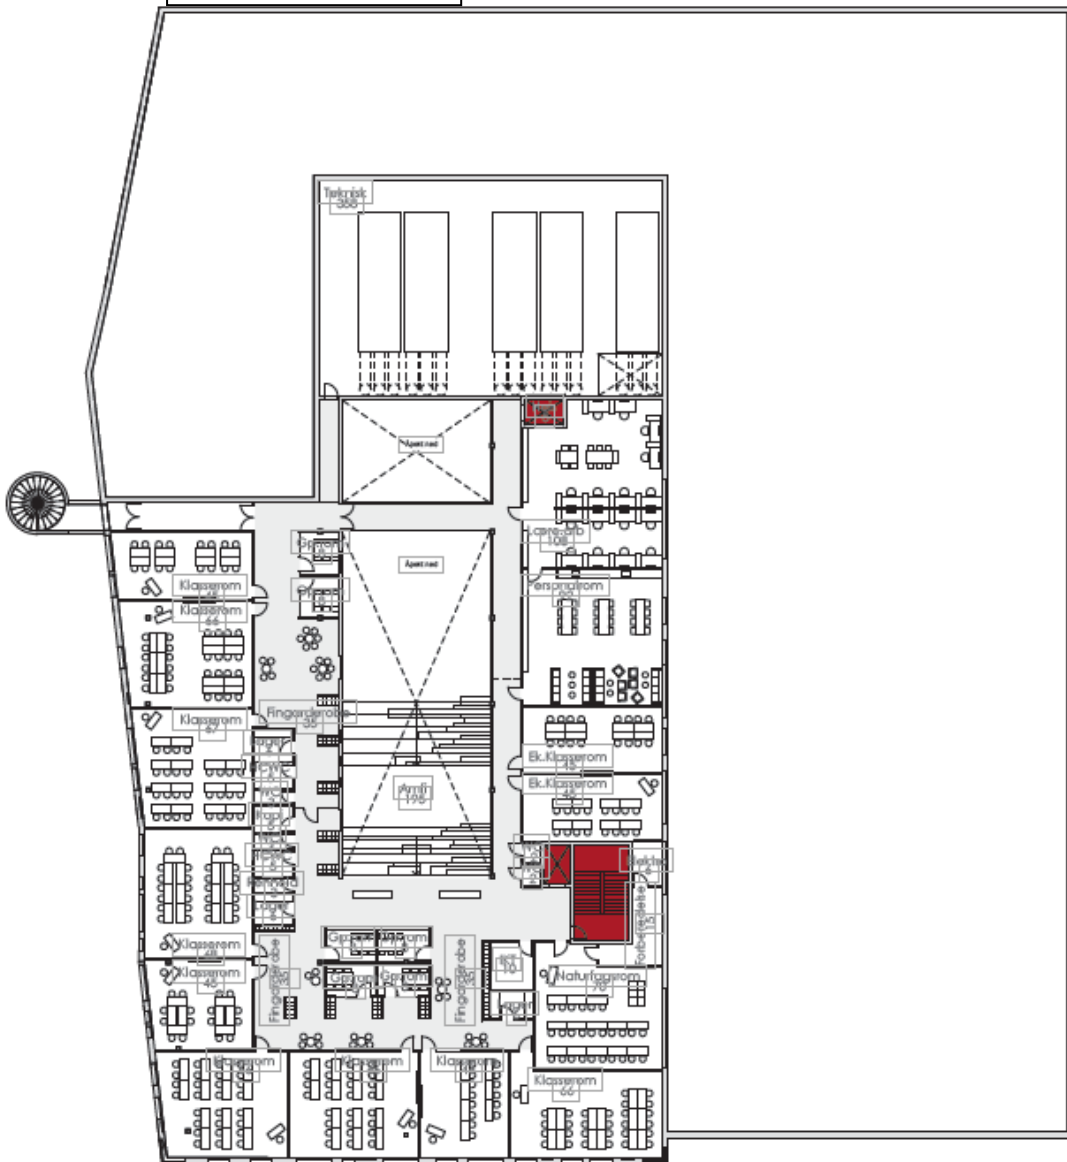

PLAN 3 pr. 17.06.18

