



N6727663, Ø291174 +

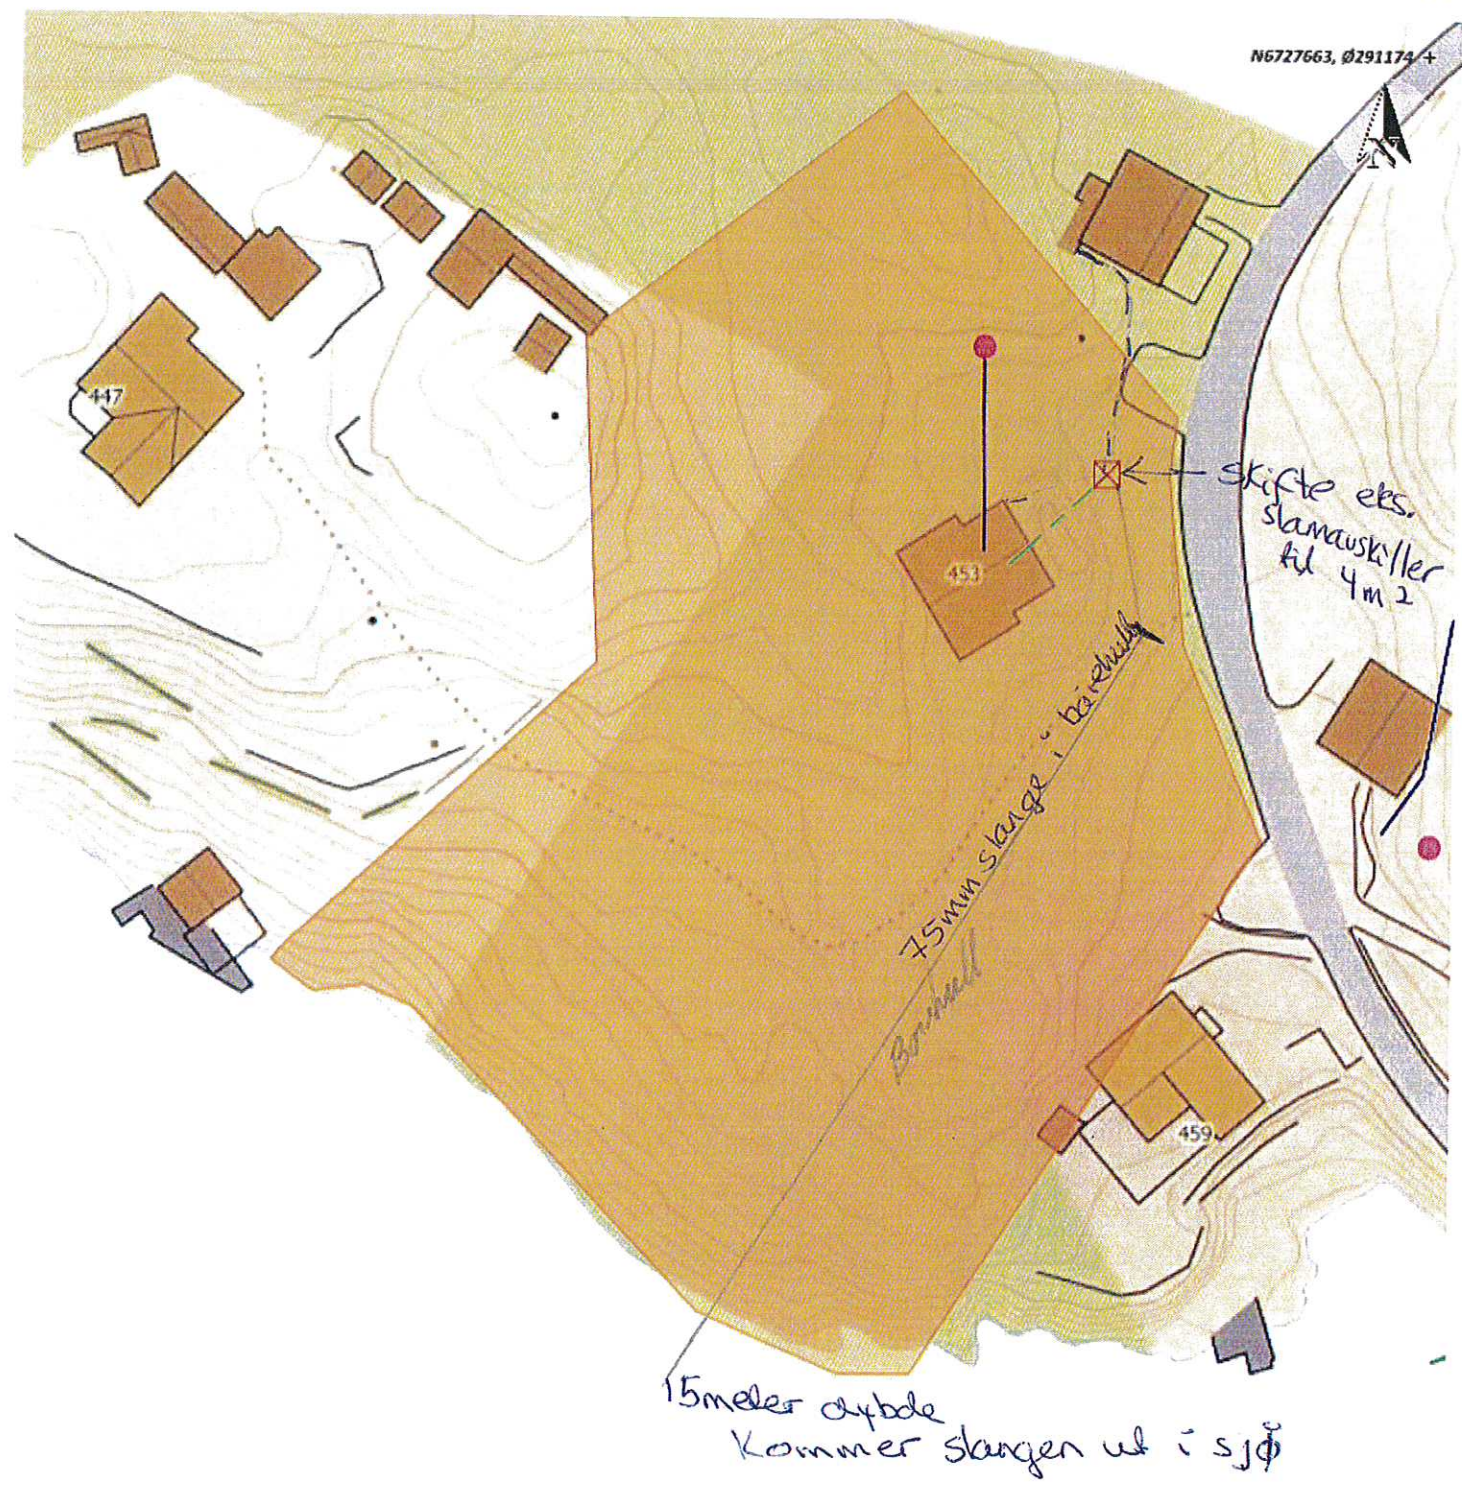

Nappevika

	NHdigi.no	Dato: 25-04-2018
		Målestokk: 1:500  15m