

utv. stoppekraner vann

Nhdigi.no

N6741691, 0285798 +




OV160  
SP160  
VL160

VL  
SP160

SP160  
VL110

OV160  
SP160  
VL160

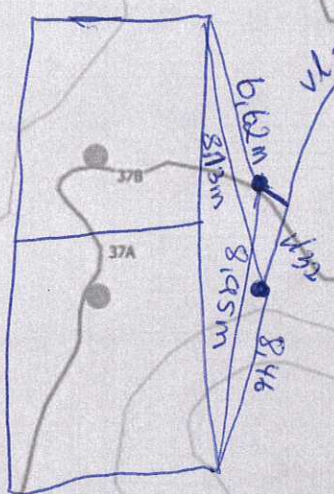

OV150  
SP160  
VL160

VL



**Stendal VVS AS**  
Blombakken 1 - 5911 ALVERSUND  
E-post: sten-vvs@online.no  
Org.nr. 980 626 180

25/9-18

N6741591, 0285728

Data fra Kartverket, Norge Digitalt og Nordhordland digitalt



spillvann 315 mm Ståkekum

N6741691, Ø285798 +

Nhdigi.no




OV160  
SP160  
VL160

VL  
SP160  
VL160

SP160  
VL110

OV160  
SP160  
VL160

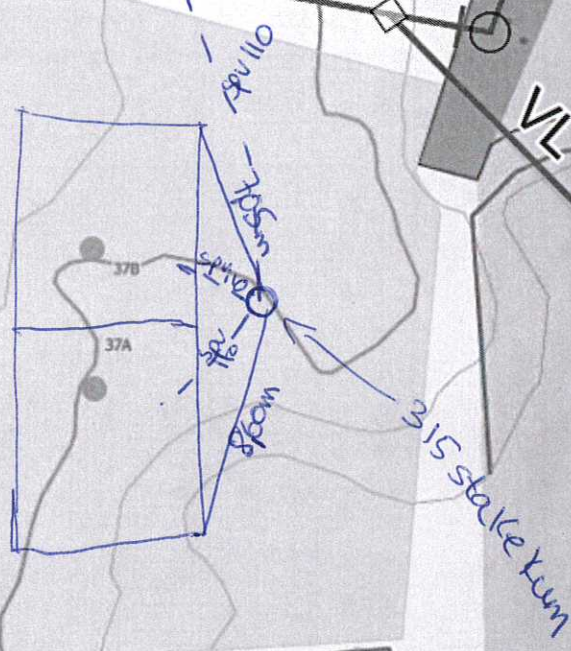

OV150  
SP160  
VL160

VL




**Stendal VVS AS**  
Blombakken 1 - 5911 ALVERSUND  
E-post: sten-vvs@online.no  
Org.nr. 980 626 180

25/9-2018

N6741591, Ø285728

Data fra Kartverket, Norge Digitalt og Nordhordland digitalt



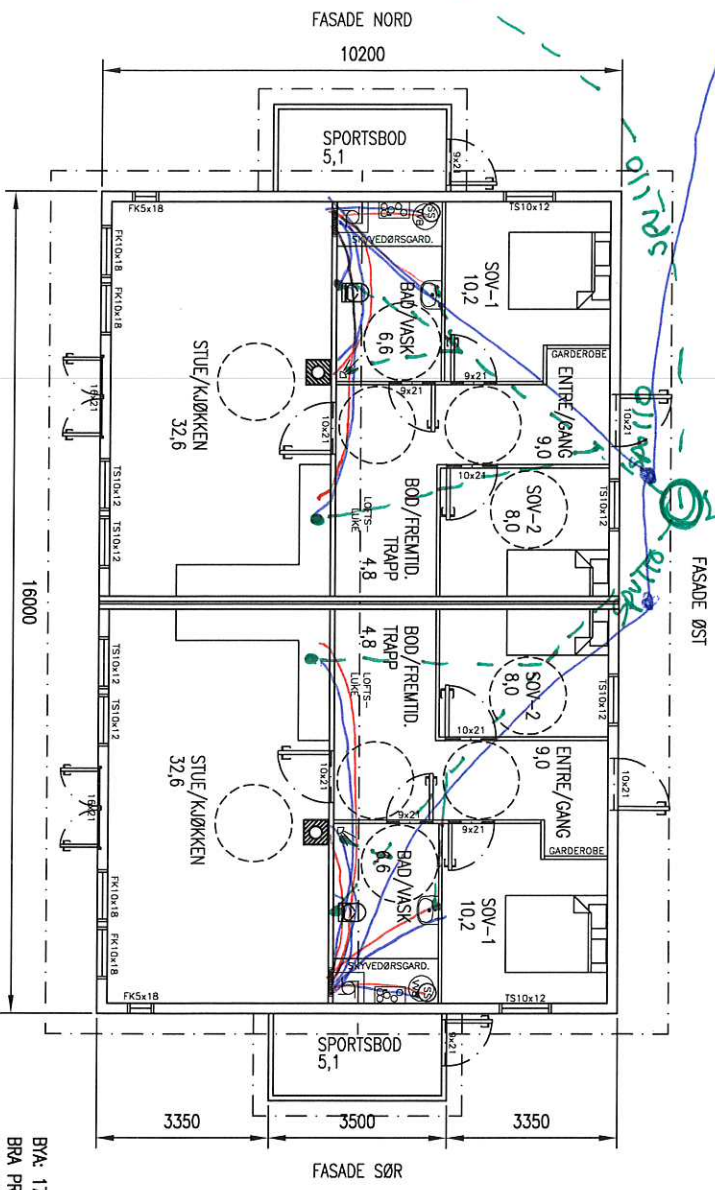

**HOVEDPLAN**

FASADE VEST  
16000

FASADE ØST  
10200

FASADE SØR  
10200

BRA: 175,1 m2 EKS. PARKERING  
BRA PR LEILIGHET: 80,1 m2 EKS. PARKERING  
BRA PR LEILIGHETSLOFT: 49,0 m2  
TOTALT BRA VED FREMTIDIG INNREDET LOFT PR. LEILIGHET: 129,1 m2

REV.	DESCRIPTION	DATE/SIGN
	<p><b>NOTE</b></p> <ul style="list-style-type: none"> <li>* PART OF DRAWING MAY NOT BE SHOWN IN SCALE</li> <li>* DO NOT TAKE MEASURES ON DRAWING</li> <li>* ONLY RELAY ON GIVE DIMENSIONS</li> </ul>	<p>ACCORDING TO INTERNATIONAL LAWS, THIS DRAWING IS THE PROPERTY OF ARKOCONSULT AS. THE DRAWING CAN NOT BE USED, MADE PUBLIC OR HANDED OVER TO A THIRD PART WITHOUT OUR WRITTEN CONSENT. ANY INFRINGEMENT WILL LEAD TO LEGAL PROCEEDINGS.</p>
	<p>BOLIG &amp; EIENDOM AS RISASJØEN, 123/145</p>	<p>REVISION/DATE:</p>
	<p>2 MANNIS BOLIG PLAN</p>	<p>PROJECT NO.: 2014103</p>
	<p>DRAWING NO.: 20714103A01</p>	<p>SCALE: 1:100 FORMAT: A3</p>
	<p>ARKOCONSULT AS, Postboks 103, 5291 Valesfjell Tel.: 56390003 – Fax.: 56191130 – Mob.: 93241511 Mail: post@arkoconsult.no – Org.nr.: 997089782 MVA</p>	<p>DRAWN: LAH CHECKED: LAH DATE: 15.04.2014</p>

25/9-2018

Org.nr. 580 626 780

ARKOCONSULT