


HOR. KURV.	
BREDEDEUTV.	
VEIBANE H.	-0.24 52.75
	-7.87 53.27
	-8.99 53.79
	-10.26 54.32
	-11.01 54.84
	-11.40 55.36
	-11.27 55.89
	-10.62 56.41
	-11.10 56.93
	-10.92 57.46
	-10.74 57.98
	-10.50 58.50
	-8.80 59.02
	-5.93 59.55
	-3.60 60.07
	-2.20 60.59
	-0.51 60.91
SKU./FYLL.	

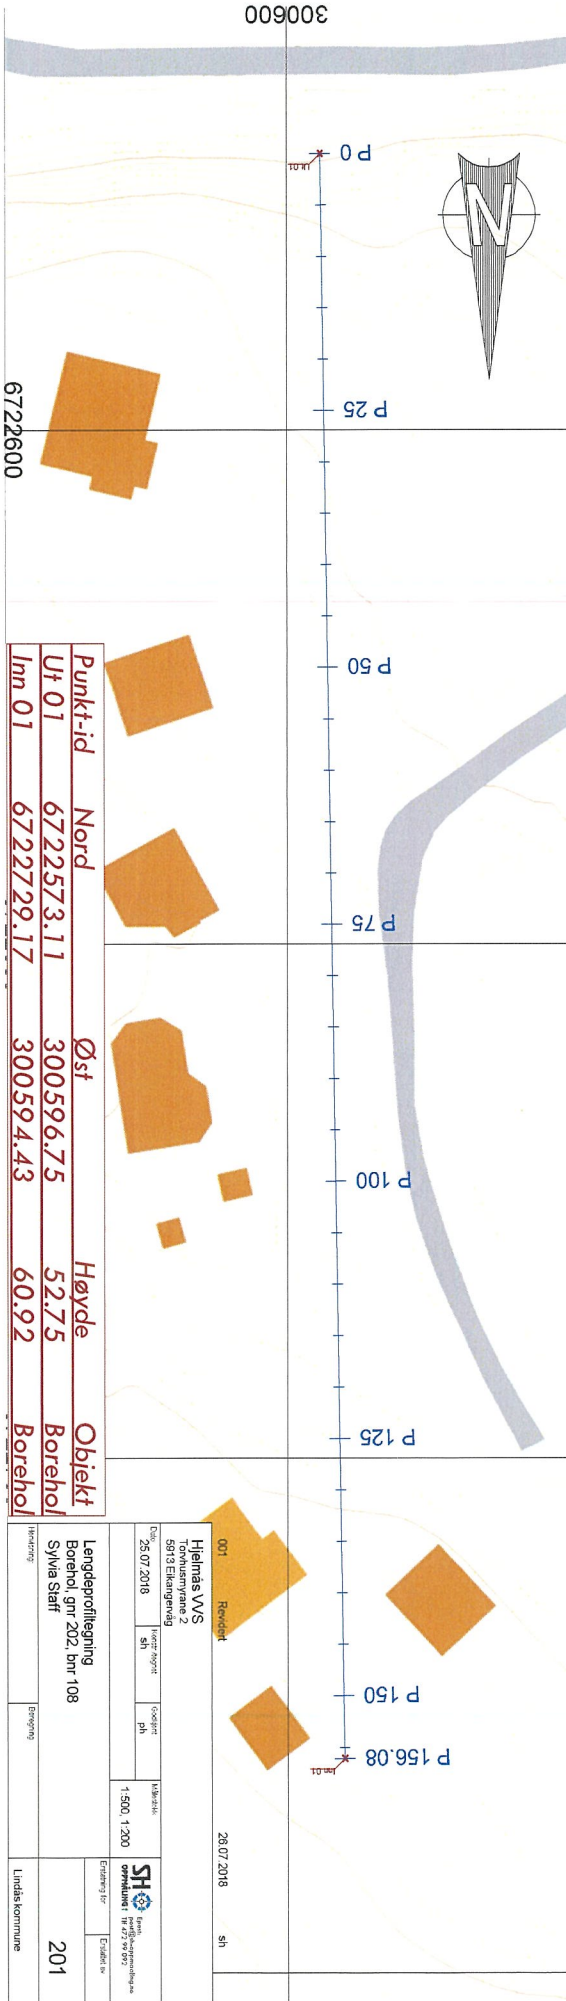

Punkt-id	Nord	Øst	Høyde	Objekt
Ut 01	6722573.11	300596.75	52.75	Borehol
Imn 01	6722729.17	300594.43	60.92	Borehol

001 Borehol

26.07.2018 sh

26.07.2018

Lengdeprofillegning  
Borehol, gnr 202, bnr 108  
Sylvia Steff

SH  

1:500, 1:200

201

Lindås kommune