


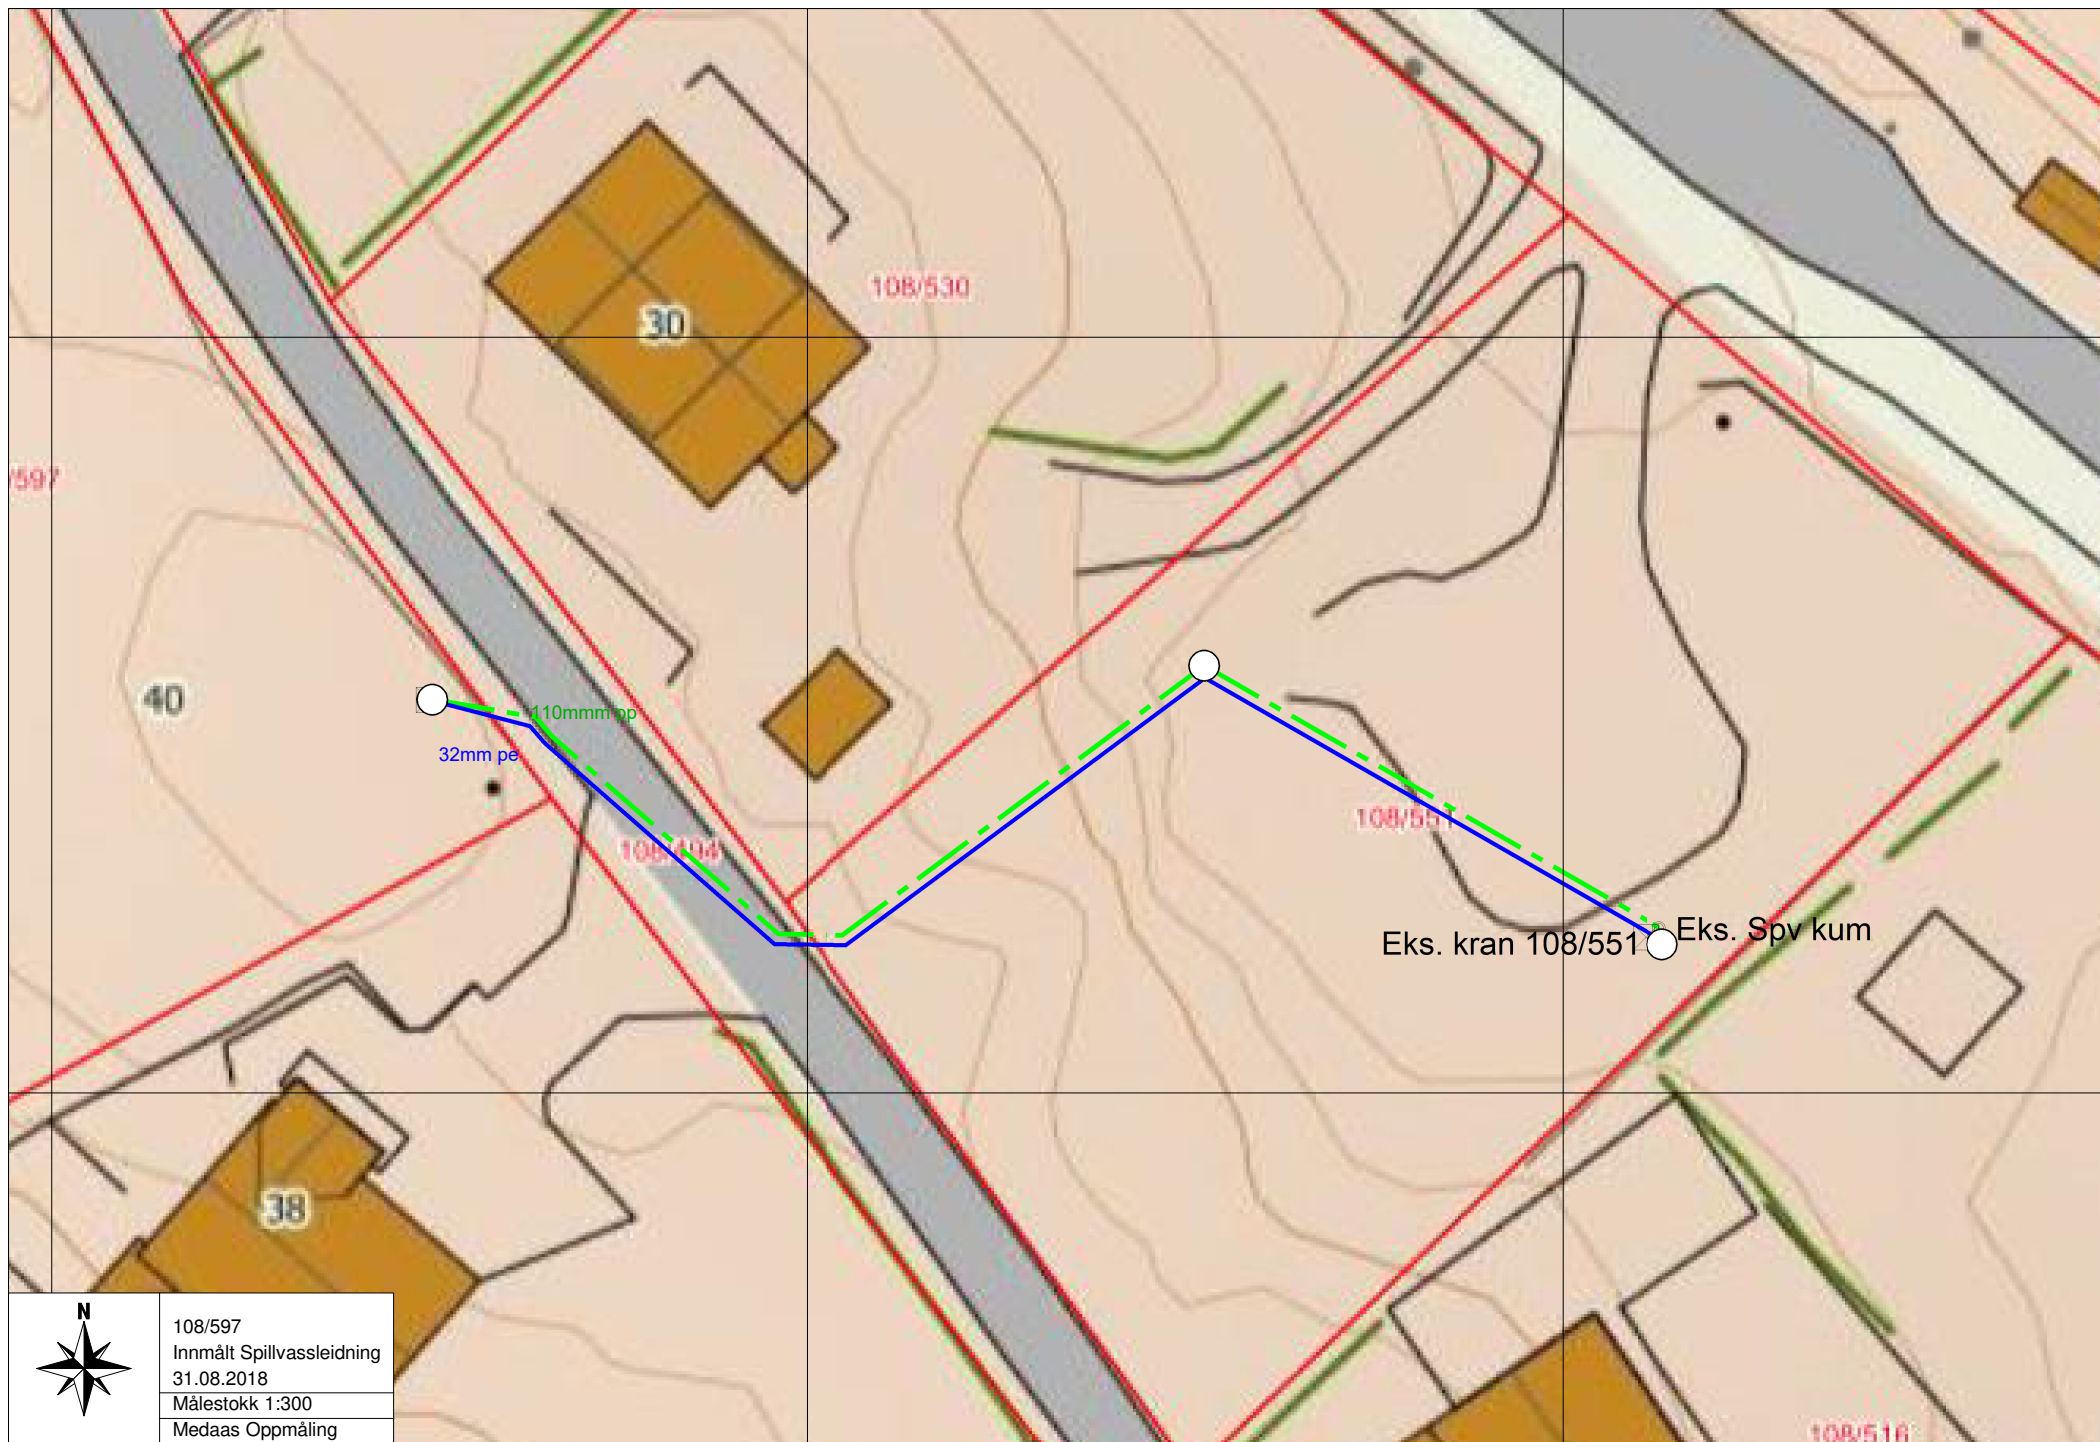

108/597
Innmålt Spillvassleidning
31.08.2018
Målestokk 1:300
Medaas Oppmåling