




Lindås, gnr 108 bnr 68,
Data på innmålt grunnmur

11.12.2017

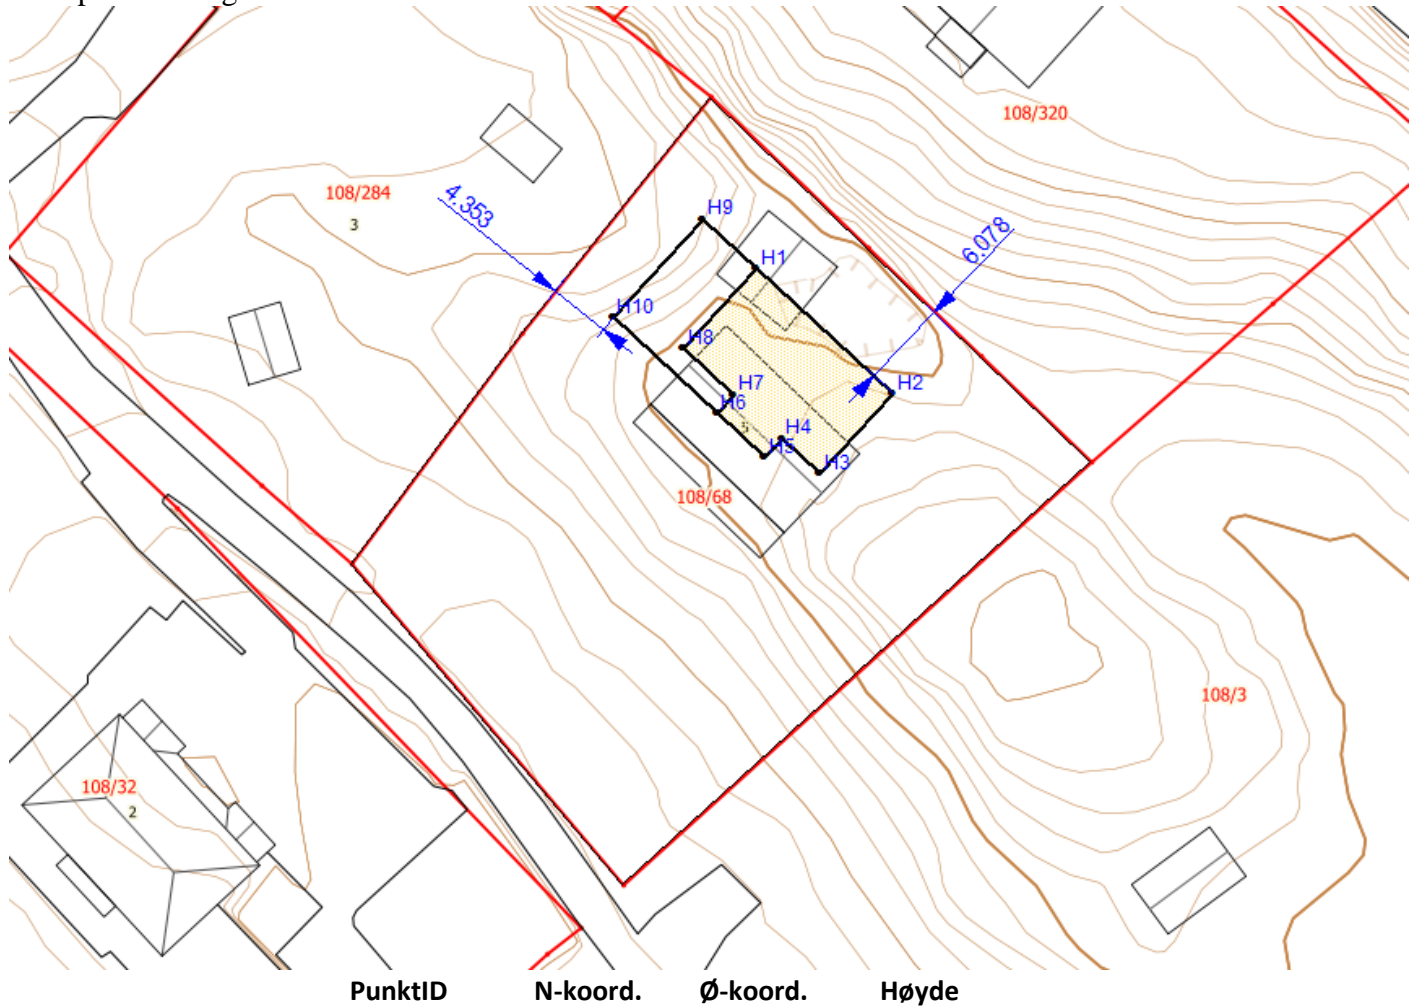

H1	6738979,51	290911,72	25,15
H2	6738970,72	290921,29	25,14
H3	6738965,12	290916,15	25,14
H4	6738967,56	290913,50	
H5	6738966,23	290912,28	
H6	6738969,34	290908,90	
H7	6738970,67	290910,11	
H8	6738973,92	290906,58	
H9	6738983,00	290907,93	
H10	6738976,07	290901,57	