


EKS. SNITT A-A

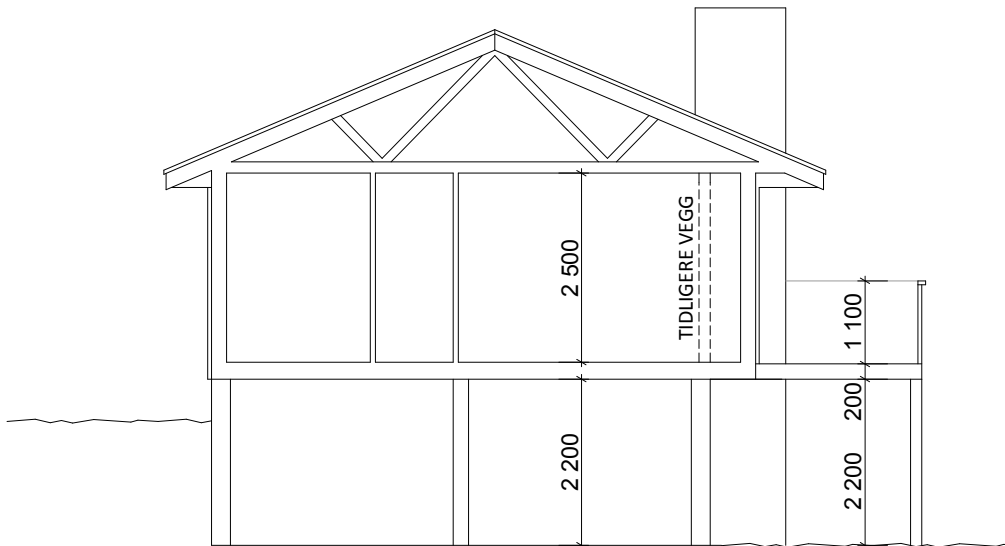

NYTT SNITT A-A

		PROSJEKT:	SEIMSTRANDA 564 GNR. / BNR. 177 / 29 - LINDÅS KOMMUNE		TEGNET AV:	Jens Laland	TILTAKSHAVER/EIER:	STIAN HAUKÅS	
		TEGNING:	SNITT A-A		KONTROLL:	Jens Laland	Seimstranda 564 5912 Seim		
				FERDIGGRAD:	MÅLESTOKK:	1	tlf: 952 93 878		
		CASECO	TLF: 51 11 06 32	PROSJEKTNR:	SAKSBEHANDLER:	153.14	e-post: stian.haukas@bydrift.no		
		Jens Laland	jens@caseco.no	TEGNINGSNR:	DATO:	E2	17.09.14		