


skisse garas. Kramme gard 1.50


12.02.19



18.02.19 - påtegnet stall 6x6

14.03.19 - endret stall 5x6


- endret stall høyde ref snitt B-B

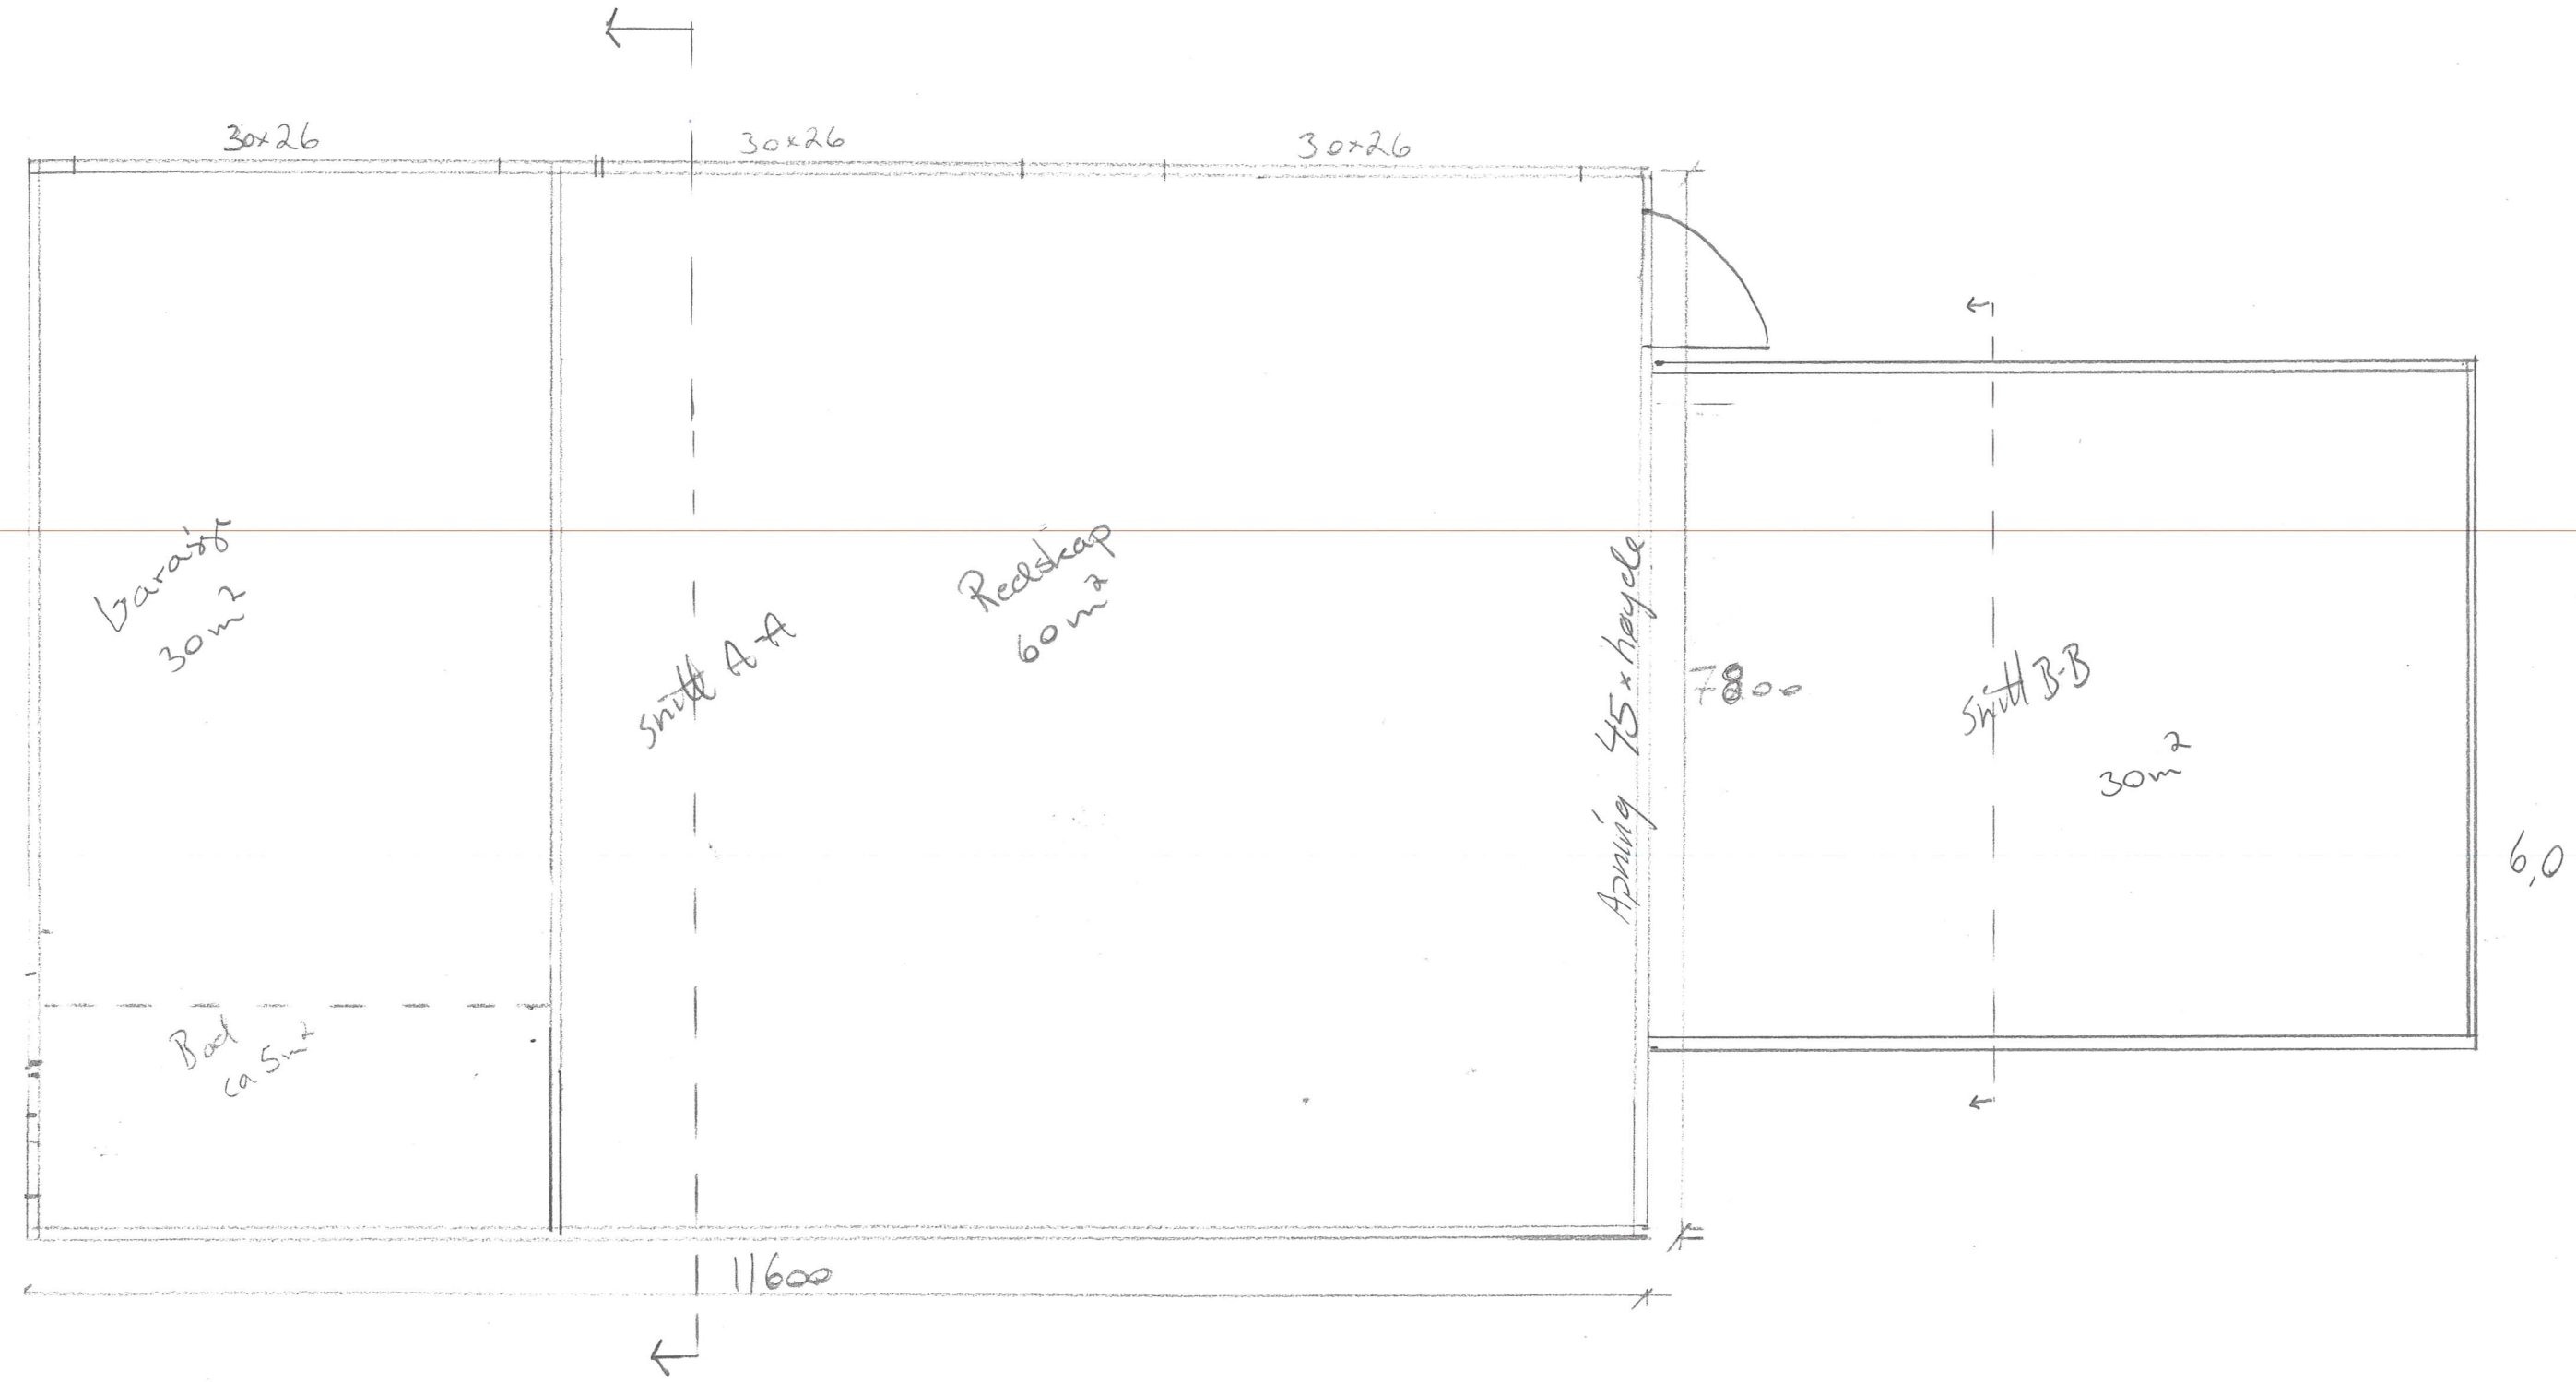

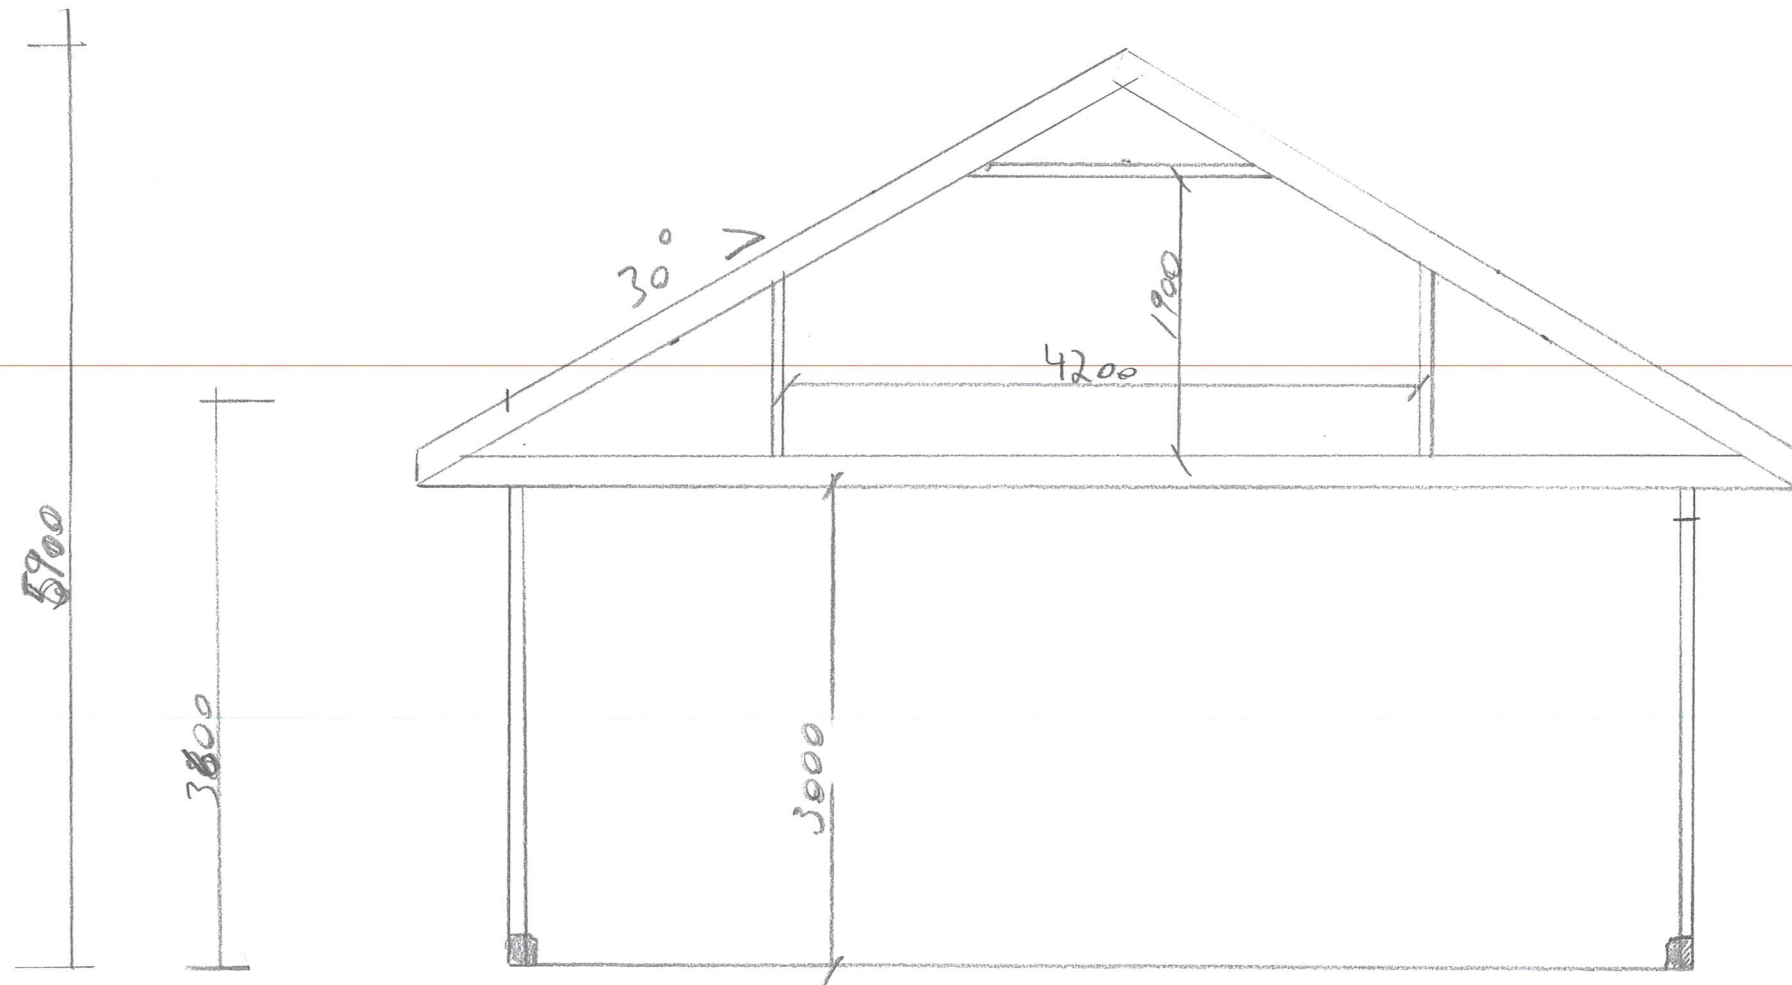


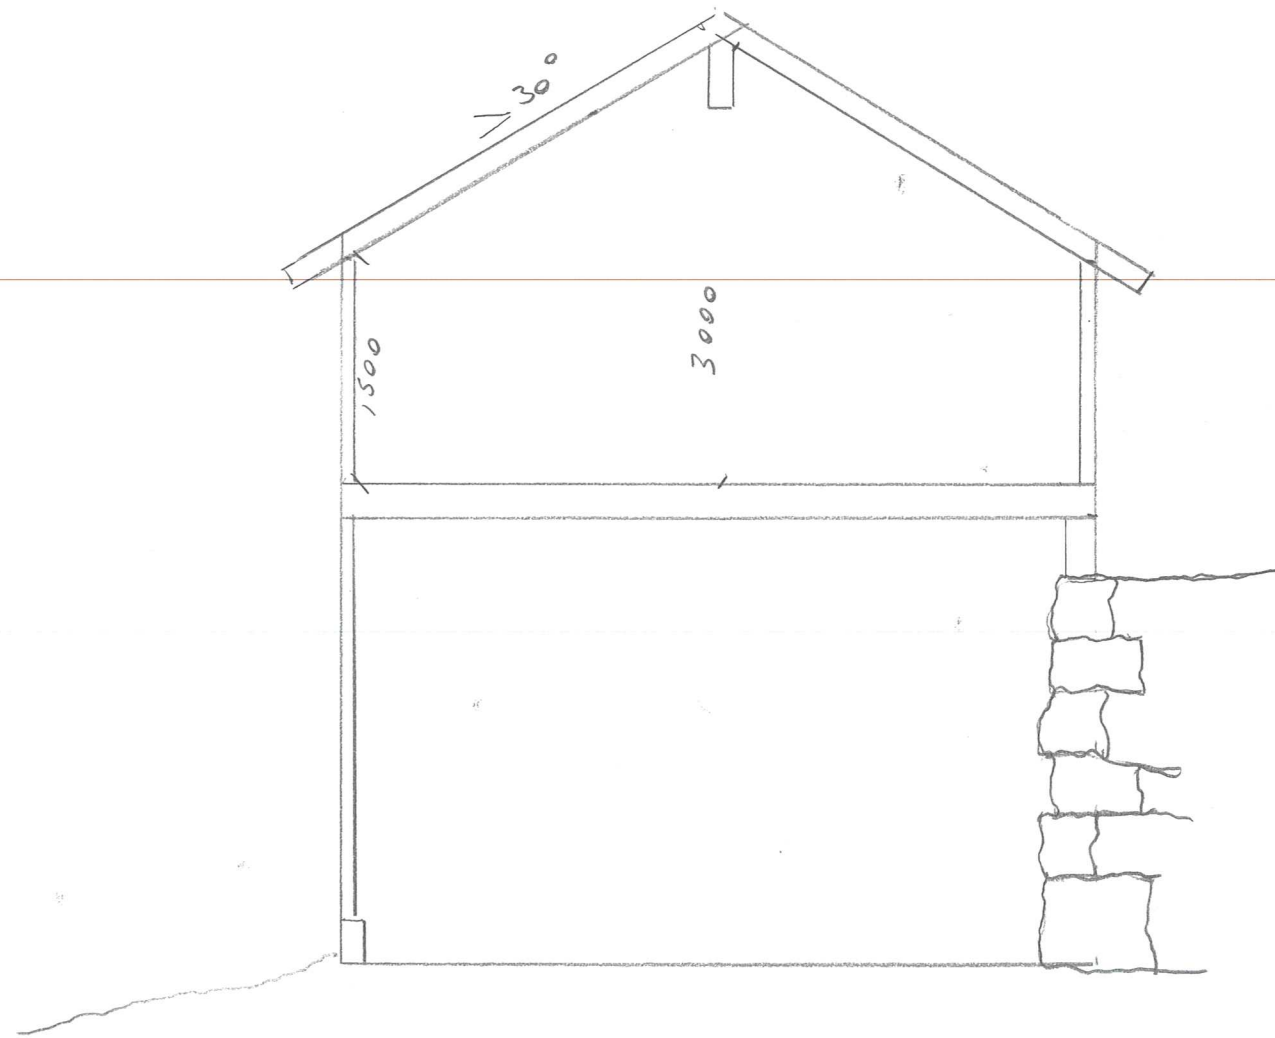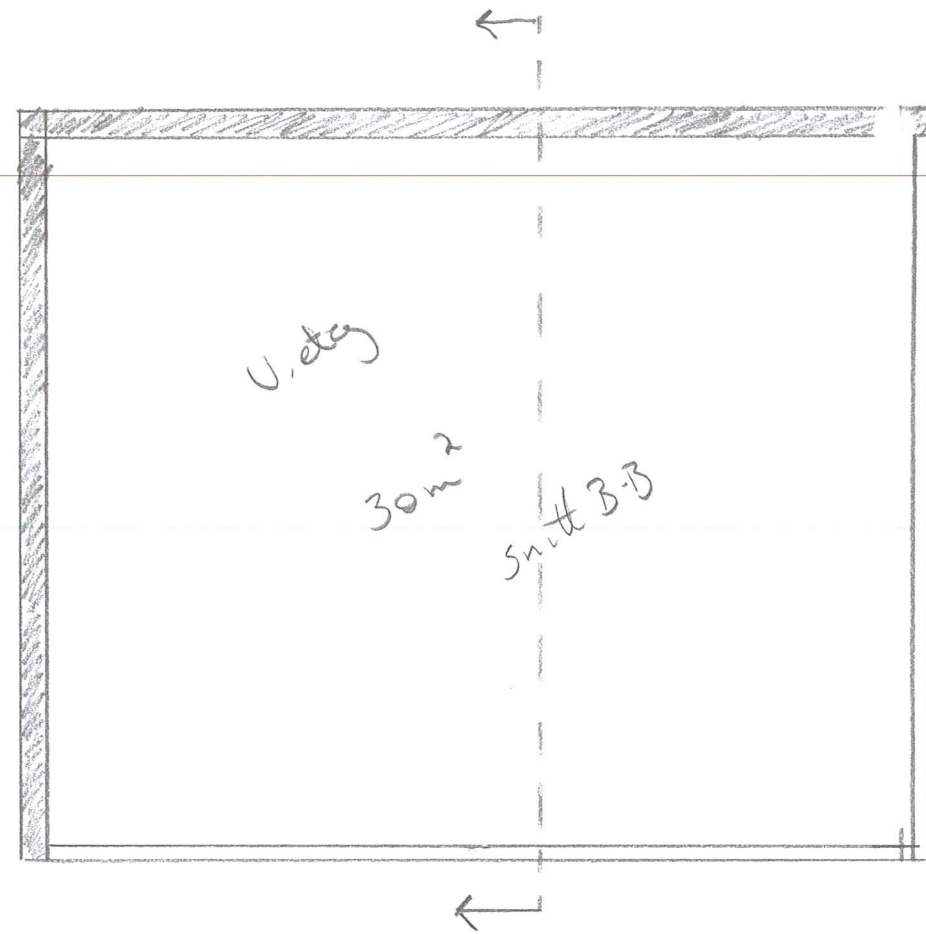

Reel-skapshus/stall Kvanne gård 18.02.19 R.K 1:50
FCU 14.03.19 størrelse stall

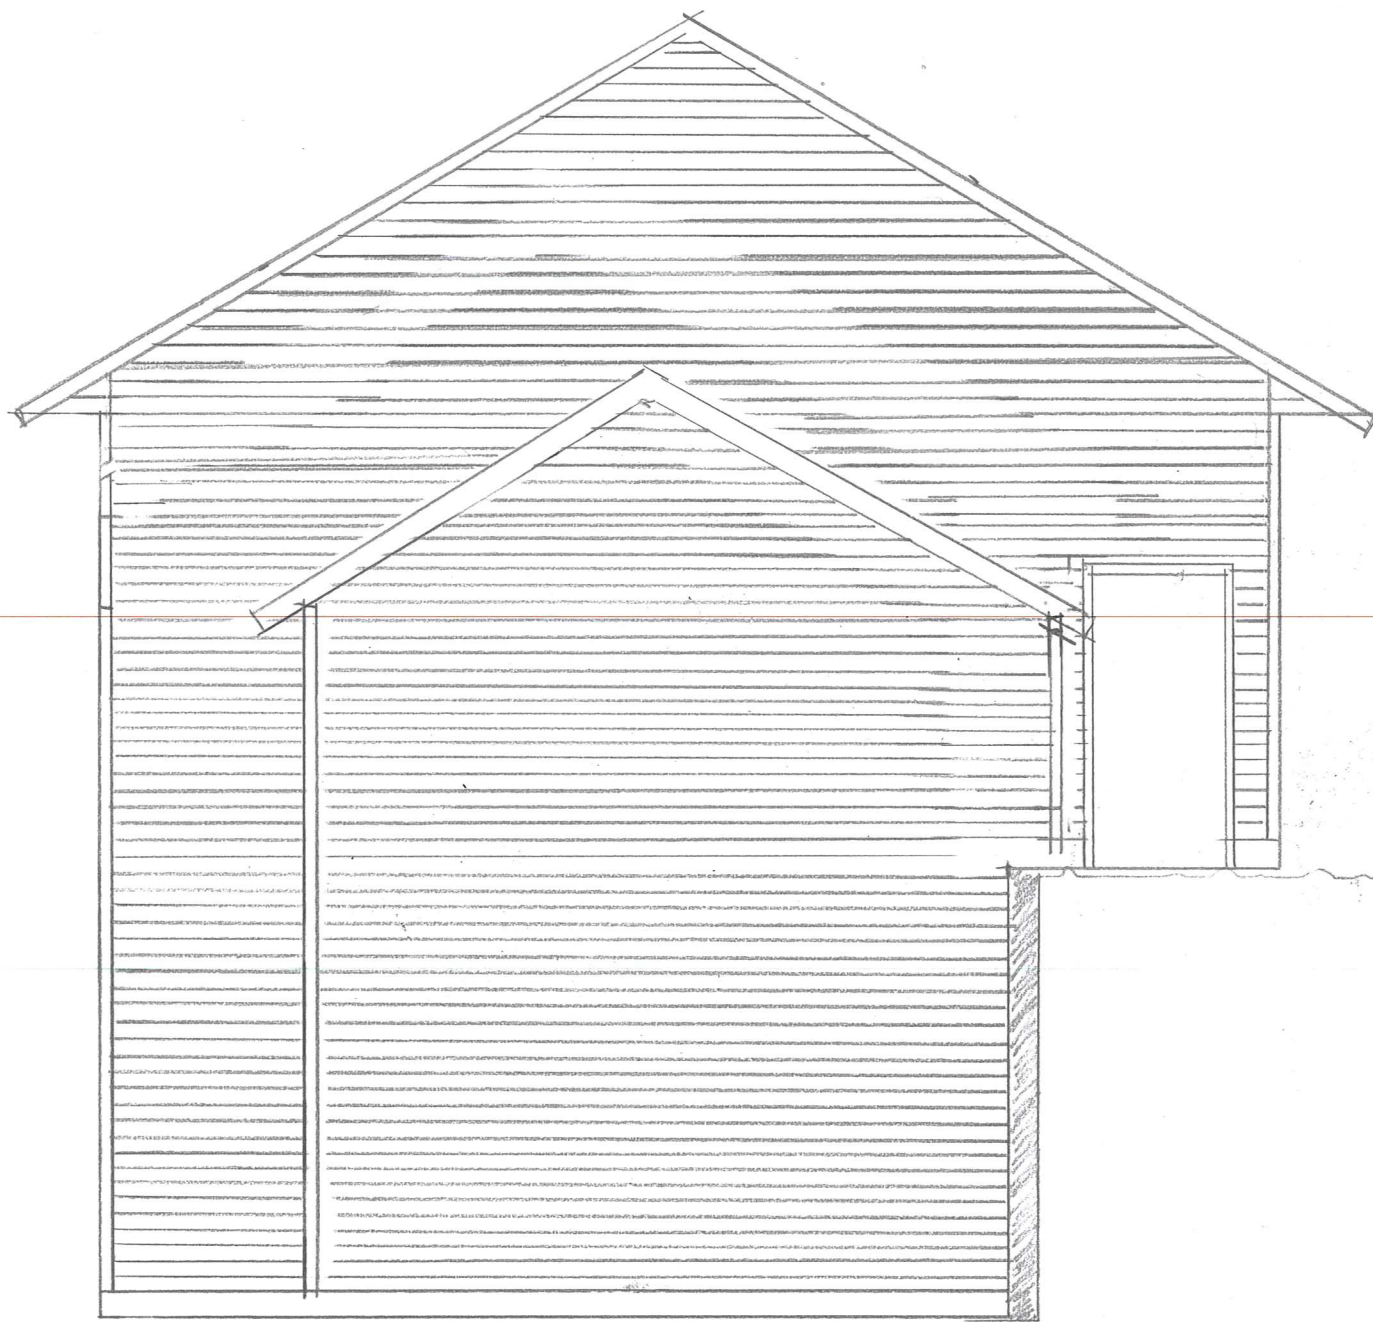


Fasade øst

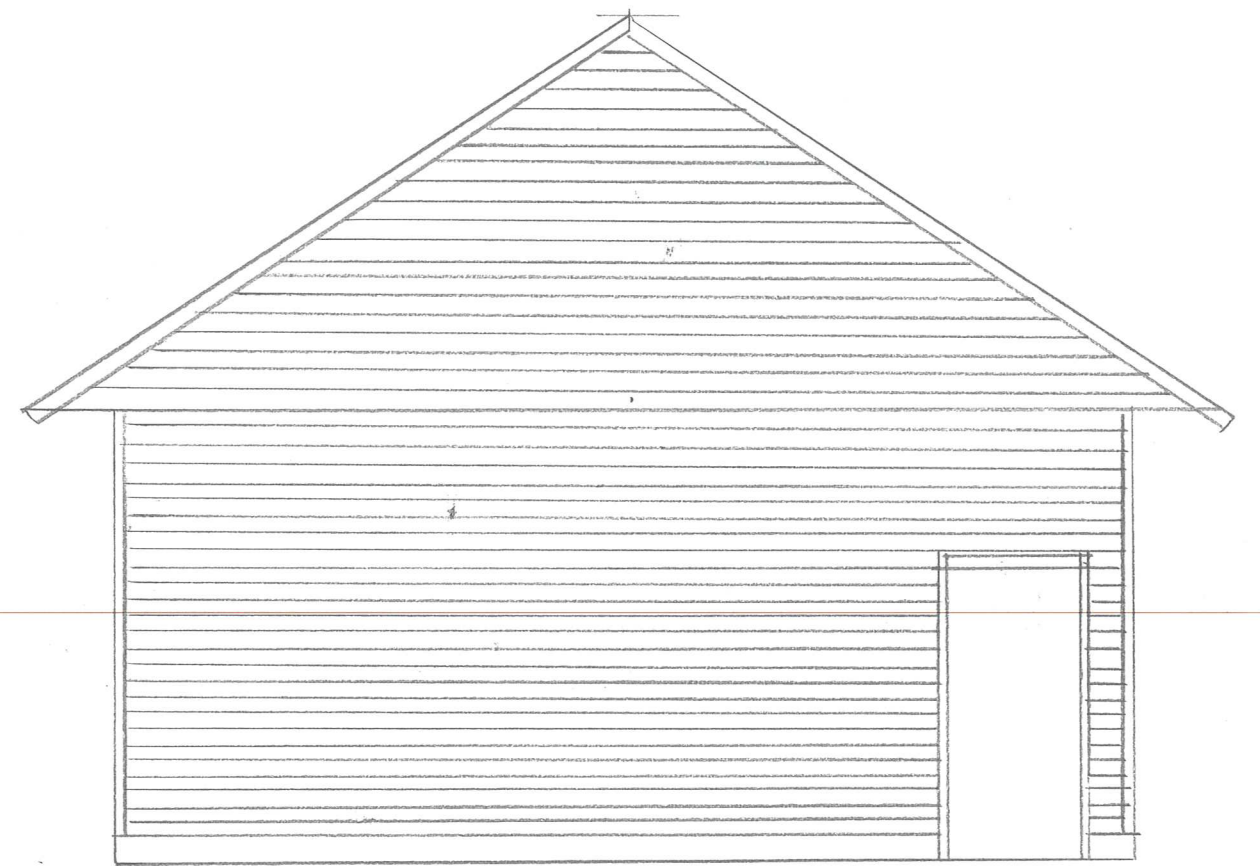

Fasade Vest

Reedskaphus / Stall Kvamme gård 18.02.19 R.K 1:50
- Rev 14.3.19 størrelse stall

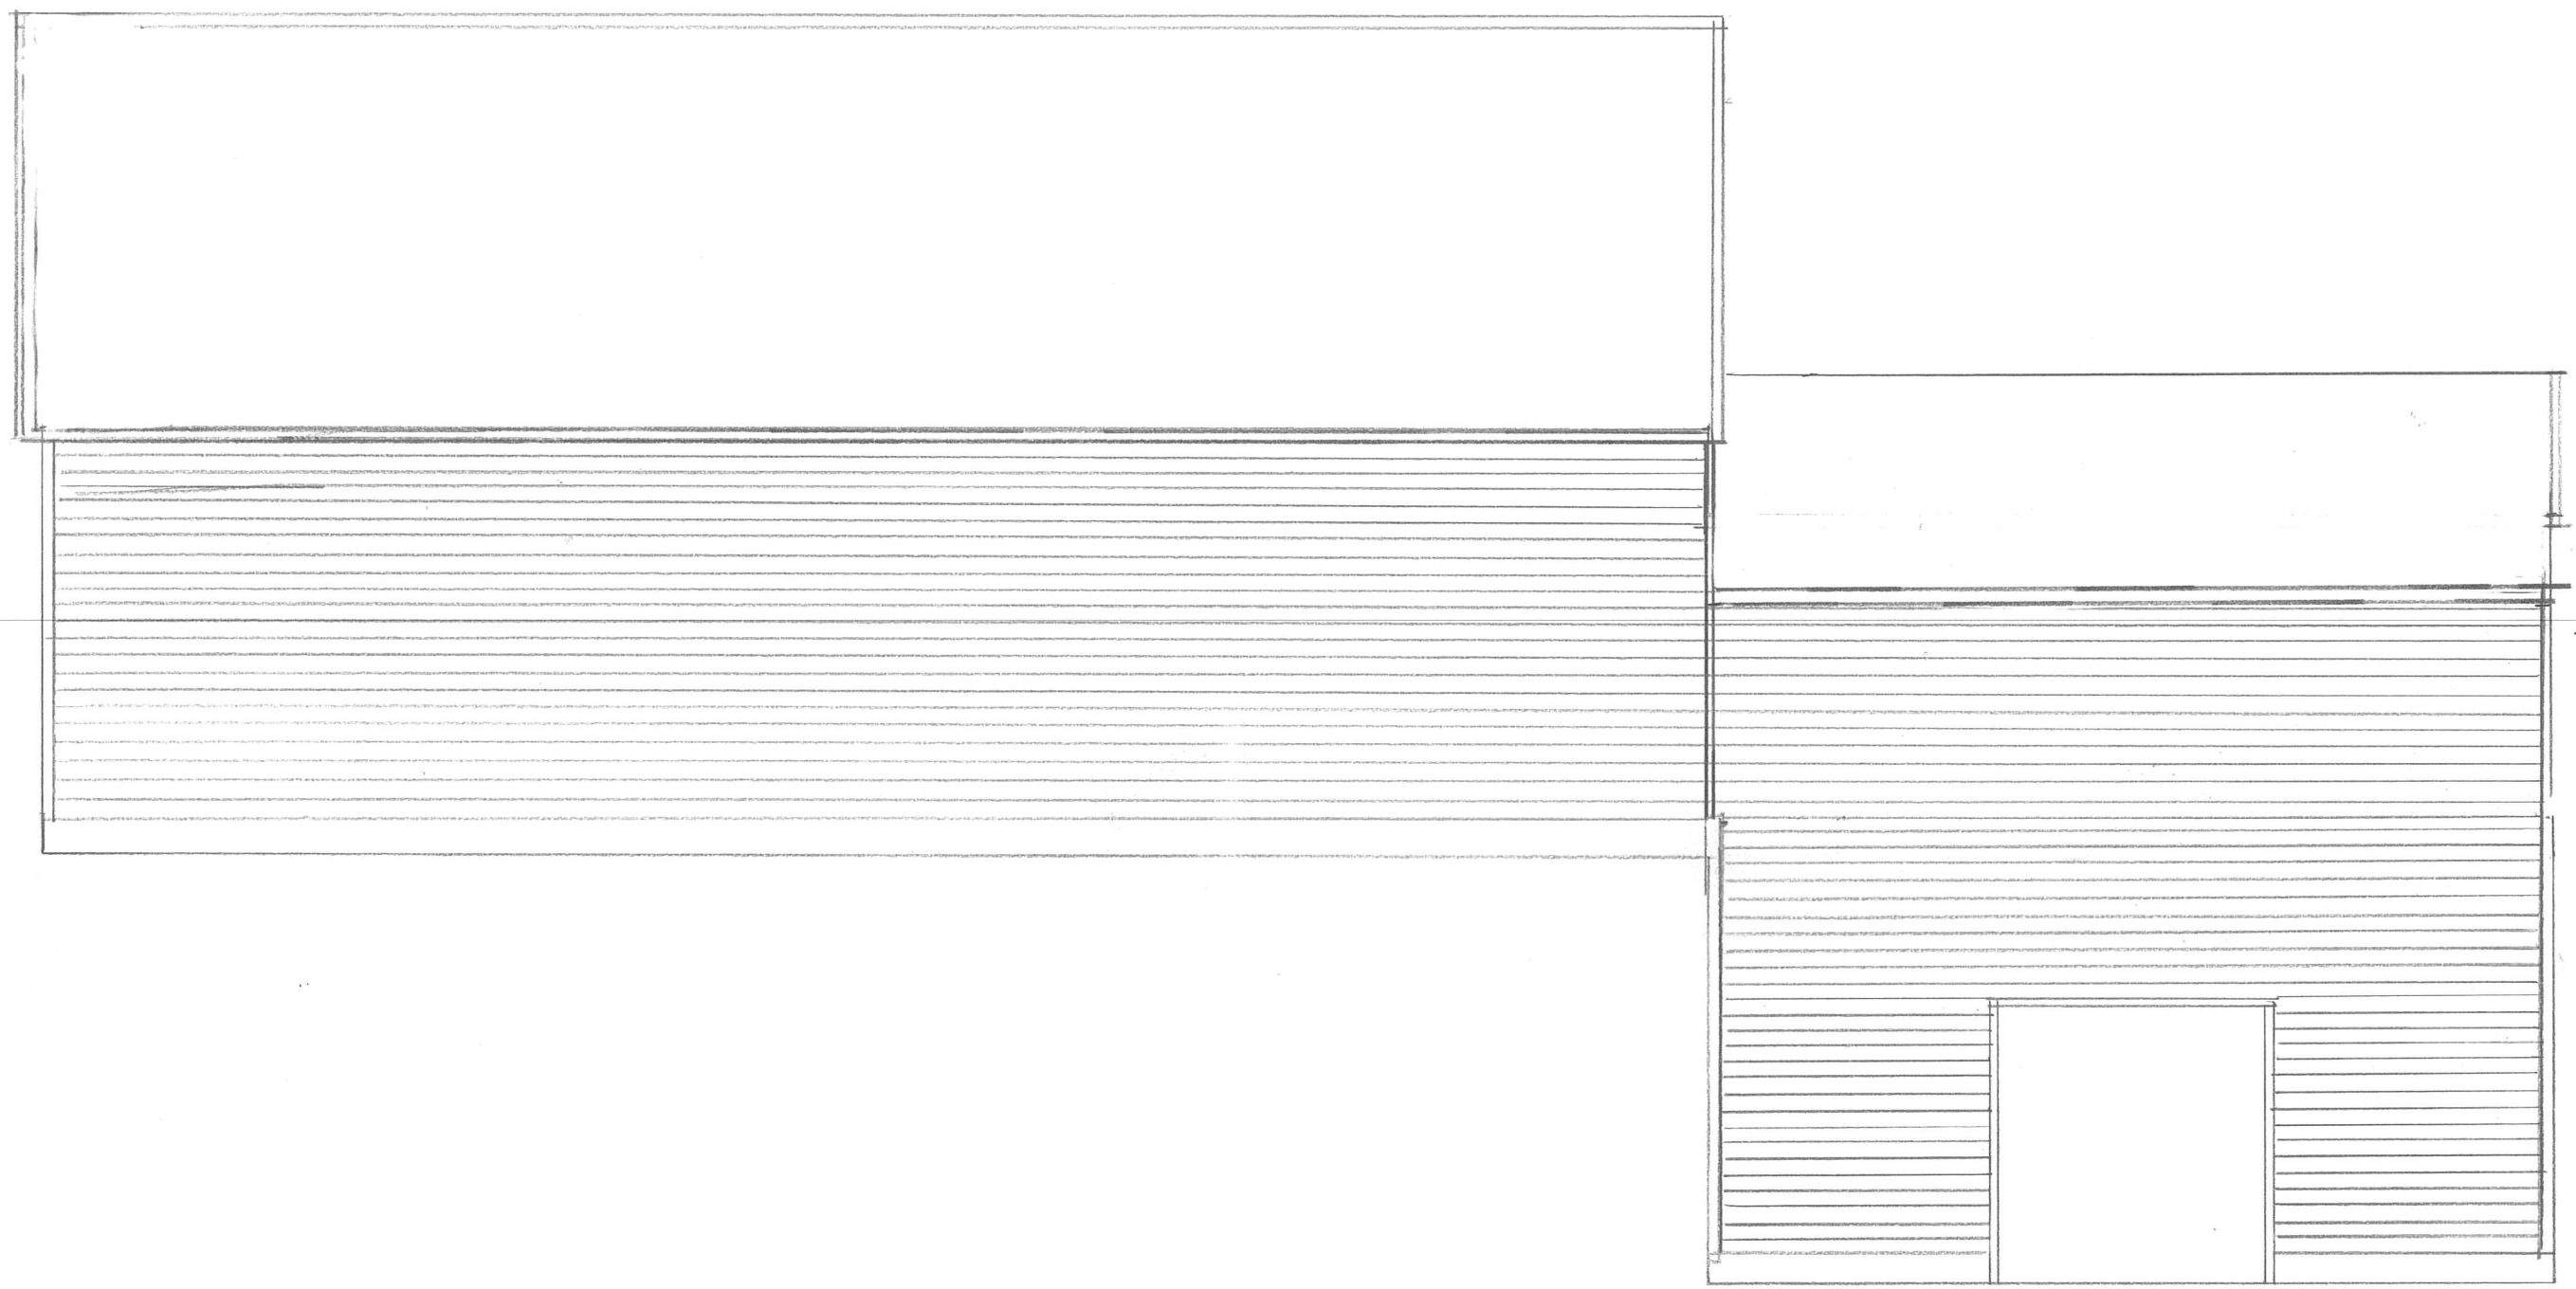

Fasade sør

Redskapshus/stall Kramme gard 18.02.19 R. 1:50
Rev 14.03.19 endret str stall



Fasade Nord