


HOVEDPLAN- OPPMALING

9300 mm

4300 mm

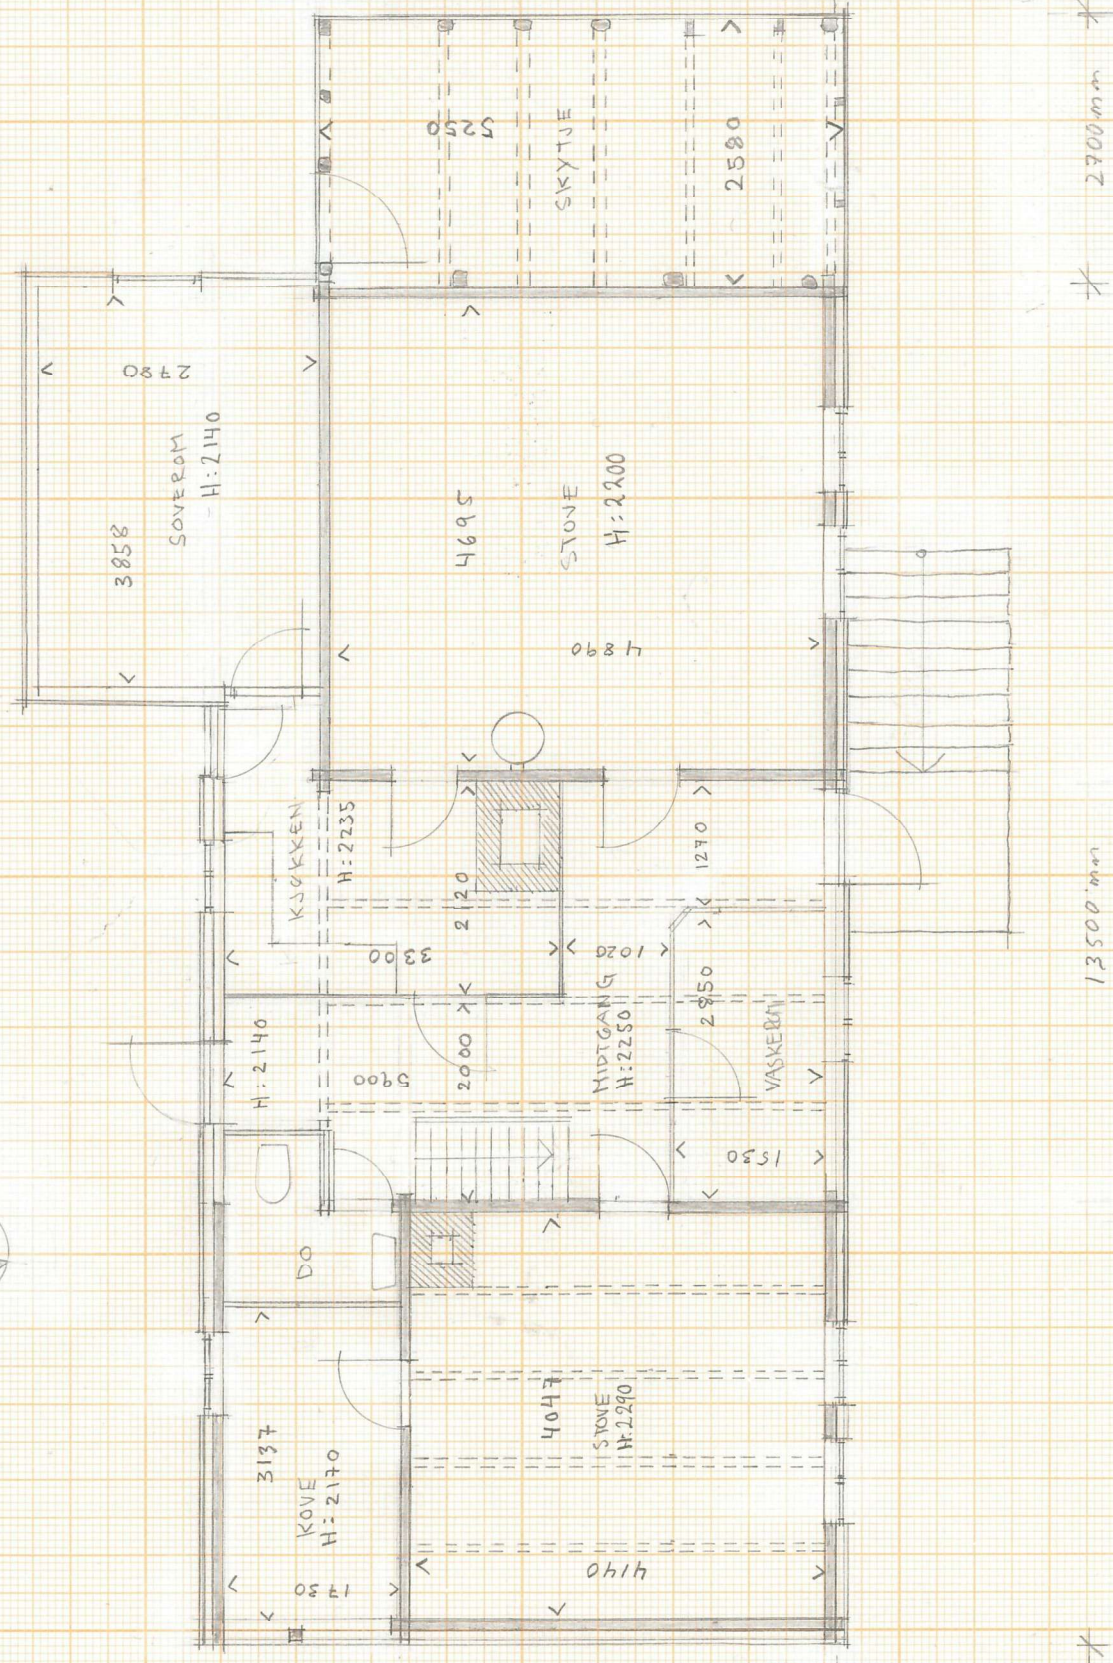

5300 mm

2900 mm

2700 mm

13500 mm