


$$\underline{123/102}$$


- = 110 mm Stakepunkt
- = 32 mm stoppekran

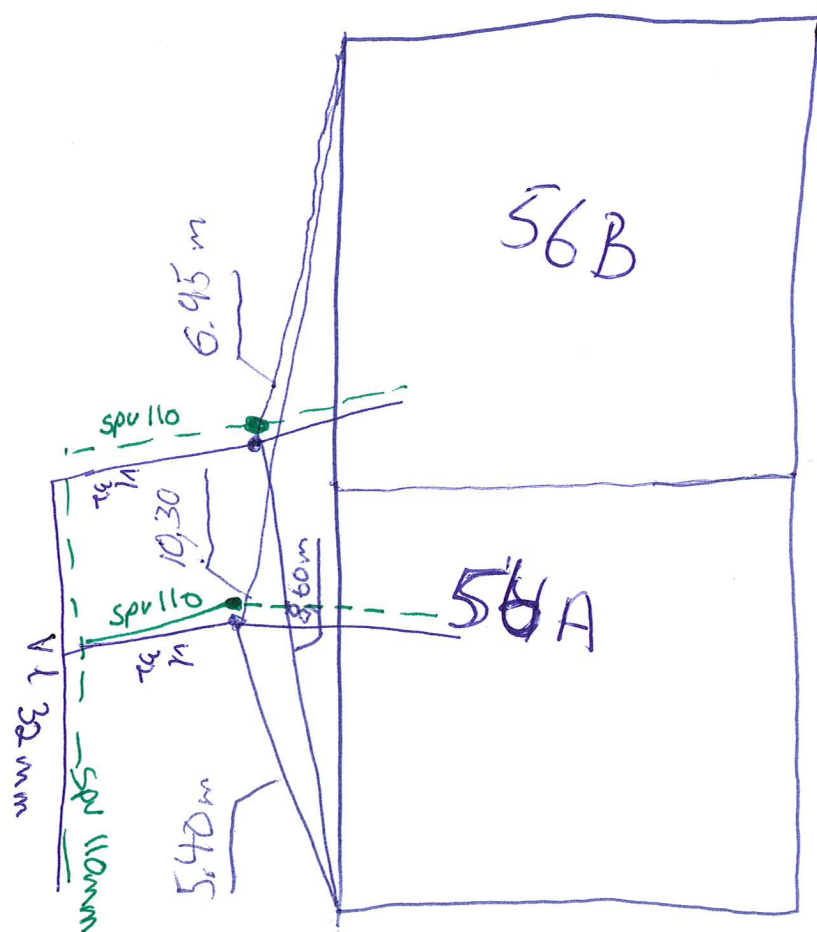

Situasjonskart -

123/102

Nh^{digi}.no

Dato: 16-07-2019

Målestokk: 1:500

15m