



PLAN 1.ETG.

Til takshaver:			
NINA ASKELAND HAY			
Tegning:			
PLANTEGNING 1.ETG.			
Dato:	Konstr./Tegnet:	MAlestokk:	Tegn nr.:
20.05.2015	E.T.	1:100	101
Rev:	Gnr./Bnr.:	Kommune:	
11.06.2019	214/126	Lindås	
K&L&S Bygg AS			
Torvhusmyrane 2, 5913 Eikangervdg			
Tlf 56353370, Faks 56353481			

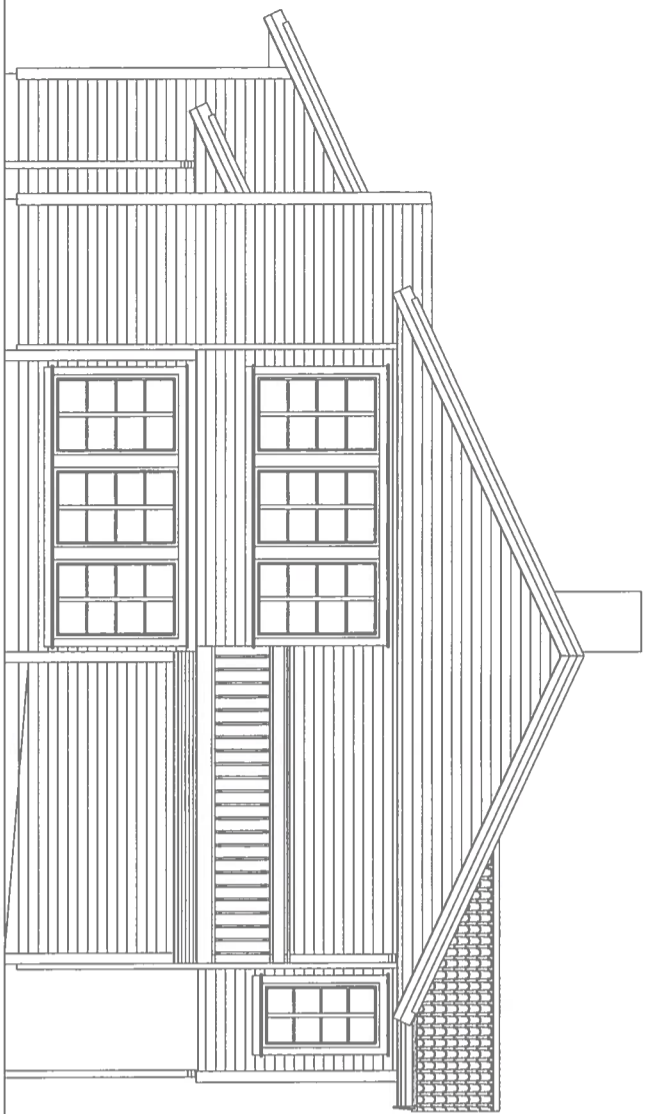


Tilbygg


FASADE MOT SØR-VEST

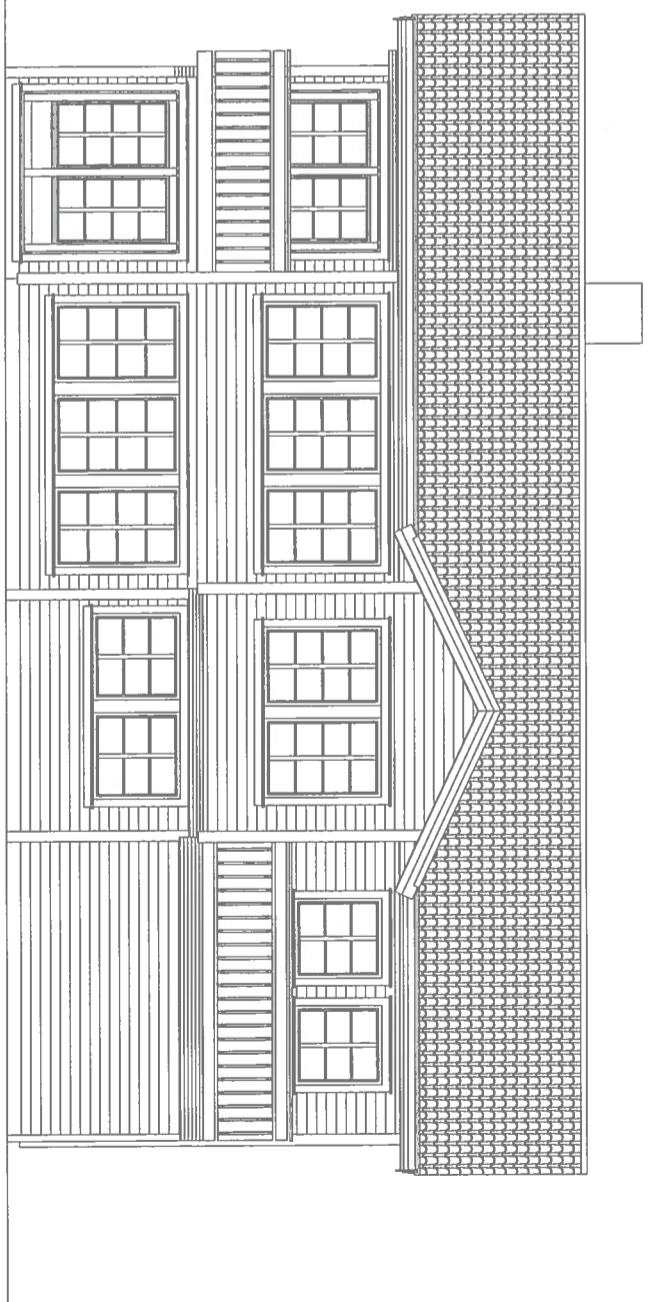

FASADE MOT SØR-AUST

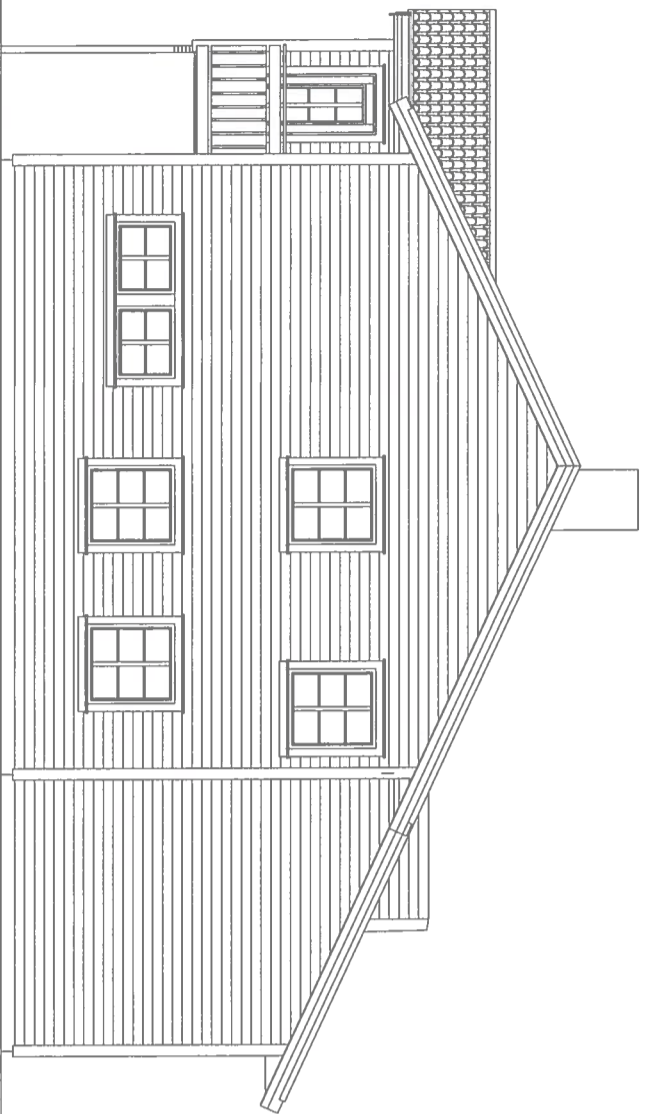

FASADE MOT NØRD-AUST

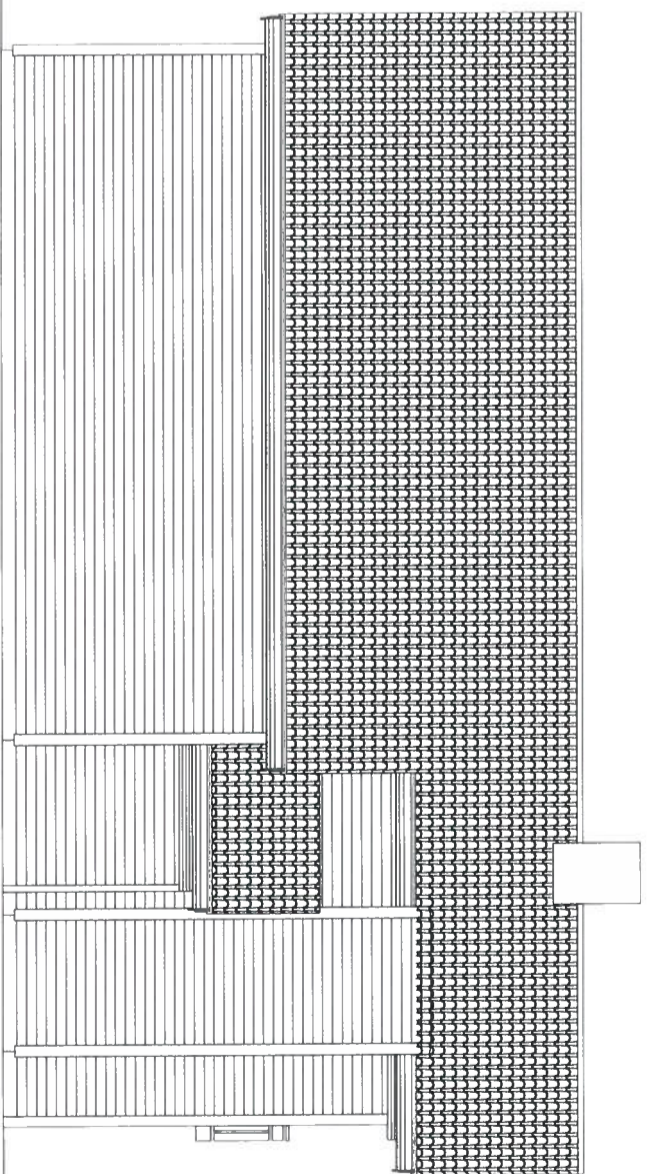

Tilbygg  
FASADE MOT NØRD-VEST

Til takshaver:

NINA ASKELAND HAY




Tegning:

FASADER

Dato:	2005.2015	Konstr./Tegnere:	E.T	Målestokk:	1:100	Tegn nr:	103
Rev:	11.106.2019	Gnr./Bnr.:	214/126	Kommune:	Lindås		

Kålds Bygg AS

Torvhusmyrane 2 5913 Elkangervdg  
Tlf 56353370, Faks 56353481

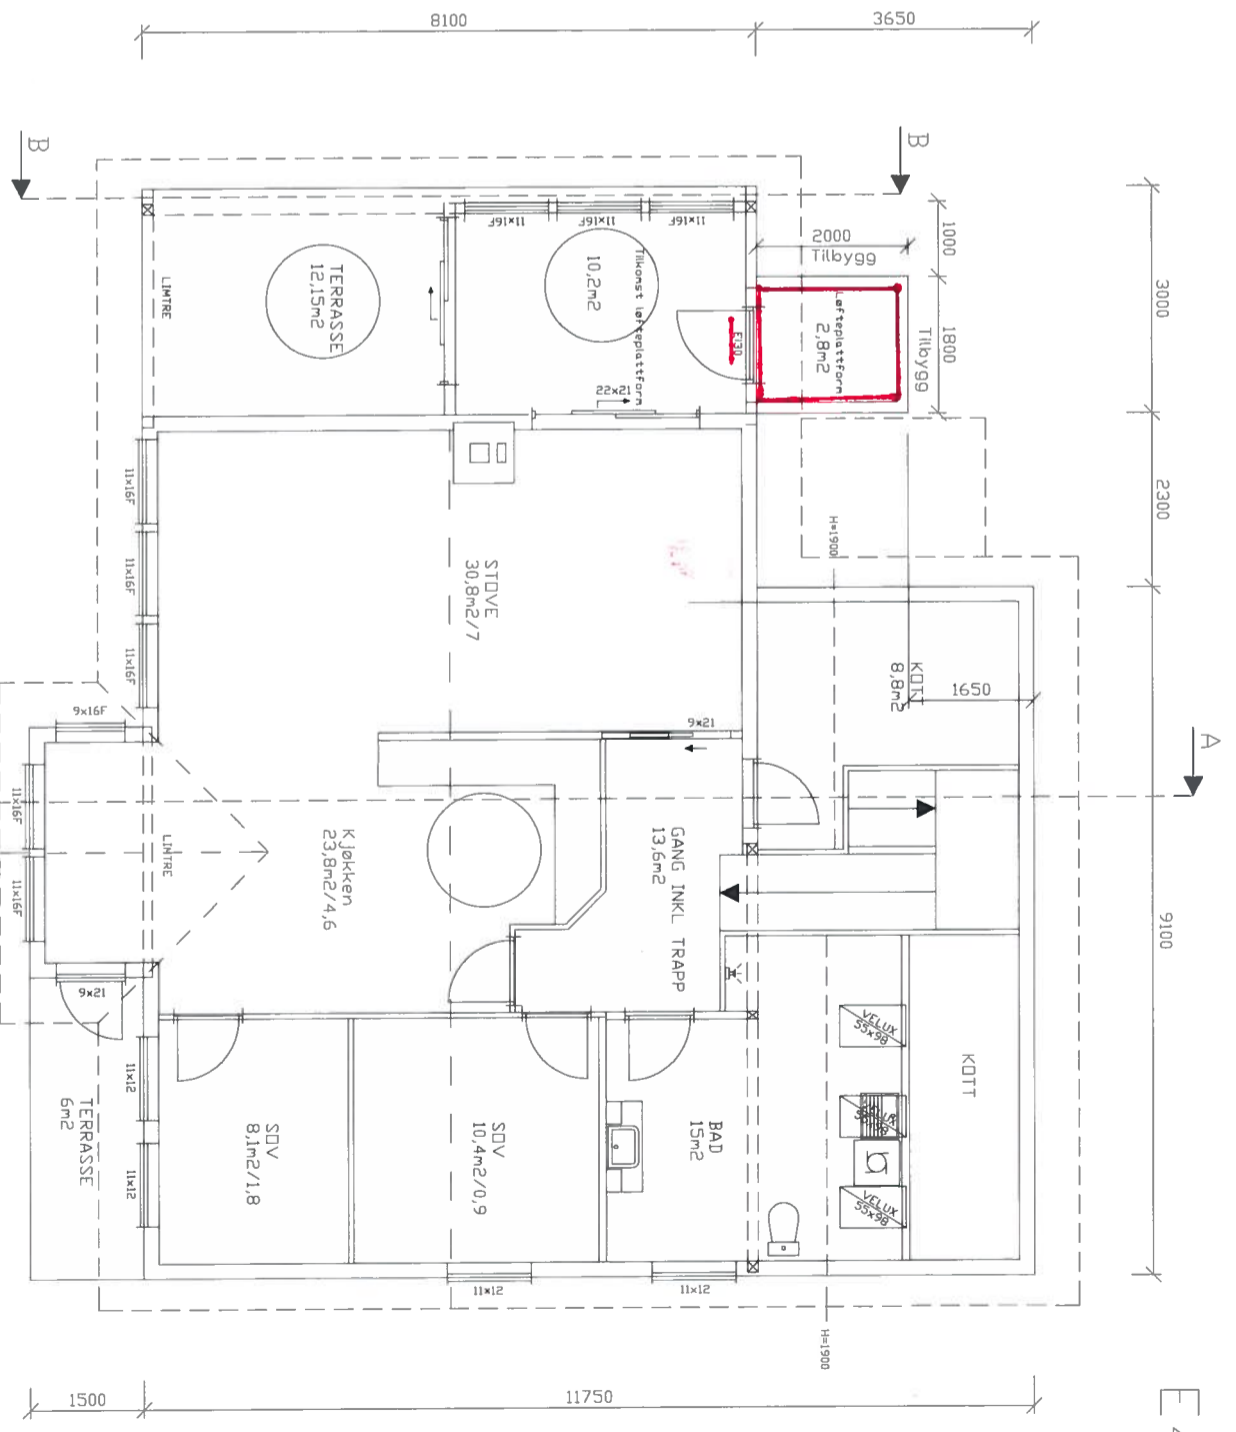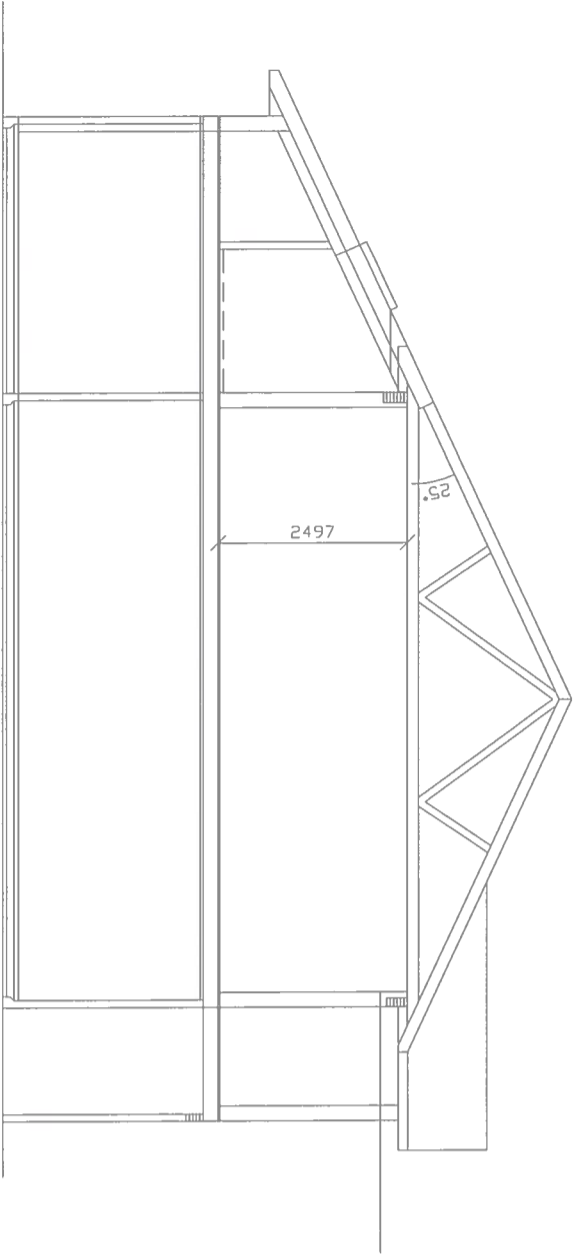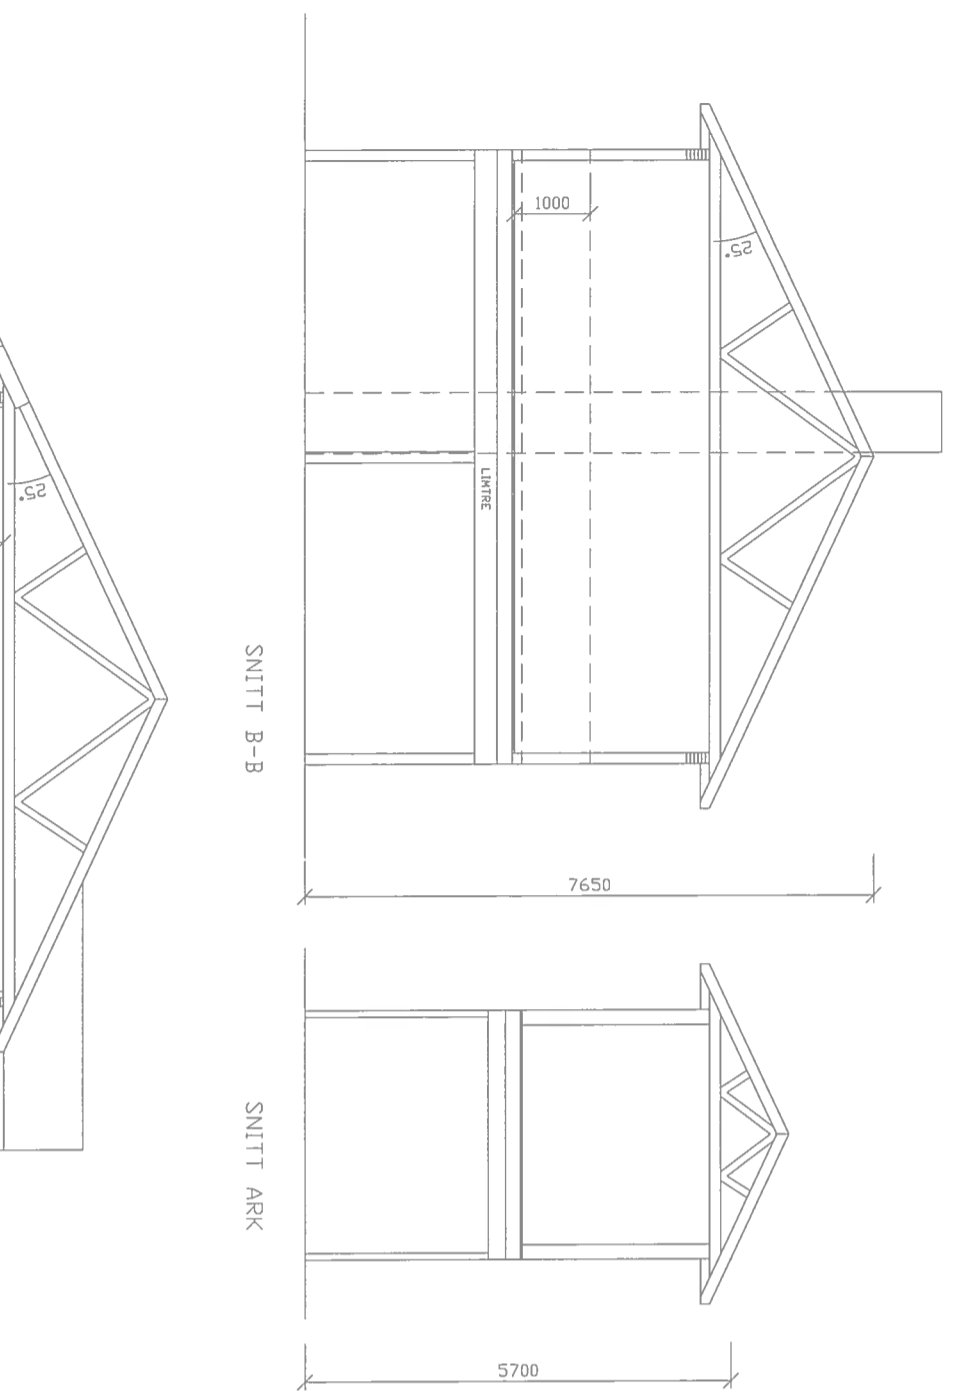

BRA	EKSIST.	TIL-/PÅBYGG	SUM BRA
LOFTSETG.	0	133,9	133,9
HØVEDETG.	107	28	135
SUM	107	161,9	268,9

BYA	EKSIST.	TIL-/PÅBYGG	SUM BYA
	121,3	48,1	169,4

Tiltakshaver:  
**NINA ASKELAND HAY**  
 Tegning:  
**PLANTEGNING 2ETG. OG SNITT**  
 Dato: 20.05.2015  
 Konstr./Tegnet: E.T  
 Målestokk: 1:100  
 Rev: 11.06.2019  
 Gnr./Bnr.: 214/126  
 Kommune: Lindås

K&S Bygg AS  
 Torvhusmyrane 2, 5913 Elkangervdg  
 Tlf 56353370, Faks 56353481

Tegn nr: 102