


VEOL. 7

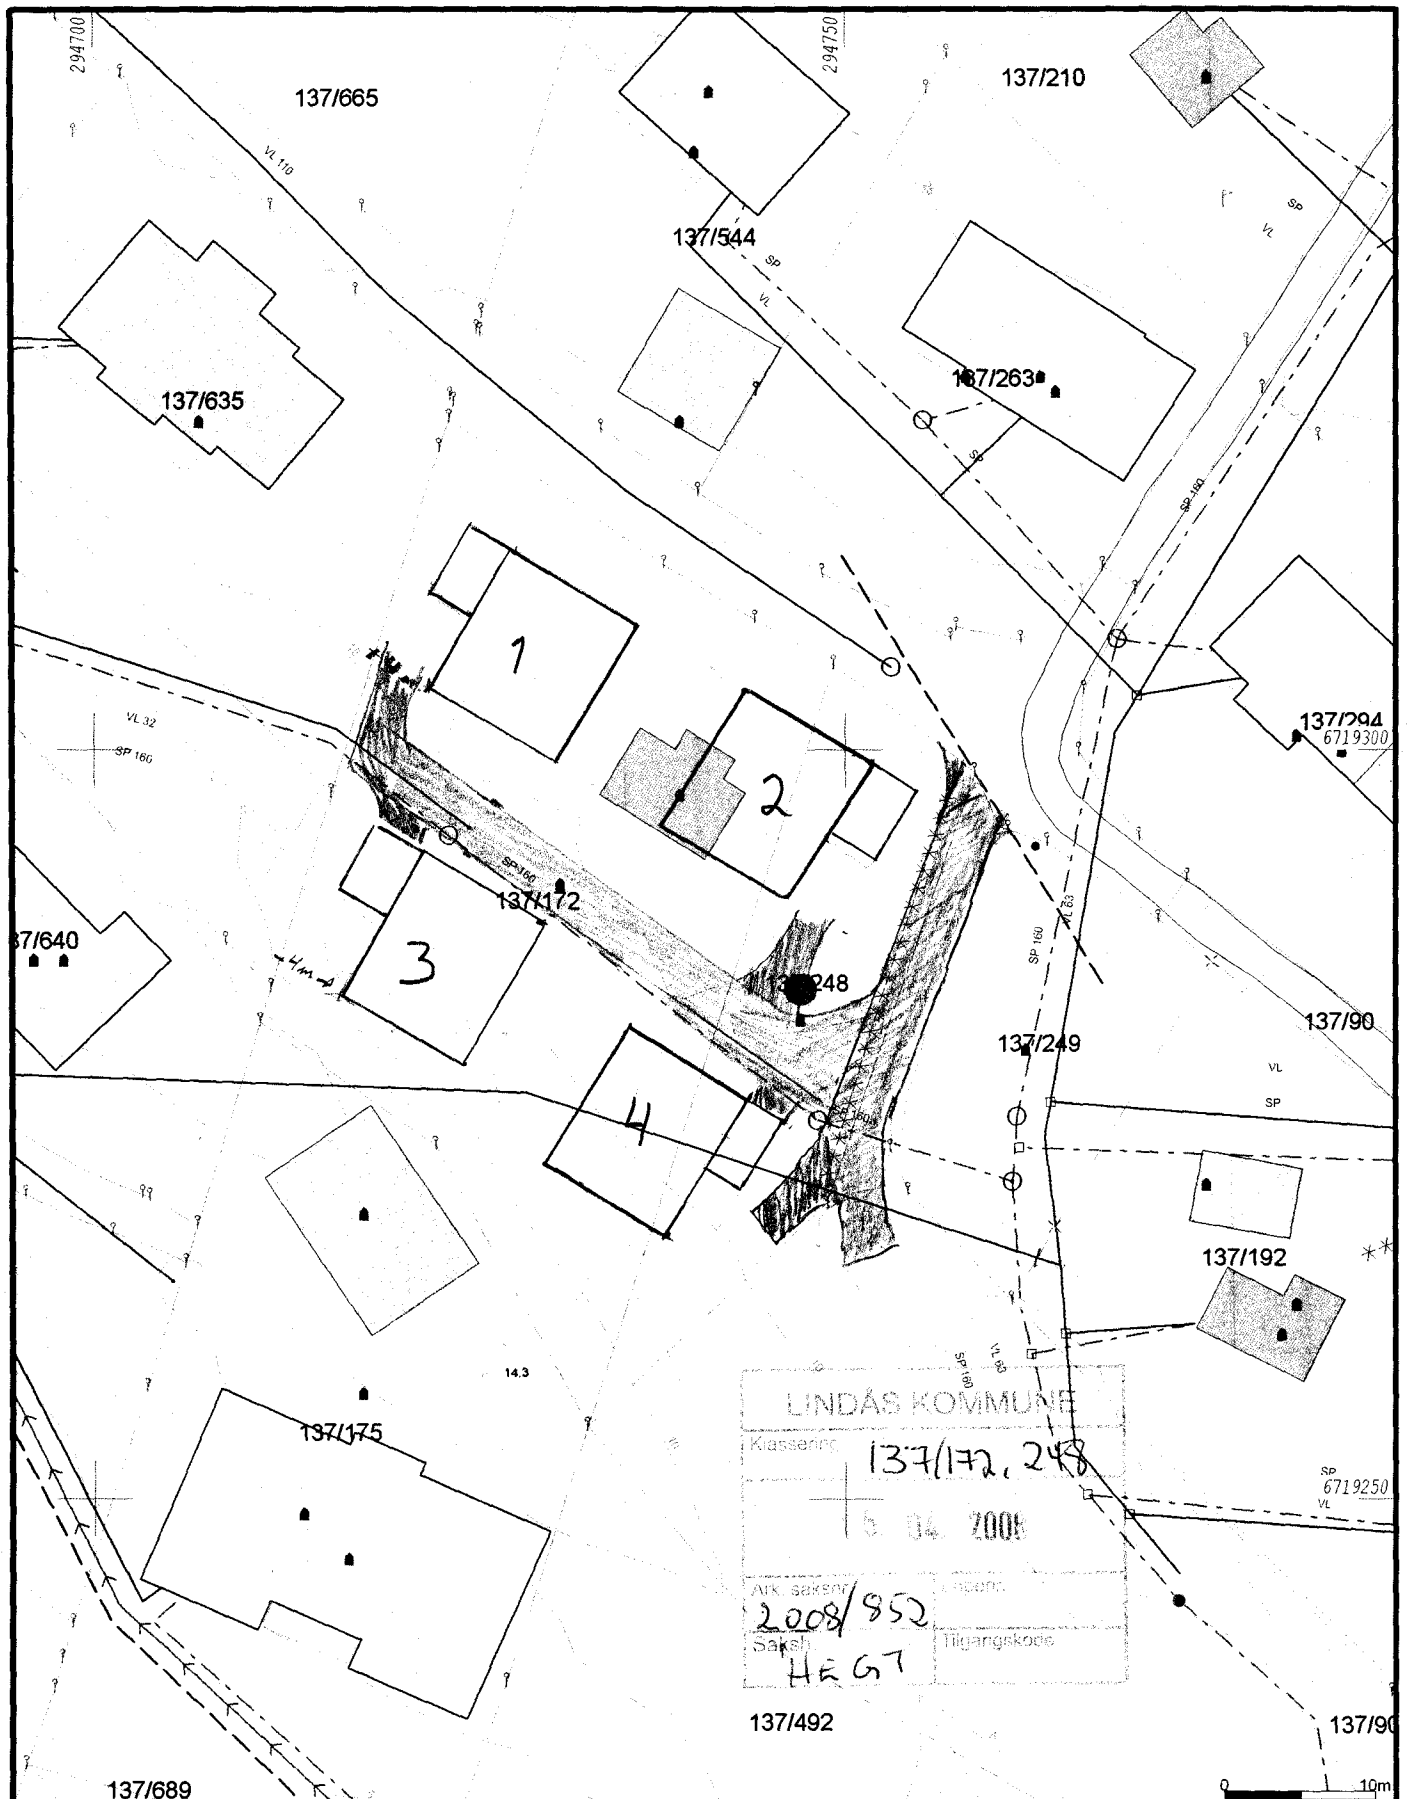

— Målte Grenser	— Vannteding	■ Hytte ferielus
— Registrerte Grenser	— Udefinert grenser	■ Garasje uthus
— Avlop felles	— Terengmålte grense	■ Industri lager
— Overvann	— Konstruert grensepunkt	■ Andre bygg
— Overvann prosjektert	□ Bolig	
→ Pumpeledning spillvann	□ Bustad m leilighet	
→ Pumpeledning vann	□ Vanningshus	
— Spillvann	□ Storre bustader	



Lindås kommune
Byggesak-avdeling



Dato: 2008.02.07

1:1000